


PLAT OF SURVEY

-OF-

LOT 2 OF CERTIFIED SURVEY MAP NO. 1631, LOCATED IN THE SOUTHWEST 1/4 OF
SECTION 34, TOWN 3 NORTH, RANGE 18 EAST, TOWN OF SPRING PRAIRIE,
WALWORTH COUNTY WISCONSIN.

KROTT SURVEYING INC.

N3705 WILLOW BEND LANE
LAKE GENEVA WI. 53147
PHONE # (262)248-3697
FAX # (262)249-0639

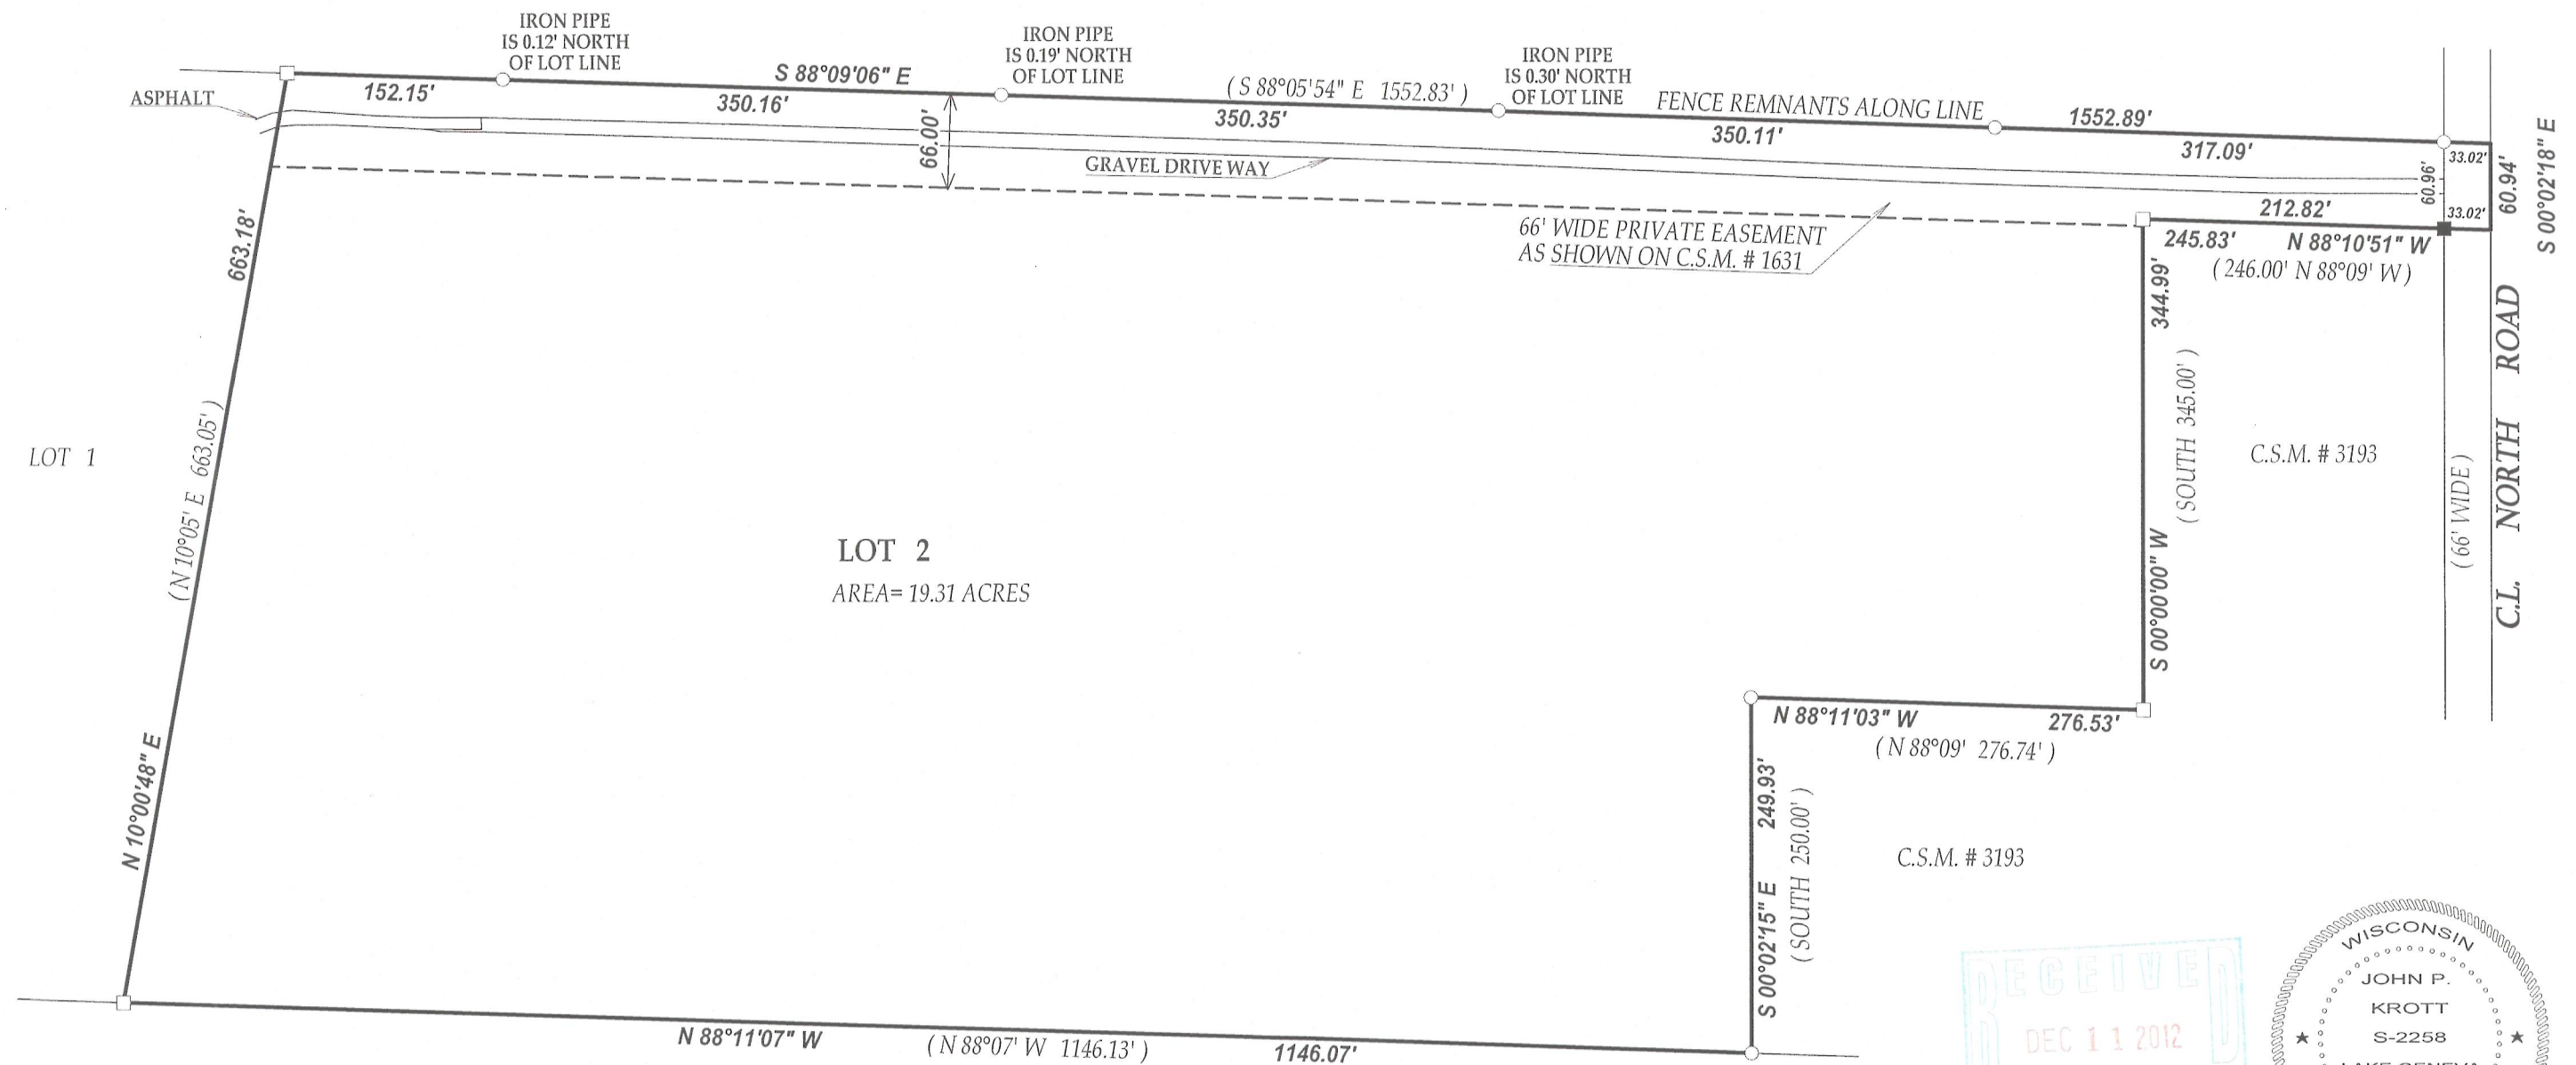

318-1135