



PLAT OF SURVEY

LOTS 1, 2, 3, & 6 OF BLOCK 15
HONEY LAKE SUBDIVISION FIRST ADDITION

LOCATED IN THE NW 1/4 OF THE SE 1/4 SECTION 13
TOWN 3 NORTH, RANGE 18 EAST
WALWORTH COUNTY, WISCONSIN

Lots 1, 2, 3, and 6, in Block 15, Honey Lake Subdivision, First Addition, according to the recorded plat thereof. Said land being in the Town of Spring Prairie, Walworth County, Wisconsin.

Parcel No.:
OHL1 00113A
OHL1 00115

CRESCENT PLACE (40' WIDE)

FOUND REBAR STAKE
0.50' NORTH &
0.85' EAST OF
RECORD POSITION FOR
CONCRETE MONUMENT AT CORNER
(FOUND IN 1999 DURING SURVEY OF LOTS 4 & 5)

LOT 1

LOT 3

LOT 4

LOT 5

LOT 6

CRESCENT PLACE (40' WIDE)

COUNTY TRUNK HIGHWAY "DD" (83' WIDE)

ASSIGNED EAST LINE C.T.H. "DD"
N 33°34'48" E

MAP SCALE IN FEET ORIGINAL 1" = 20'



- LEGEND
- = FOUND IRON PIPE STAKE
 - = FOUND IRON REBAR STAKE
 - ▣ = FOUND CONCRETE MONUMENT
 - ⦿ = SET IRON REBAR STAKE
 - (xxx) = RECORDED AS

NOTE: COPIES OF THIS MAP TO WHICH THE FOLLOWING CERTIFICATE WILL APPLY SHOW THE SURVEYOR'S ORIGINAL SEAL AND SIGNATURE IN RED INK. COPIES BY ANY OTHER MEANS MAY HAVE ALTERATIONS WHICH DO NOT REPRESENT THE SURVEYOR'S WORK PRODUCT.

I HEREBY CERTIFY THAT THE ABOVE DESCRIBED PROPERTY HAS BEEN SURVEYED UNDER MY DIRECTION AND THAT THE ABOVE MAP IS A TRUE REPRESENTATION THEREOF AND SHOWS THE SIZE AND LOCATION OF THE PROPERTY, ITS EXTERIOR BOUNDARIES, THE LOCATION OF ALL VISIBLE STRUCTURES, APPARENT EASEMENTS, ROADWAYS, AND BUILDINGS THEREON, BOUNDARY FENCES, AND DIMENSIONS OF ALL PRINCIPLE VISIBLE ENCROACHMENTS, IF ANY. THIS SURVEY IS MADE FOR THE USE OF THE PRESENT OWNERS OF THE PROPERTY, AND ALSO THOSE WHO PURCHASE, MORTGAGE, OR GUARANTEE THE TITLE THERETO WITHIN ONE YEAR FROM THE DATE HEREOF.

DATED: NOVEMBER 26, 2014

PETER S. GORDON

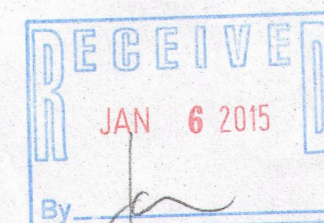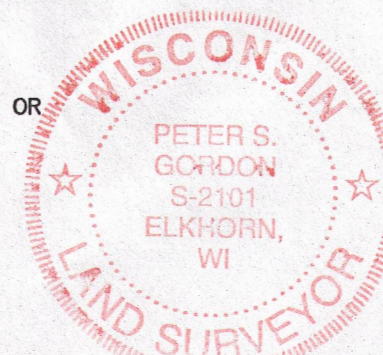

WORK ORDERED BY:
KEEFE REAL ESTATE
751 GENEVA PARKWAY N.
LAKE GENEVA, WI. 53147

FARRIS, HANSEN & ASSOCIATES, INC.
ENGINEERING - ARCHITECTURE - SURVEYING
7 RIDGWAY COURT P.O. BOX 437
ELKHORN, WISCONSIN 53121
OFFICE: (262) 723-2098 FAX: (262) 723-5886

REVISIONS

PROJECT NO.
9193
DATE:
11-24-2014
SHEET NO.
1 OF 1

OHL1 - 113A
OHL1 - 115

318-1167