

PLAT OF SURVEY
-OF-

LOTS 1-4 IN BLOCK 5, HONEY LAKE SUBDIVISION
ACCORDING TO THE RECORDED PLAT THEREOF. SAID
LAND BEING IN THE TOWN OF SPRING PRAIRIE,
WALWORTH COUNTY, WISCONSIN.


SURVEY FOR: CRYSTAL COWAN

SURVEY LOCATION: W113 VIEW CREST AVENUE

LEGEND

- ⊙ FOUND CONCRETE MONUMENT
- FOUND IRON PIPE
- FOUND SPIKE
- ⌵ SET IRON PIPE

GRAPHIC SCALE

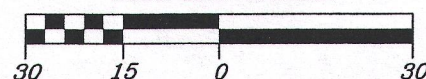


SCALE: 1" = 30'

NOTE: BEARINGS HEREON RELATE TO THE SOUTH
LINE OF VIEW CREST AVENUE, ASSUMED BEARING
SOUTH 89°48' EAST.

"I hereby certify that I have surveyed the above described
property and that the above map is a correct representation thereof
and shows the size and location of the property, its exterior
boundaries, the location of all visible structures and dimensions
of all principal buildings thereon, boundary fences, apparent
easements, roadways and encroachments, if any."

"This survey is made for the use of the present owners of the
property, and those who purchase, mortgage, or guarantee the
title thereto within one year from date hereof."



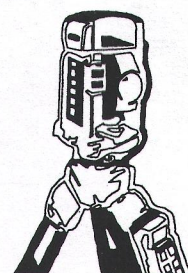


B.W. SURVEYING, INC.

LAND SURVEYS
MAPPING AND PLANNING
412 N. PINE STREET
BURLINGTON, WI 53105
(262)-767-0225

LAKE SHORE DRIVE

VIEW CREST AVENUE

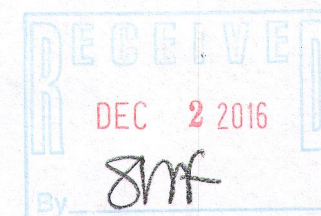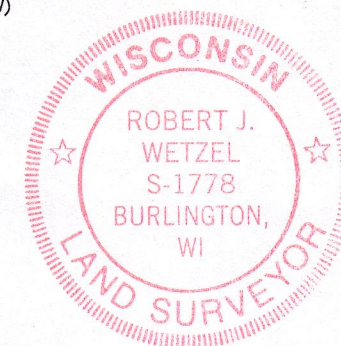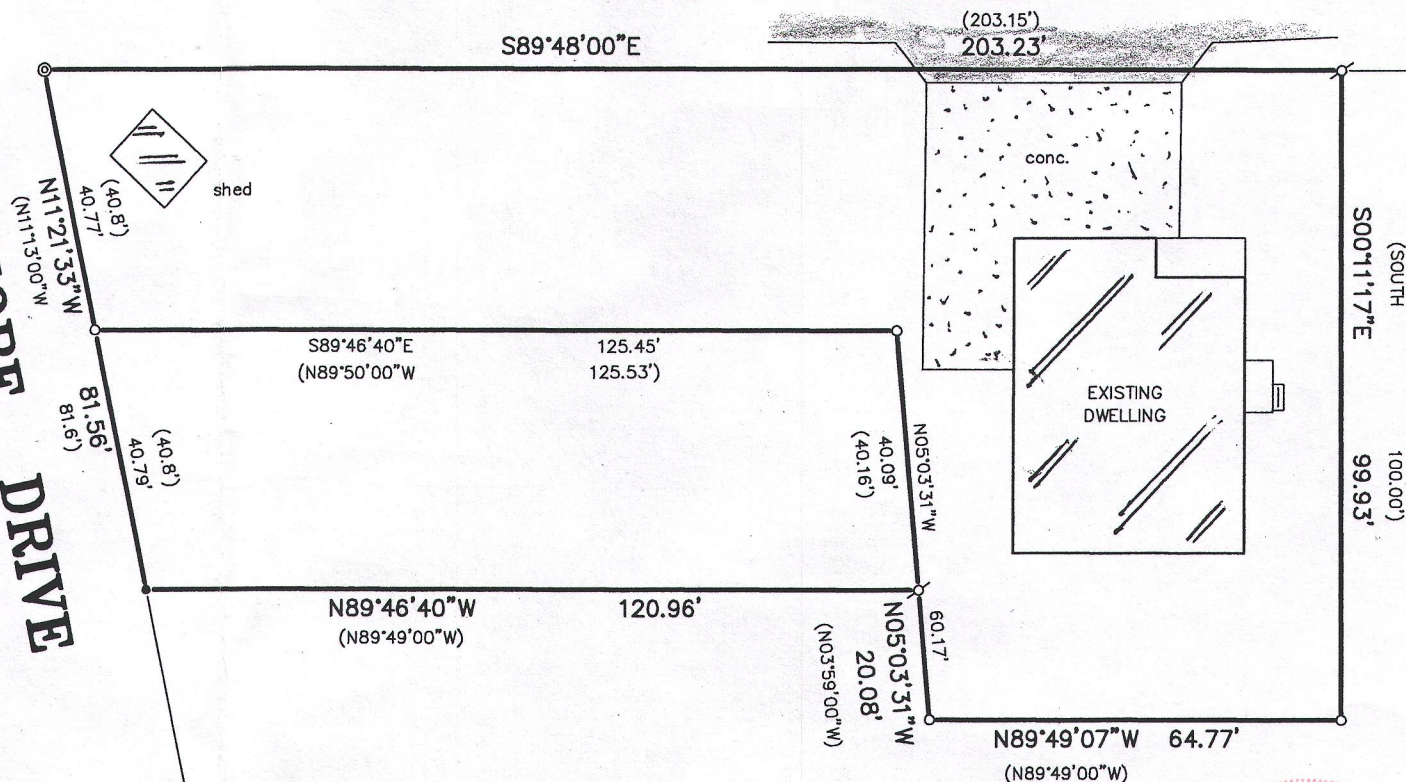

THIS IS NOT AN ORIGINAL PRINT
UNLESS THIS SEAL IS RED.

Robert J. Wetzel
ROBERT J. WETZEL S-1778

AUGUST 22, 2016
DATE

9204
JOB NUMBER

OHL-216

318-1219