



PLAT OF SURVEY  
-AND-  
PROPOSED LEGAL DESCRIPTION

PART OF BLACKSTONE DRIVE LYING BETWEEN BLOCKS 23 AND 24, HONEY LAKE SUBDIVISION FIRST ADDITION, ACCORDING TO THE RECORDED PLAT THEREOF, AND BEING MORE PARTICULARLY DESCRIBED AS FOLLOWS: COMMENCE AT THE MOST NORTHERLY CORNER OF SAID BLOCK 23; THENCE NORTH 33°52' EAST ALONG THE SOUTHEASTERLY LINE OF HILLCREST TERRACE 40.00 FEET TO A POINT ON THE SOUTHERLY LINE OF SAID BLOCK 24; THENCE SOUTH 55°06'08" EAST ALONG SAID SOUTHERLY LINE, 179.37 FEET (RECORDED AS SOUTH 55°10' EAST 180.00') TO A POINT ON THE WESTERLY LINE OF KENMORE AVENUE; THENCE SOUTH 34°01'03" WEST (RECORDED AS SOUTH 33°52' WEST) ALONG SAID WESTERLY LINE 40.00 FEET TO A POINT ON THE NORTHERLY LINE OF SAID BLOCK 23; THENCE NORTH 55°06'06" WEST ALONG SAID NORTHERLY LINE 179.26 FEET (RECORDED AS NORTH 55°10' WEST 180.00 FEET) TO THE PLACE OF BEGINNING. SAID LAND BEING IN THE TOWN OF SPRING PRAIRIE, WALWORTH COUNTY, WISCONSIN.

SURVEY FOR: RAYMOND AND KATHERINE LOHMEYER  
SURVEY LOCATION: N6276 HILLCREST TERRACE

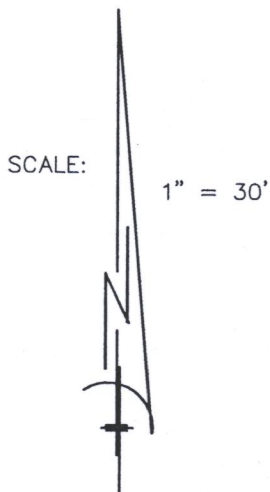

- LEGEND**
- FOUND IRON PIPE
  - ⊕ FOUND CONCRETE MONUMENT
  - SET IRON PIPE

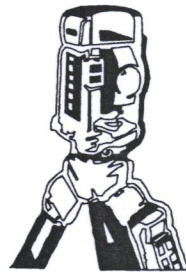

**B.W. SURVEYING, INC.**

LAND SURVEYS  
MAPPING AND PLANNING  
412 N. PINE STREET  
BURLINGTON, WI 53105  
(262)-767-0225

