

**ROBERS & BOYD, INC.**  
CONSULTING ENGINEERS & LAND SURVEYORS

PHONE (414) 763-2652



116 E. CHESTNUT ST.

BURLINGTON, WIS. 53105

**PLAT OF SURVEY & BUILDING LOCATION**


OF

LOTS 3, 4, 5, 6 & 7, BLOCK 20 HONEY LAKE SUBDIVISION, EXCEPTING  
THE SOUTHEASTERLY 17.0 FT OF LOTS 6 & 7, B1K20 FOR HIGHWAY  
PURPOSES. SAID SUBDIVISION LOCATED IN THE SE 1/4 OF SECTION 13,  
T3N., R18E., TOWN OF SPRING PRAIRIE, WALWORTH COUNTY, WISCONSIN

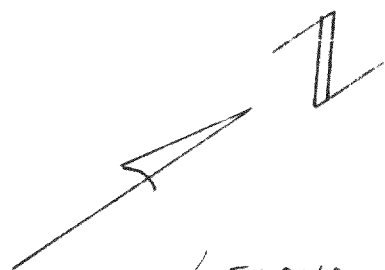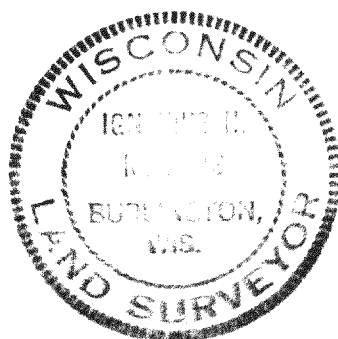

**LEGEND**

- X P.K. NAIL SET
  - FOUND IRON PIPE
  - SET IRON PIPE
- SCALE 1" = 40'

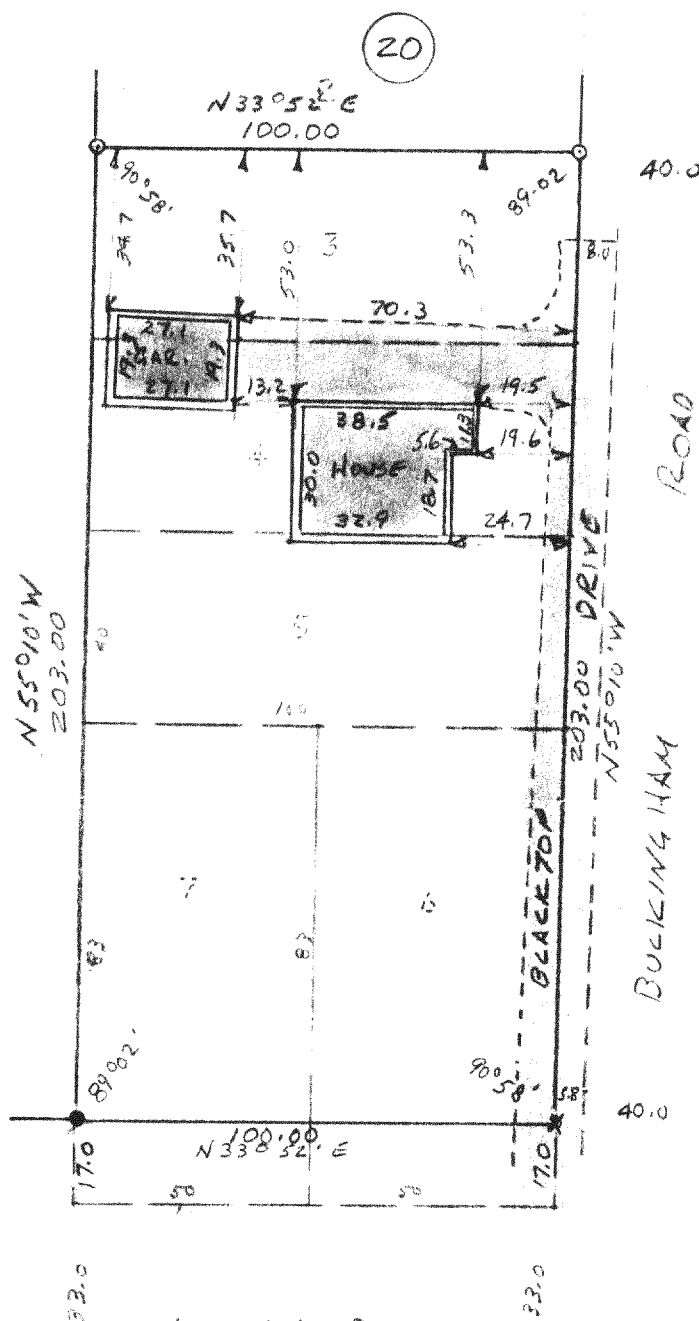

I HEREBY CERTIFY THAT WE HAVE SURVEYED THE LANDS DESCRIBED  
ABOVE ACCORDING TO OFFICIAL RECORDS AND THAT THE PLAT  
DRAWN HEREON IS A CORRECT REPRESENTATION OF SAID SURVEY.

*Ignatius H. Rober*  
WIS. REG. LAND SURVEYOR 5787

DATE 1-27-75

JOB NO. 75012