


PLAT OF SURVEY & HOUSE LOCATION
for
BANCO MORTGAGE CO.

The East 1/2 of Lot 5, Lots 6 & 7 of Block 29, First Addition to Honey Lake Subdivision, Located in part of the SE 1/4 of Section 13, T 3 N., R 18 E., Town of Spring Prairie, County of Walworth, State of Wisconsin.

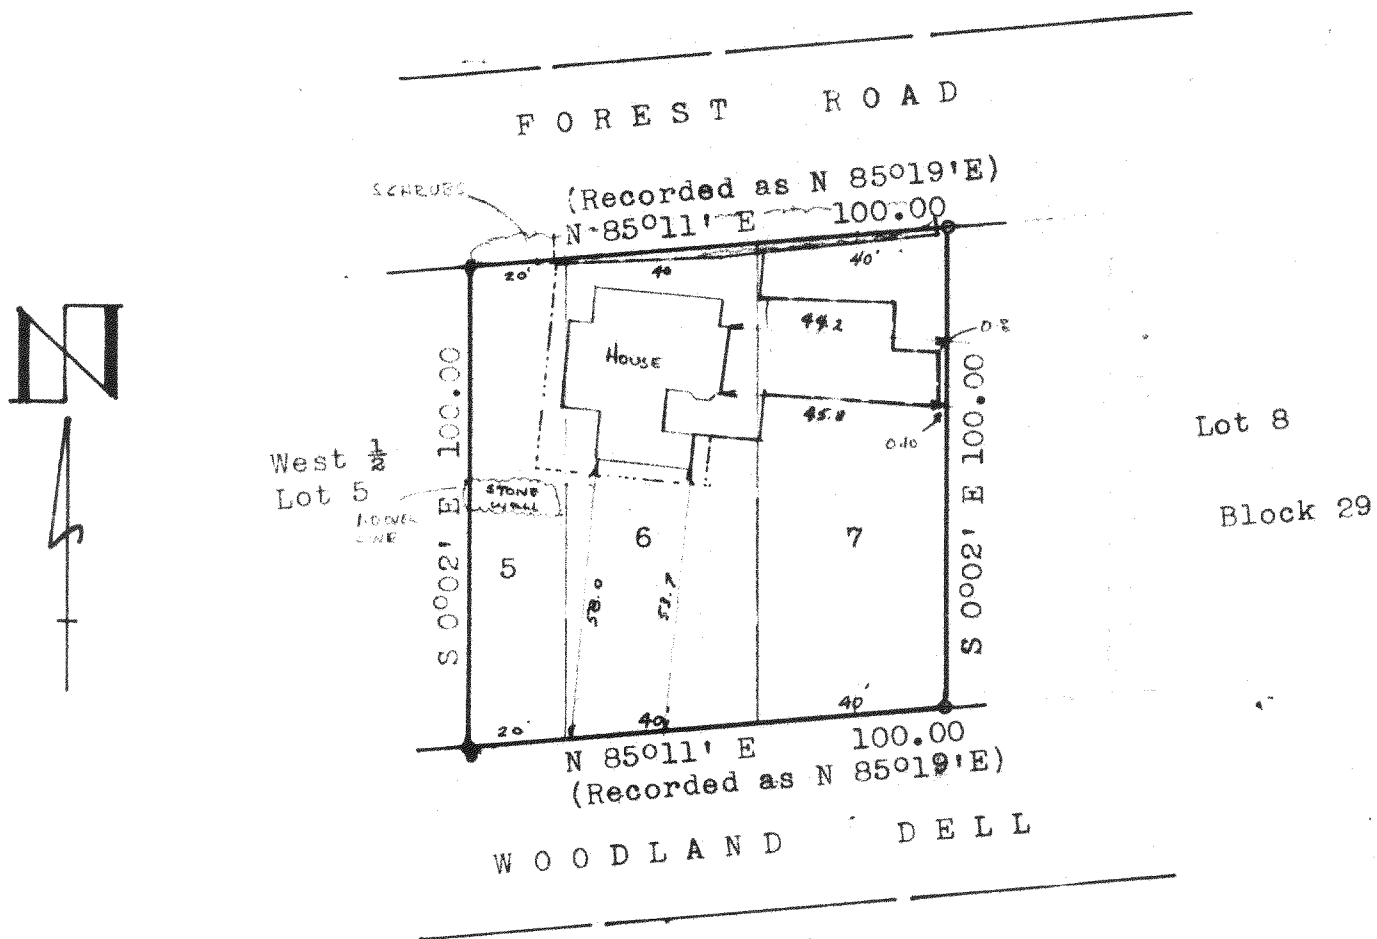

* L E G E N D *

- Found Iron Pipe
○ Set 1" Iron Pipe
--- EDGE OF CONC. WALK --- RETAINING WALL
Scale 1"= 40'
DATE Aug. 31, 1978
JOB NO. 78217

"I have surveyed the above-described property, and the above map is a true representation thereof and shows the size and location of the property, its former boundaries, the street and other rights of egress, the situation of the same, and adjacent lots, and all other matters affecting the same."

There are good reasons for using each one of the great theories of the world of people. There are who purchase, who play, who grow, who feel, who wait, who

Dated at Bombay this 25th day
 of August 1978.

