


THE EAST LINE ONLY OF WALWORTH COUNTY
CERTIFIED SURVEY MAP NO. 409, LOT 1.
LANDS LOCATED IN SOUTHEAST 1/4 OF SECTION
15 T. 3 N., R. 18 E. OF THE 4TH P.M.,
TOWNSHIP OF SPRING PRAIRIE, COUNTY OF
WALWORTH, STATE OF WISCONSIN.

BEARINGS ARE THOSE OF CSM PLAT.

A circular seal with a dotted border. The text "WISCONSIN" is at the top and "LAND SURVEYOR" is at the bottom, both following the curve of the border. In the center, the text "JOHN F. DEGEN" is on the top line, "BURLINGTON," is on the second line, and "WIS." is on the third line. Two five-pointed stars are positioned on the left and right sides of the central text.

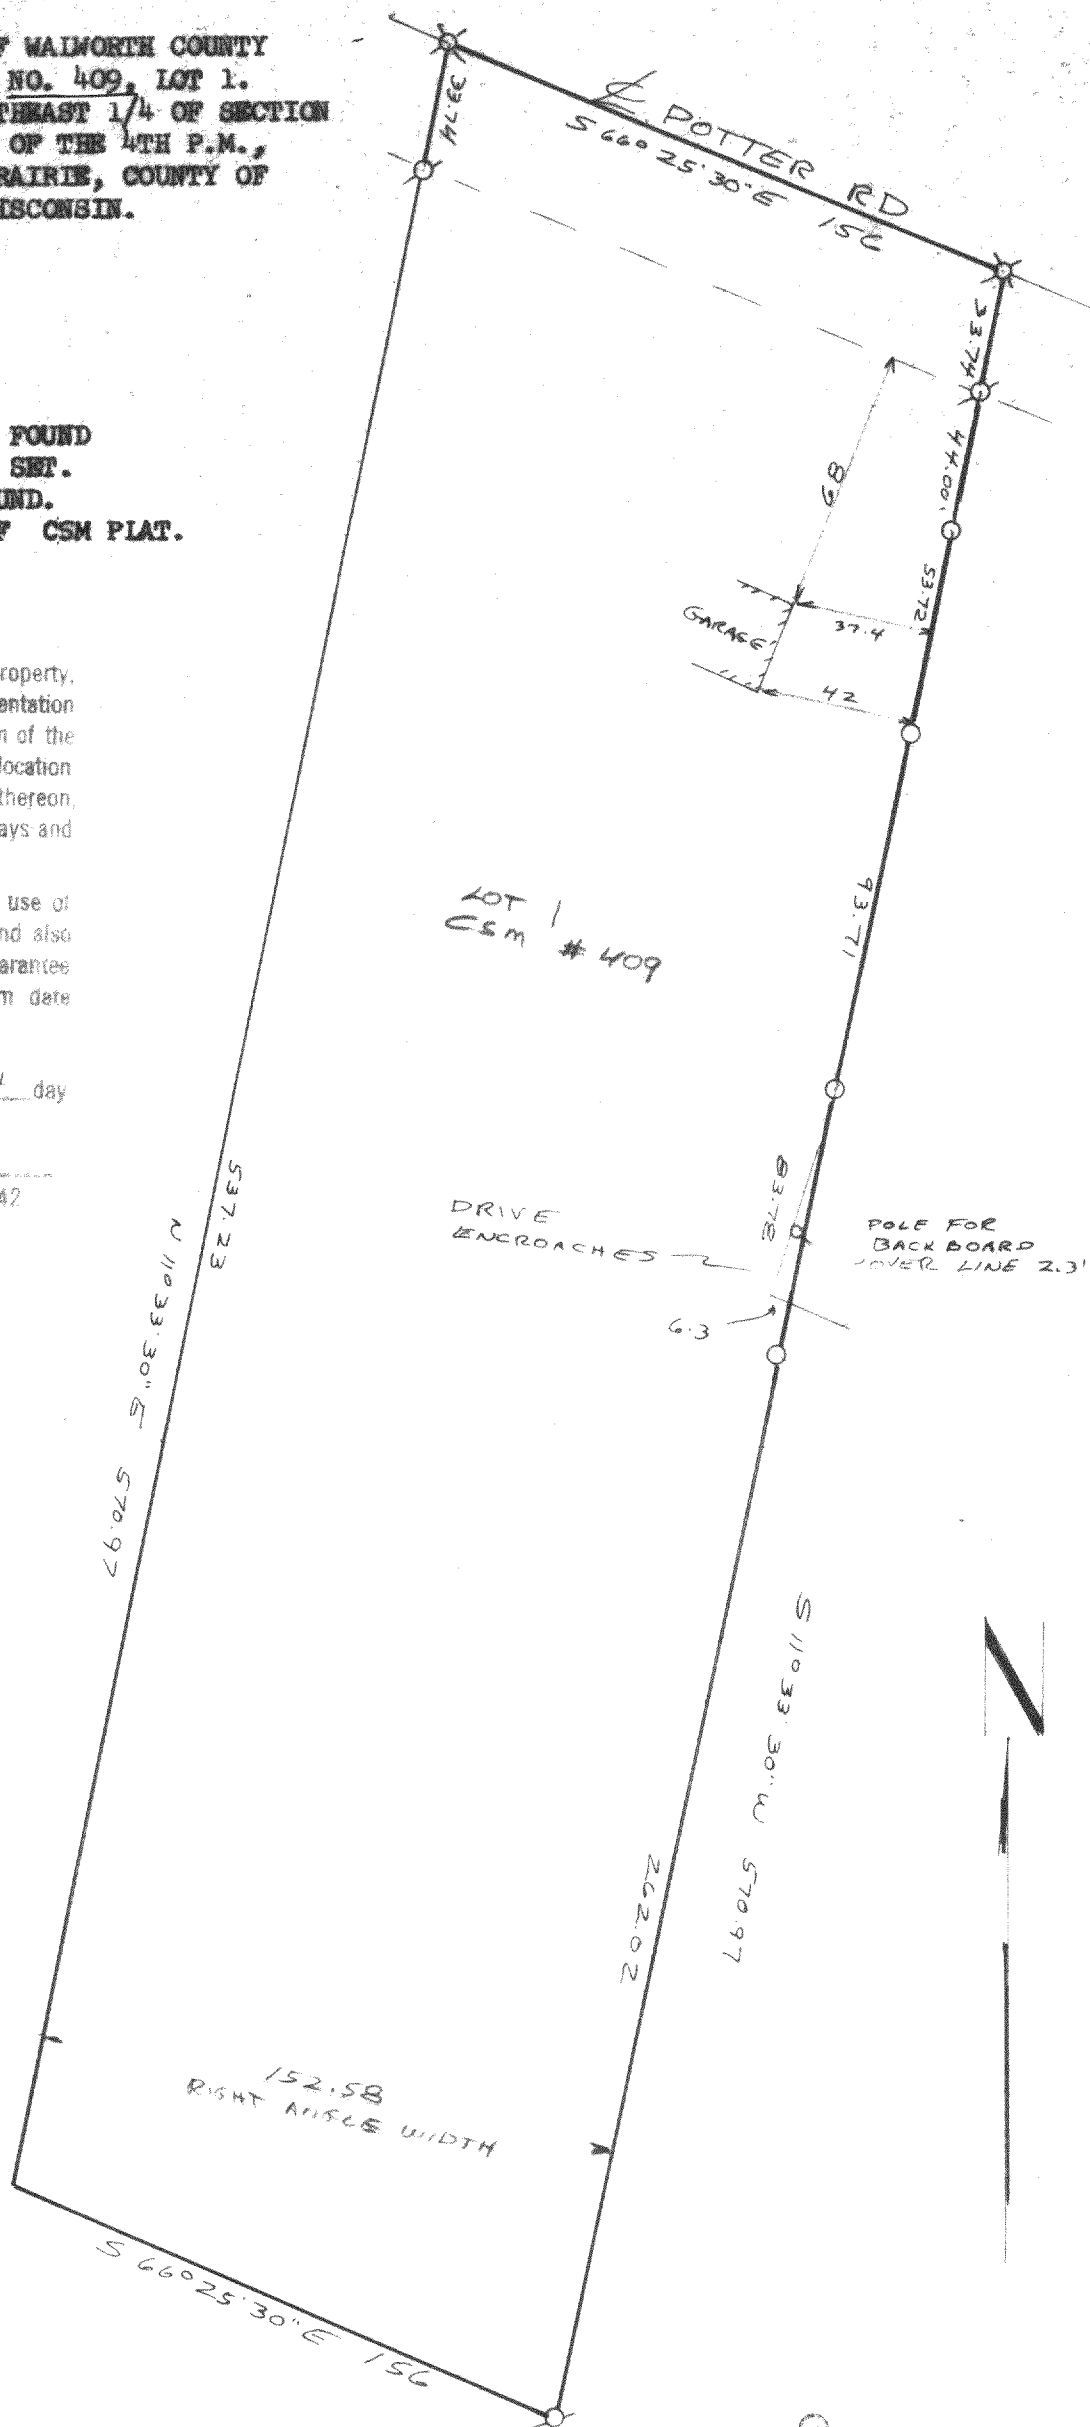

6-11-19

Σ Line OA409-1

318-242