


PLAT OF SURVEY
FOR
PEOPLE'S MORTGAGE CORPORATION
OF

Lots Six (6) and Seven (7), Block Two (2), Honey Lake Subdivision, being a part of Sections Thirteen (13) and Twenty-four (24), Township Three (3) North, Range Eighteen (18) East, in the Town of Spring Prairie, Walworth County, Wisconsin.

BUYER: Robin J. and Sherry A. Gale
1480 Lake Shore Drive

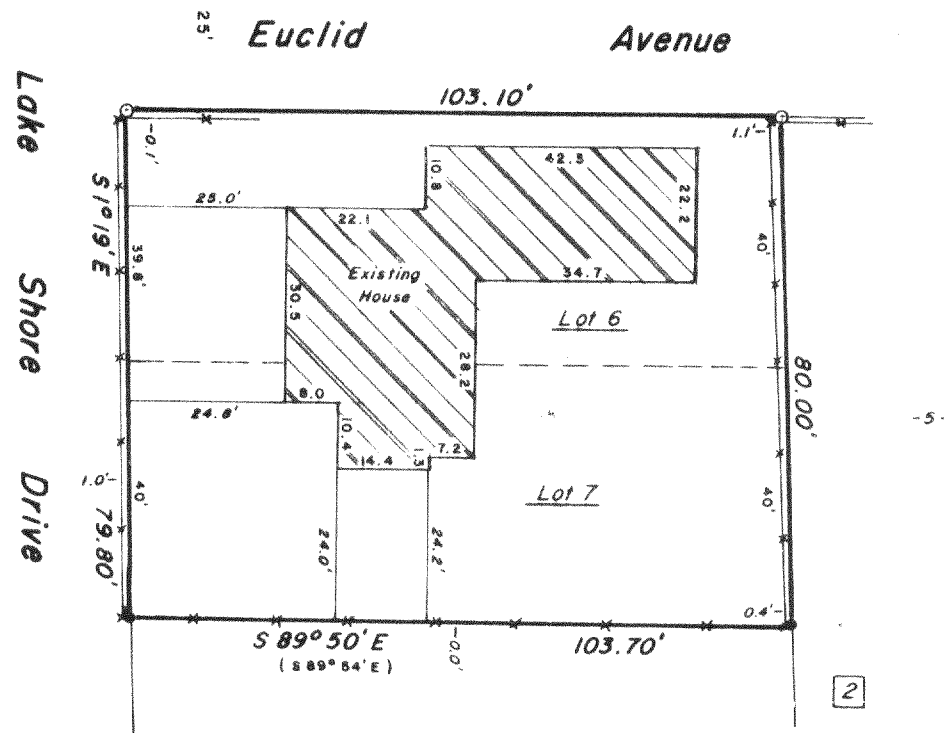

"I hereby certify that I have surveyed the above described property and that the above map is a true representation thereof and shows the size and location of the property, its exterior boundaries, the location of all visible structures and dimensions of all principal buildings thereon, boundary fences, apparent easements, roadways and visible encroachments, if any.

"This survey is made for the use of the present owners of the property, and also those who purchase, mortgage, or guarantee the title thereto within one year from date hereof."

NO MONUMENTATION HAS BEEN WAIVED IN ACCORDANCE
WITH A-E 5.01(b) OF THE WISCONSIN ADMINISTRATIVE
CODE



LEGEND

- + CHISEL CUT IN CONCRETE
o PK NAIL
● FOUND IRON PIPE - 1"
/ FOUND IRON PIPE -
○ SET IRON PIPE - 1"
● FOUND BRASS CAPPED MONUMENT
⊕ FOUND CONCRETE MONUMENT
—+— FENCE
() RECORDED AS
/ EXISTING GROUND ELEVATION

EXISTING GROUND ELEVATION

SCALE - 1" = 30'

Kenne R. Reenan
WISCONSIN REGISTERED LAND SURVEYOR

7/30/84

DATE _____

FIELD WORK BY KRR, GJA

DRAWN BY KRR

84184

JOB NUMBER

KRE 07L-4B

318-247 v