


PLAT OF SURVEY

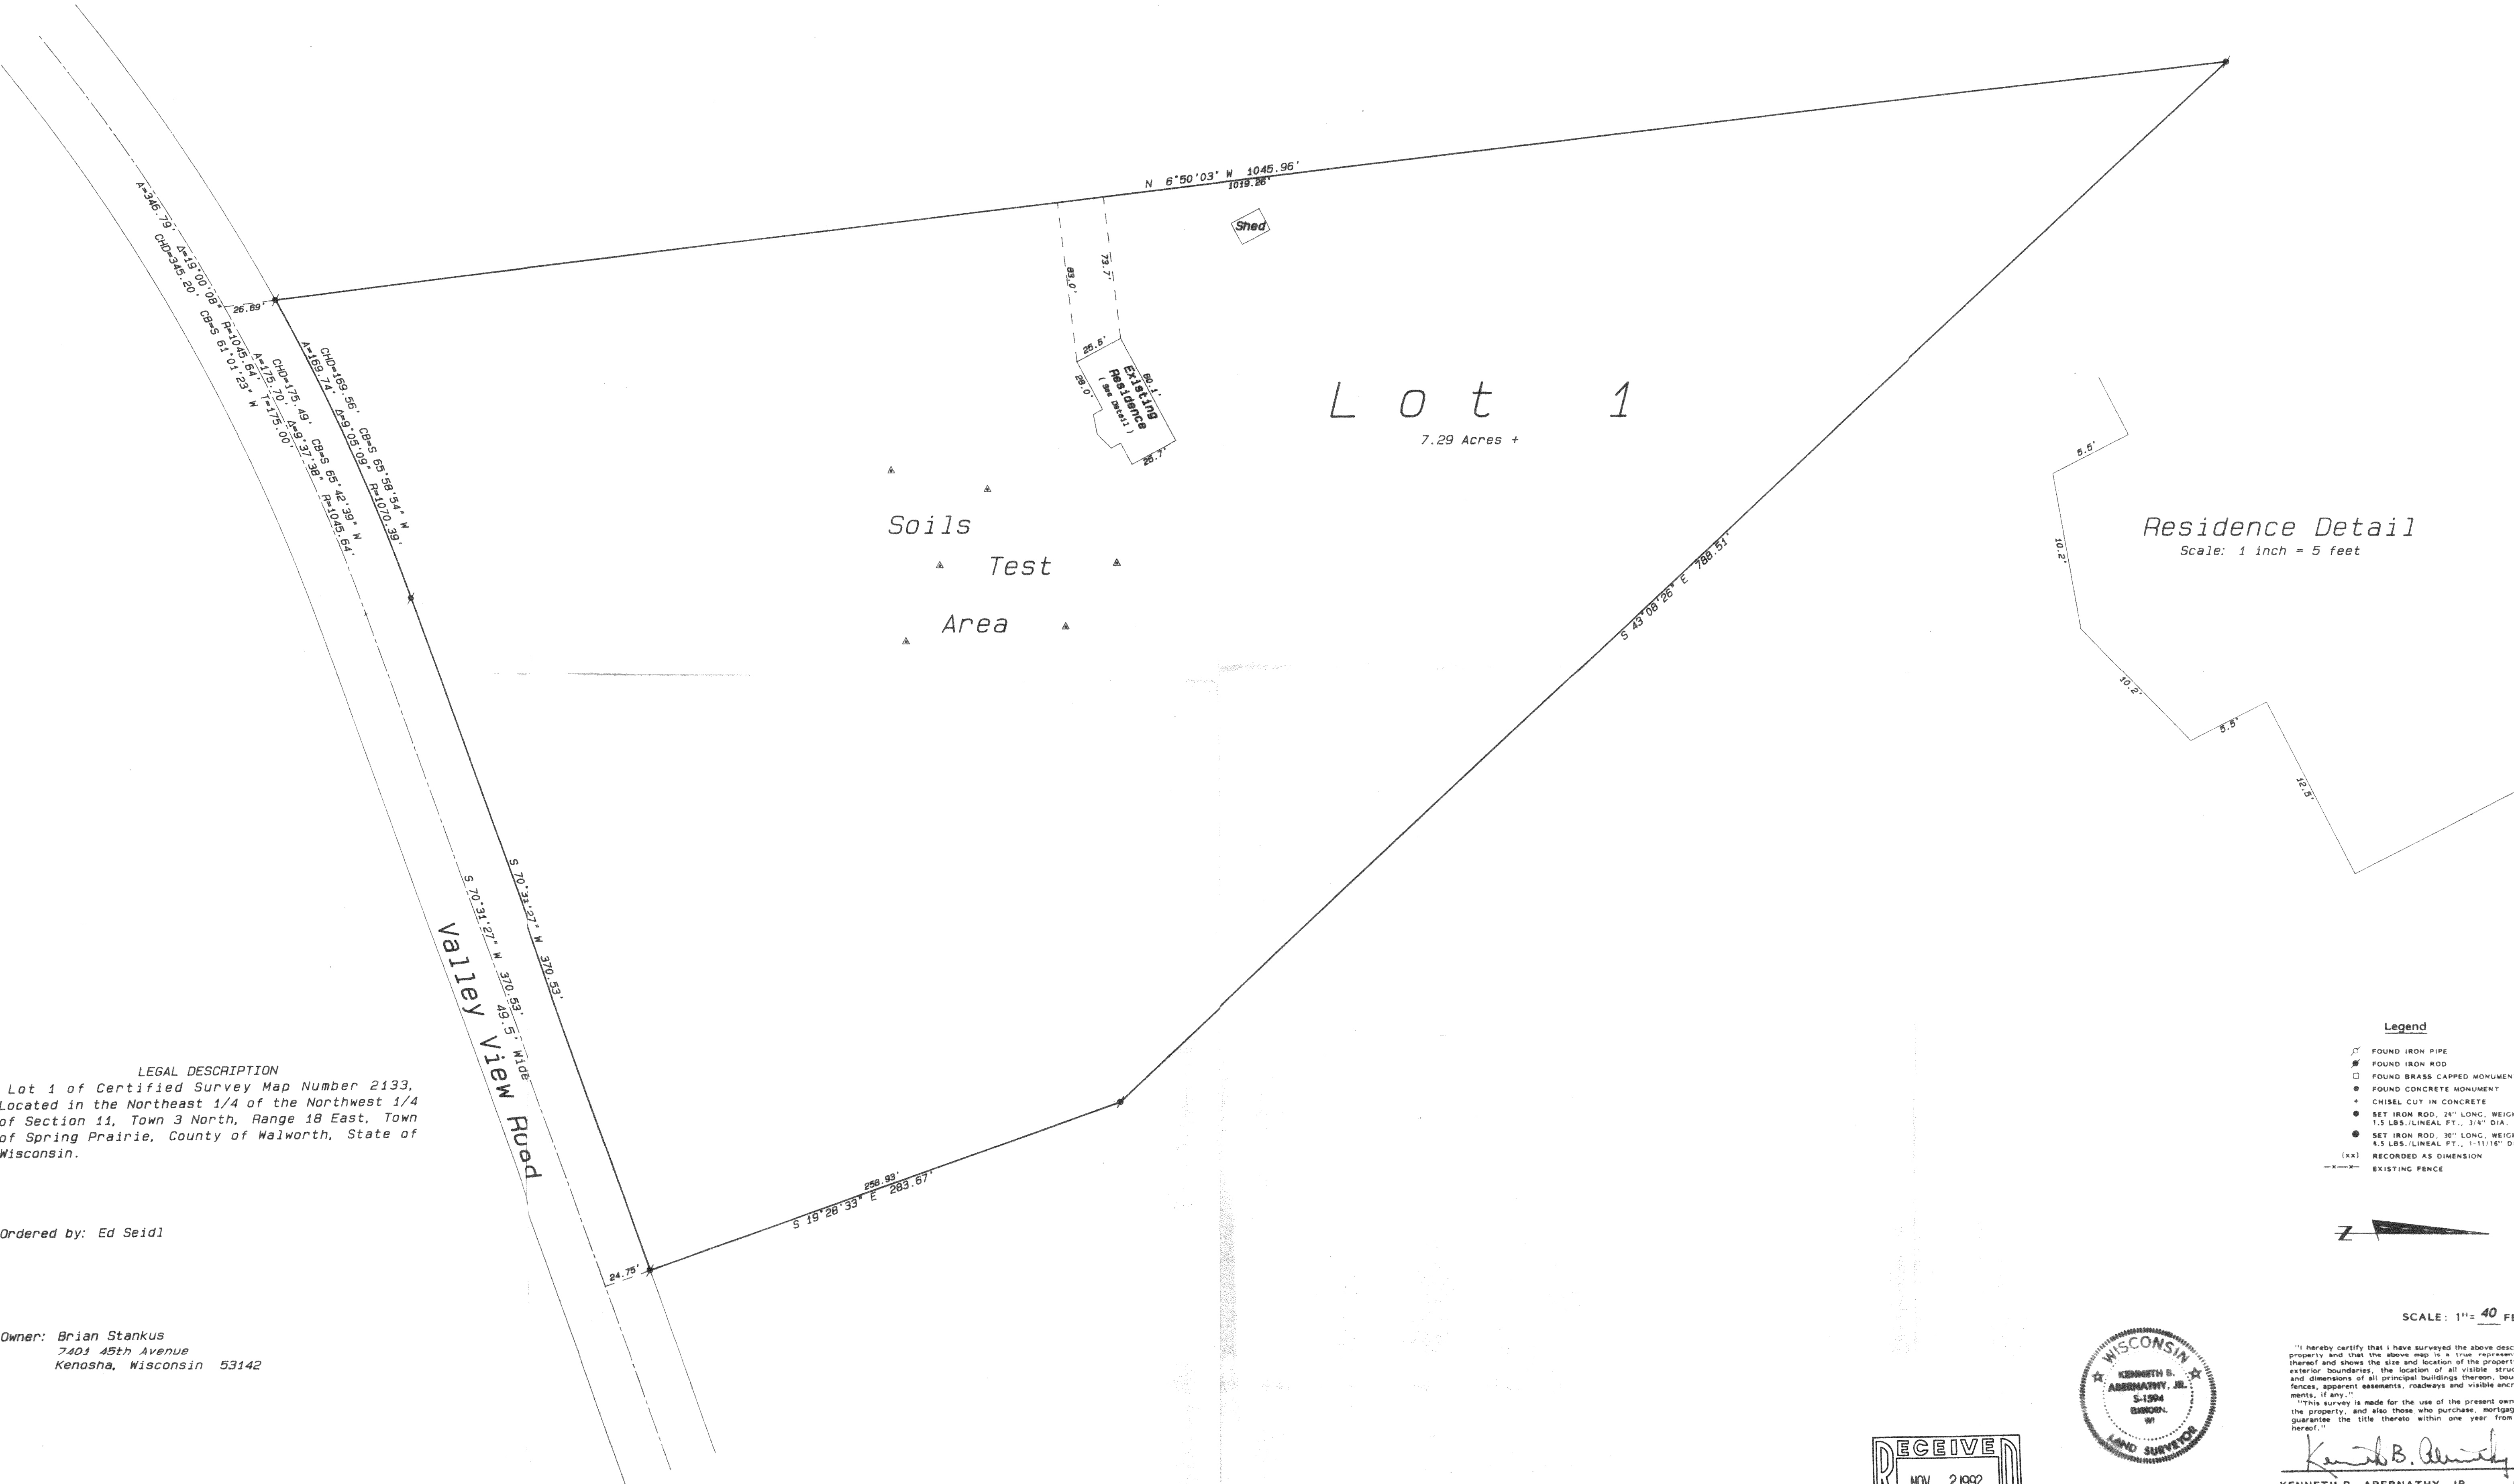

LEGAL DESCRIPTION
Lot 1 of Certified Survey Map Number 2133,
Located in the Northeast 1/4 of the Northwest 1/4
of Section 11, Town 3 North, Range 18 East, Town
of Spring Prairie, County of Walworth, State of
Wisconsin.



Ordered by: Ed Seidl

Owner: Brian Stankus
7401 45th Avenue
Kenosha, Wisconsin 53142

- Legend
- FOUND IRON PIPE
 - FOUND IRON ROD
 - FOUND BRASS CAPPED MONUMENT
 - FOUND CONCRETE MONUMENT
 - CHISEL CUT IN CONCRETE
 - SET IRON ROD, 24" LONG, WEIGHING 1.5 LBS./LINEAL FT., 3/4" DIA.
 - SET IRON ROD, 36" LONG, WEIGHING 4.5 LBS./LINEAL FT., 1-11/16" DIA.
 - RECORDED AS DIMENSION
 - EXISTING FENCE



SCALE: 1"= 40 FEET

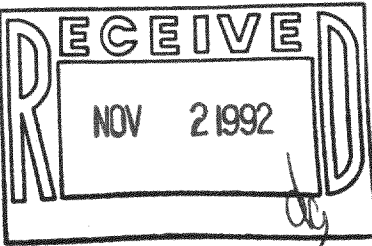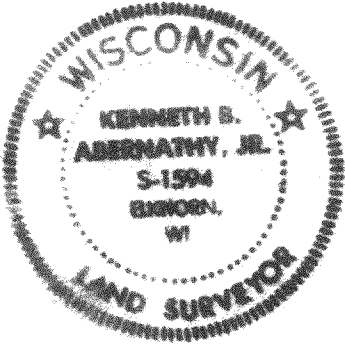


"I hereby certify that I have surveyed the above described property and that the above map is a true representation thereof and shows the size and location of the property, its exterior boundaries, the location of all visible structures and dimensions of all principal buildings thereon, boundary fences, apparent easements, roadways and visible encroachments, if any."

"This survey is made for the use of the present owners of the property, and also those who purchase, mortgage, or guarantee the title thereto within one year from the date hereof."

Kenneth B. Abernathy, Jr.

KENNETH B. ABERNATHY, JR.
WISCONSIN REGISTERED LAND SURVEYOR,
Revised September 28, 1992 S-1594
May 18, 1992 Job No. 1892,808

PLAT OF SURVEY

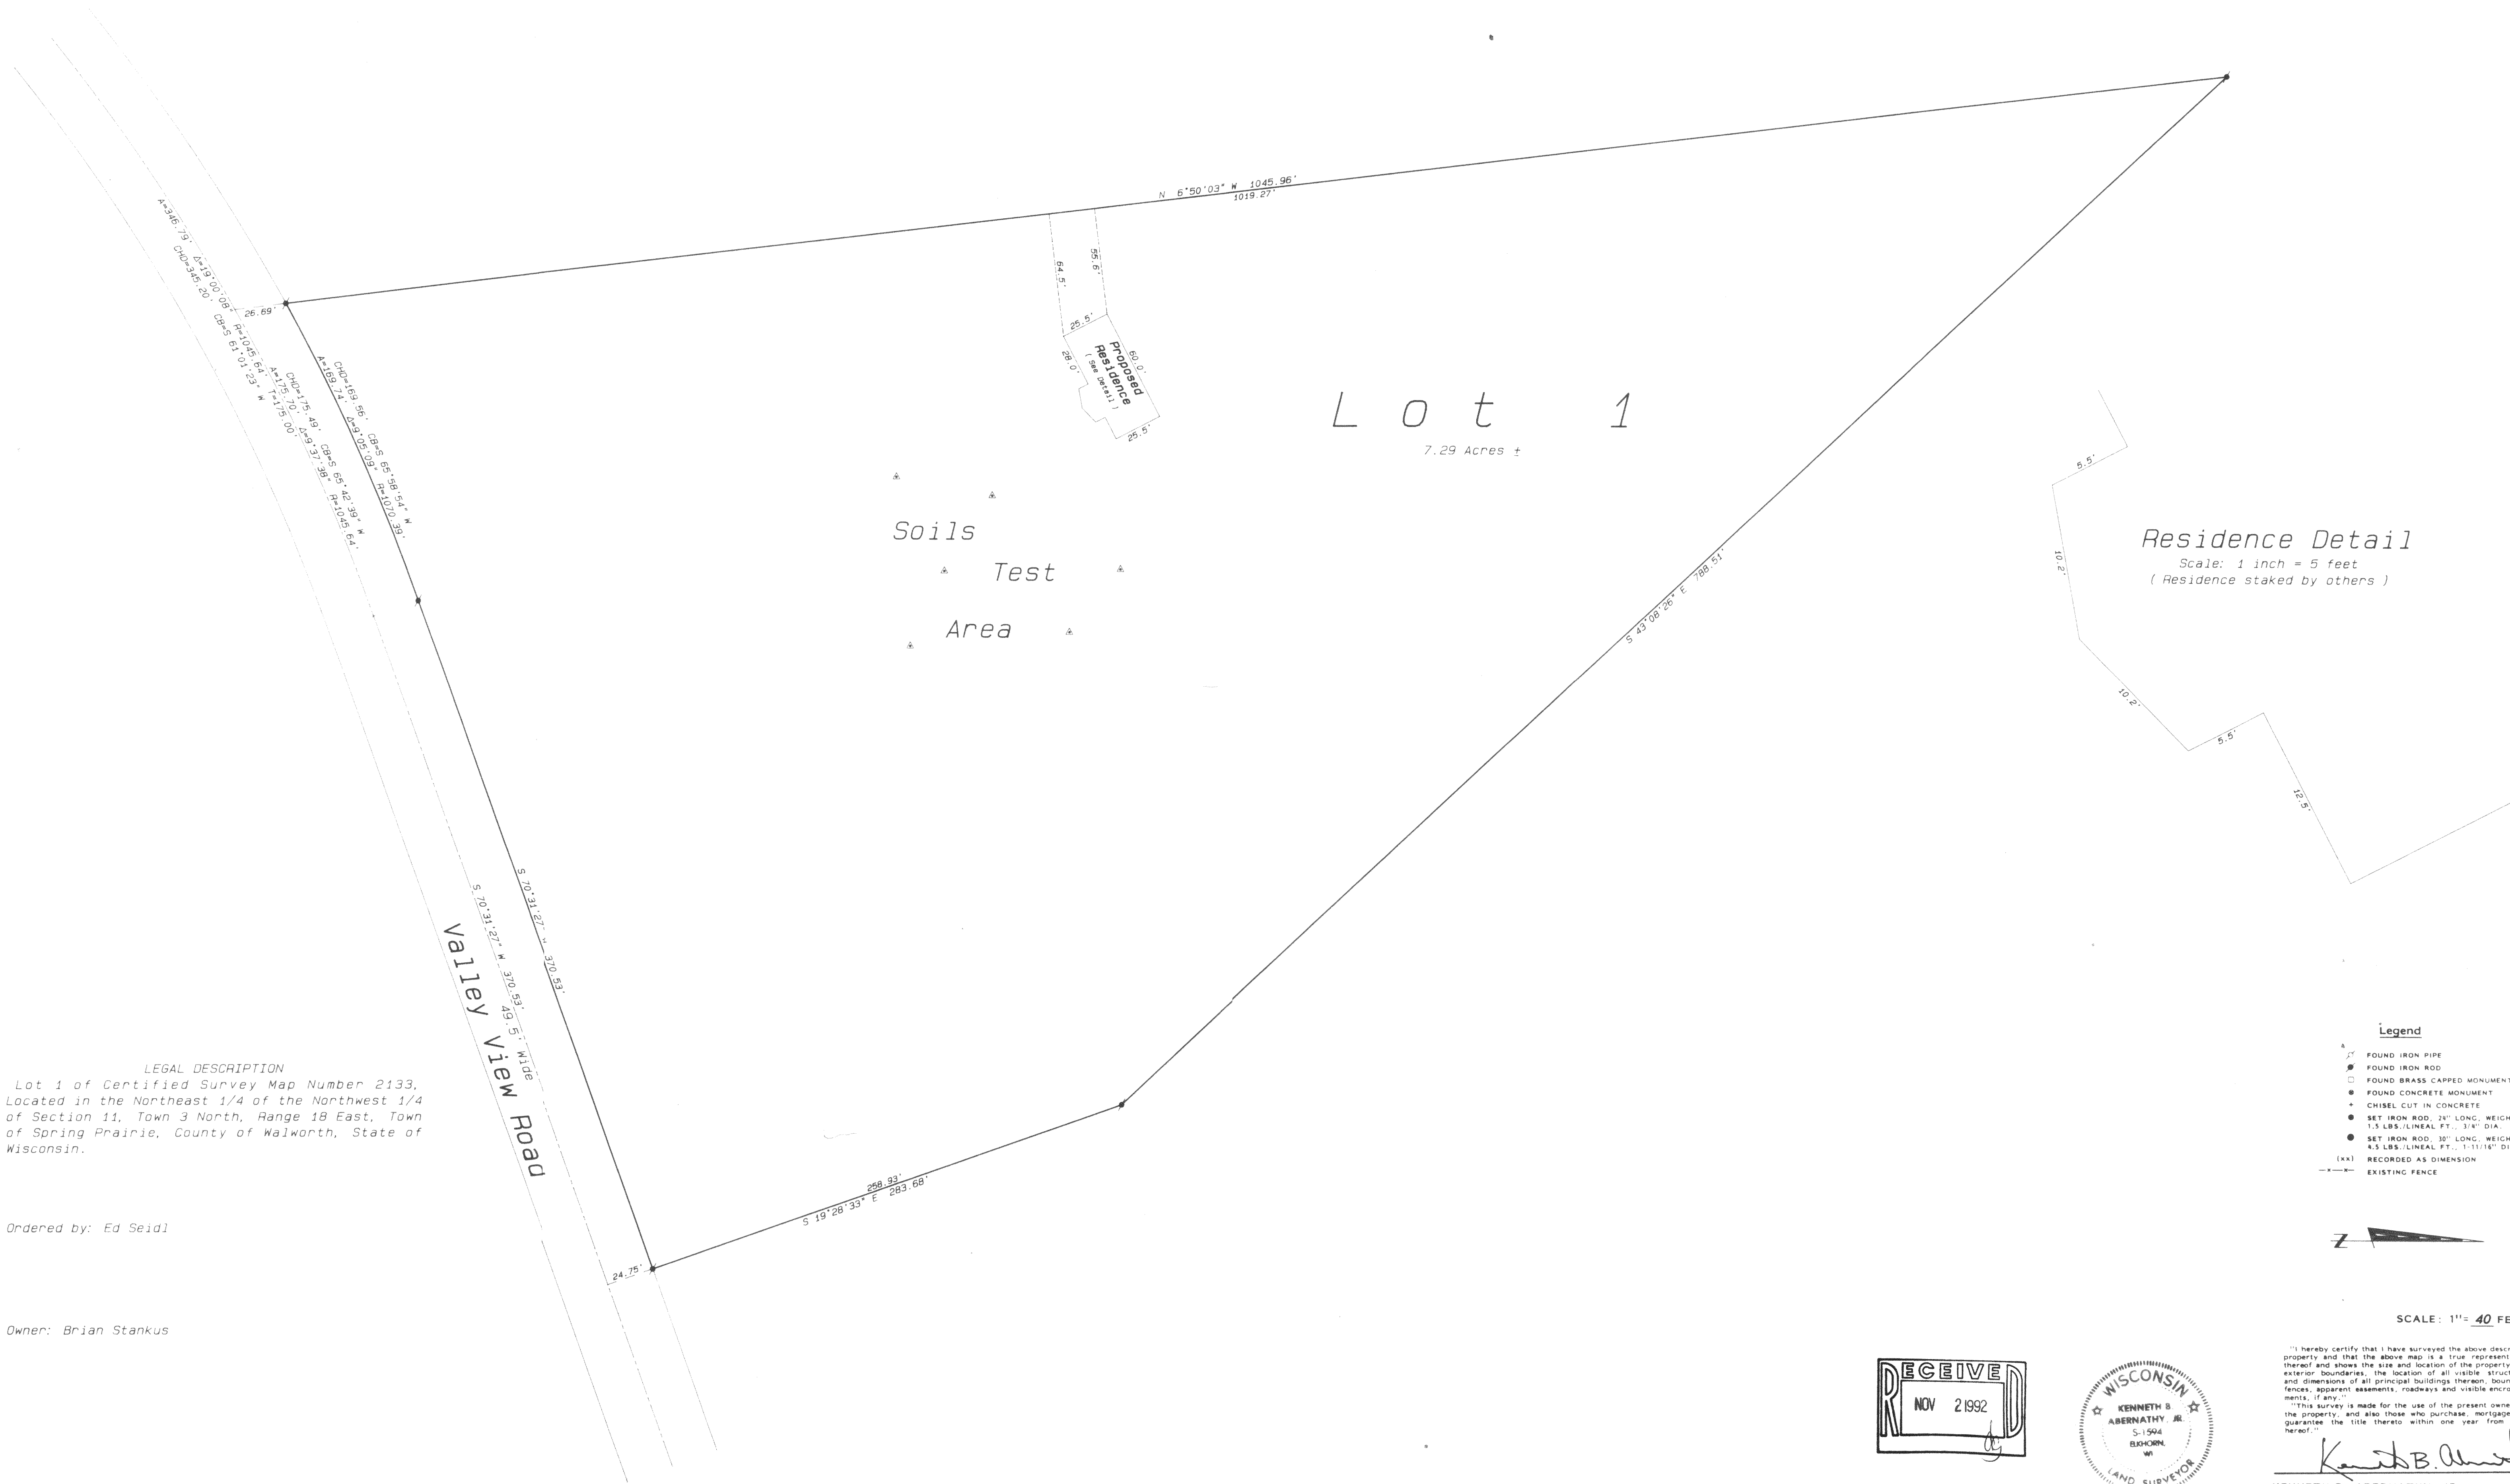

LEGAL DESCRIPTION
Lot 1 of Certified Survey Map Number 2133,
Located in the Northeast 1/4 of the Northwest 1/4
of Section 11, Town 3 North, Range 18 East, Town
of Spring Prairie, County of Walworth, State of
Wisconsin.

Ordered by: Ed Seidl

Owner: Brian Stankus

- Legend
- FOUND IRON PIPE
 - FOUND IRON ROD
 - FOUND BRASS CAPPED MONUMENT
 - FOUND CONCRETE MONUMENT
 - CHISEL CUT IN CONCRETE
 - SET IRON ROD, 24" LONG, WEIGHING 1.5 LBS./LINEAL FT., 1 1/8" DIA.
 - SET IRON ROD, 30" LONG, WEIGHING 4.5 LBS./LINEAL FT., 1 1/16" DIA.
 - RECORDED AS DIMENSION
 - EXISTING FENCE



SCALE: 1"= 40 FEET

"I hereby certify that I have surveyed the above described property and that the above map is a true representation thereof and shows the size and location of the property, its exterior boundaries, the location of all visible structures and dimensions of all principal buildings thereon, boundary fences, apparent easements, roadways and visible encroachments, if any."

"This survey is made for the use of the present owners of the property, and also those who purchase, mortgage, or guarantee the title thereto within one year from date hereof."

Kenneth B. Abernathy Jr.
KENNETH B. ABERNATHY, JR.
S-1594
WISCONSIN REGISTERED LAND SURVEYOR
S-1594

Date: May 18, 1992 Job No. 1892-509

