


# PLAT OF SURVEY

of  
Lot 1 of Certified Survey Map No. 2214, located in the Northeast  $\frac{1}{4}$   
of the Southwest  $\frac{1}{4}$  of Section 30, Town 3 North, Range 18 East, Town  
of Spring Prairie, Walworth County, Wisconsin.

Surveyed for: Tony & Diane Fincutter  
RFD 3  
Elkhorn, Wisconsin. 53121

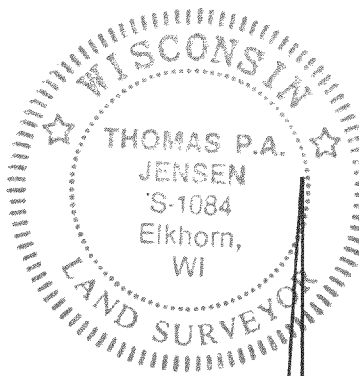

Surveyed by: Jensen Surveying & Mapping S.C.  
45 South Wisconsin Street  
Elkhorn, Wisconsin. 53121

Mapping date: September 25, 1992.

Soils: PsB.

Zoning: A-1.

Scale:



Bearings are assumed.

Note: Existing sanitary system appears to be functioning. No evaluation  
as to meeting the requirements for replacement system under "ILHR  
83" of the Wisconsin Administrative Code.

## LEGEND

- Found County Section Corner Monument
- Set iron rod  $\frac{3}{4}$ " dia., 30" long,  
weighing 1.5 lbs./lin. ft.
- Concrete cover.
- Septic vent.
- ✓ Utility pole.

