

PLAT OF SURVEY


RSV
ENGINEERING, INC.

Engineers • Land Surveyors • Environmental Scientists
801 MAIN STREET MUKONAGO, WISCONSIN 53149 (262) 363-2004

FOR: STEVEN AND AMY COLLINS

DATE: 3/24/05

DESCRIBED AS FOLLOWS: BEING A PARCEL OF LAND IN PART OF THE SE¹/₄ OF THE NE¹/₄ OF SECTION 4, TOWN 3 NORTH, RANGE 18 EAST, TOWN OF SPRING PRAIRIE, WALWORTH COUNTY, WISCONSIN BEING MORE COMPLETELY DESCRIBED AS FOLLOWS: COMMENCING AT THE EAST¹/₄ CORNER OF SAID SECTION 4; THENCE WITH THE EAST LINE OF THE NE¹/₄ OF SAID SECTION 4 N02°27'05"W, A DISTANCE OF 681.11' TO A POINT; THENCE N88°34'12"E, A DISTANCE OF 33.00' TO THE POINT OF BEGINNING; THENCE N02°27'05"W, A DISTANCE OF 75.00' TO A POINT; THENCE S88°34'12"W, A DISTANCE OF 202.50' TO A POINT; THENCE N02°27'05"W, A DISTANCE OF 217.10' TO A POINT; THENCE S88°34'12"W, A DISTANCE OF 395.46' TO A POINT; THENCE S02°27'05"E, A DISTANCE OF 292.10' TO A POINT; THENCE N88°34'12"E, A DISTANCE OF 597.96' TO THE POINT OF BEGINNING. SAID PARCEL CONTAINING 3.00 ACRES.

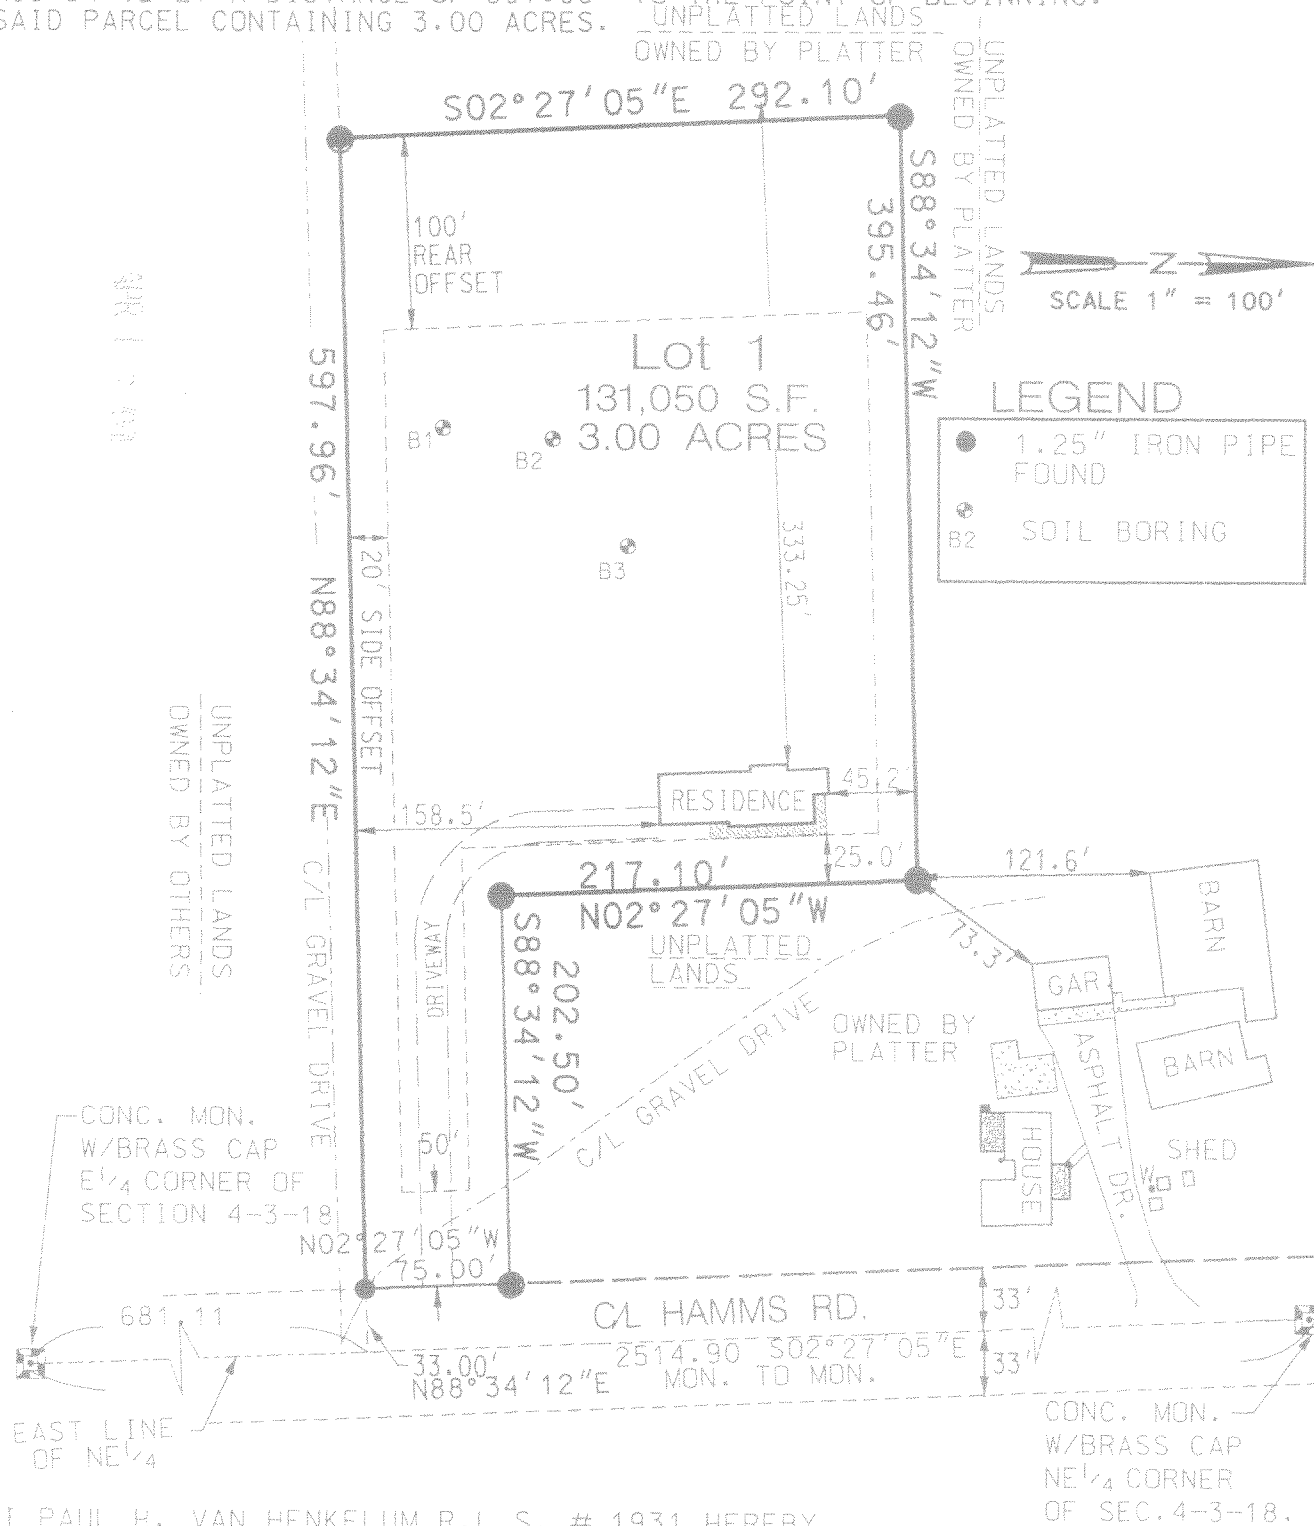

I PAUL H. VAN HENKELUM R.L.S. # 1931 HEREBY CERTIFY THAT THIS SURVEY WAS MADE IN ACCORDANCE WITH THE MINIMUM STANDARDS FOR PROPERTY SURVEYS (CHAPTER A-E7) STATE OF WISCONSIN AND HAS BEEN PREPARED UNDER MY DIRECTION AND CONTROL AND IS CORRECT TO THE BEST OF MY KNOWLEDGE AND BELIEF.

Paul H. Van Henkelum

PAUL H. VAN HENKELUM, R.L.S. # 1931
RSV#00188PLAT.DGN

