


PLAT OF SURVEY -OF-

LOT 3 OF CERTIFIED SURVEY MAP NO. 2434 AS RECORDED IN VOLUME 12 OF CERTIFIED SURVEY MAPS ON PAGES 85 AND 86 AS DOCUMENT NO. 283502 IN THE OFFICE OF THE REGISTER OF DEEDS IN AND FOR WALWORTH COUNTY, WISCONSIN AND LOCATED IN THE NORTHEAST 1/4 AND SOUTHEAST 1/4 OF THE NORTHWEST 1/4 OF SECTION 1, TOWNSHIP 3 NORTH, RANGE 18 EAST OF THE FOURTH PRINCIPAL MERIDIAN, IN THE TOWN OF SPRING PRAIRIE, WALWORTH COUNTY, WISCONSIN.


SURVEY FOR: 3D CONSTRUCTION

SURVEY ADDRESS: N7261 BELL SCHOOL ROAD

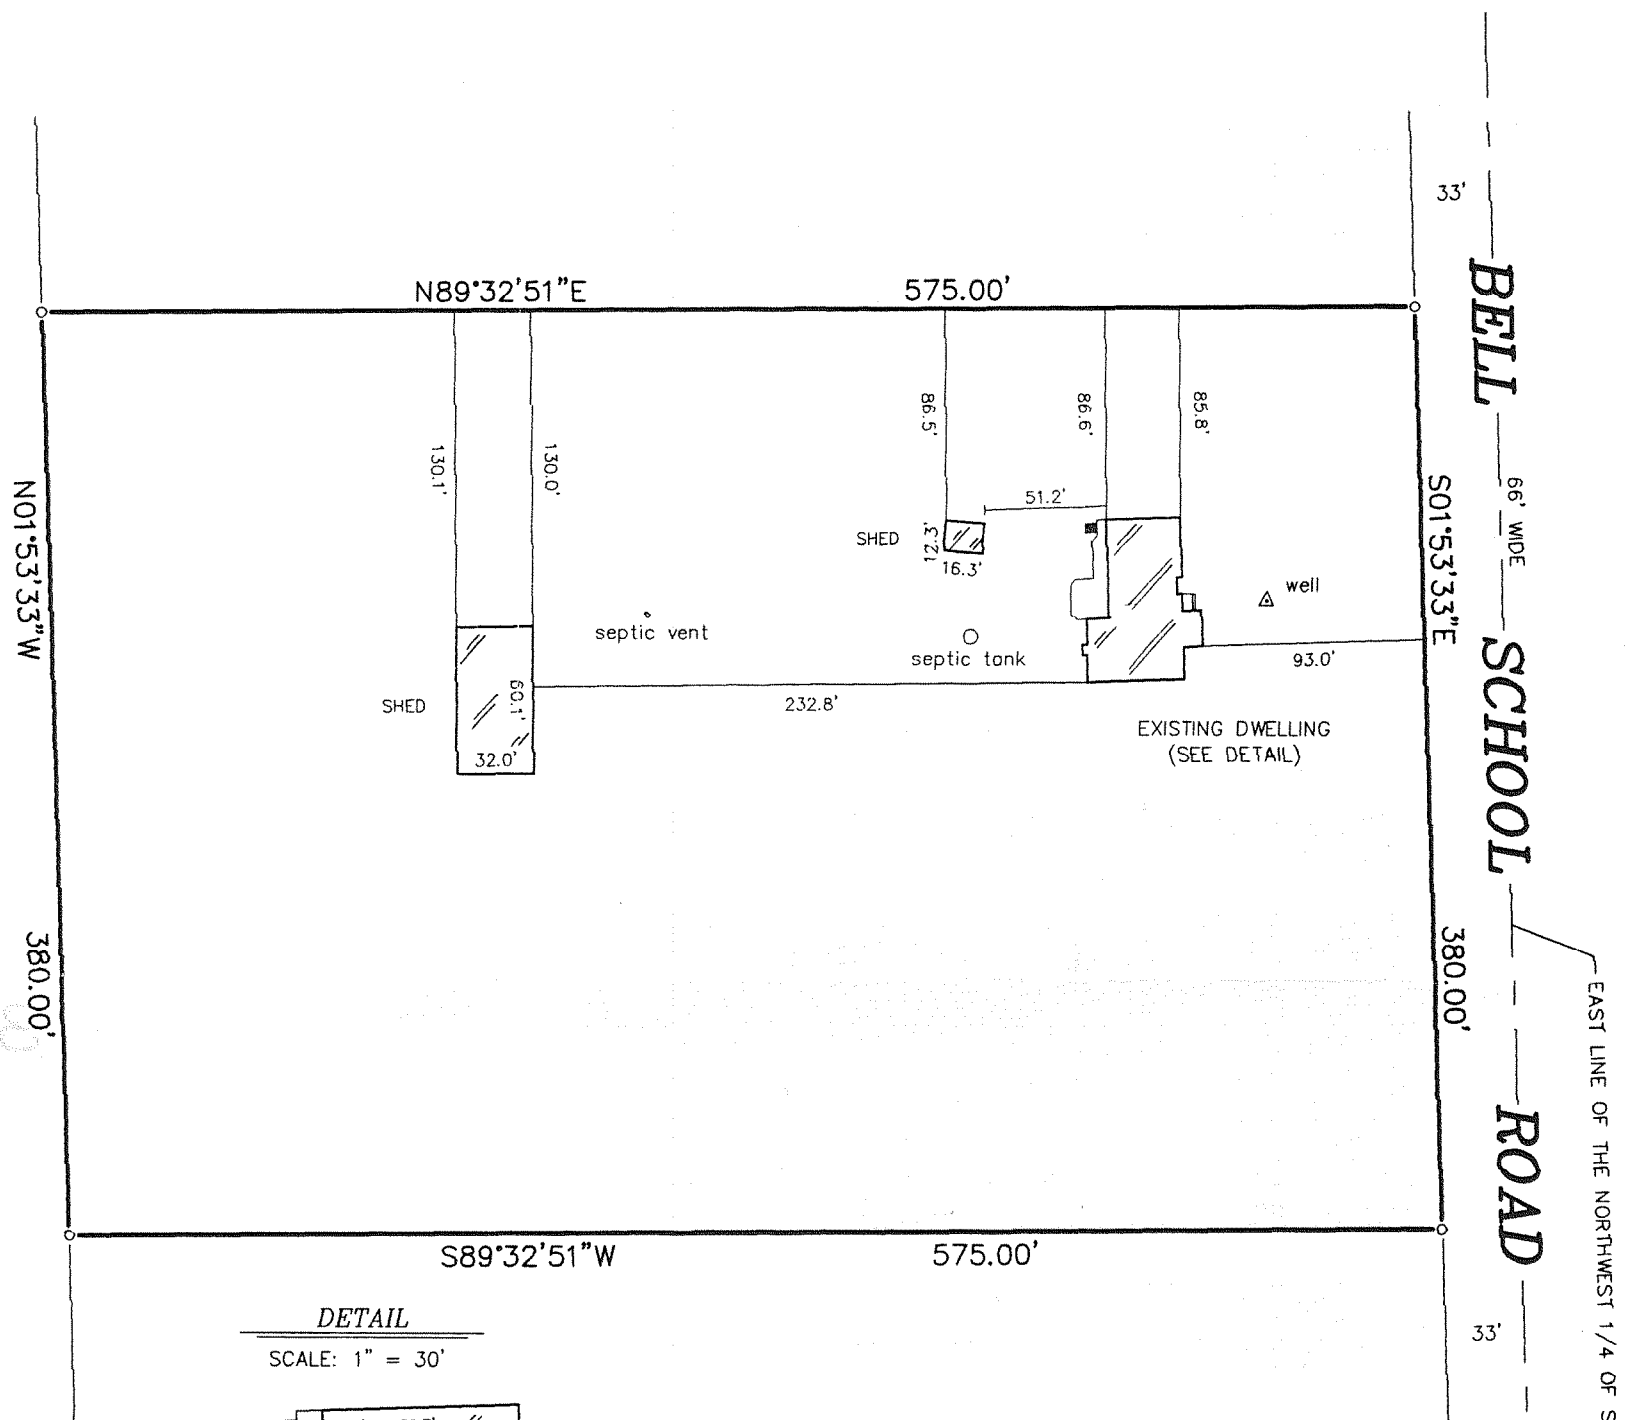


DETAIL

SCALE: 1" = 30'

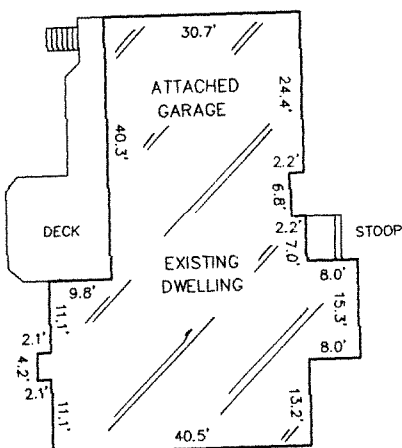

LEGEND

○ FOUND IRON ROD

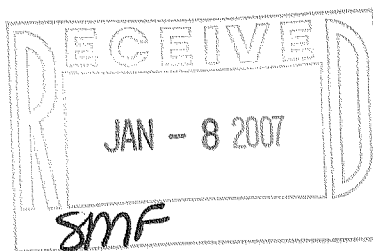


"I hereby certify that I have surveyed the above described property and that the above map is a correct representation thereof and shows the size and location of the property, its exterior boundaries, the location of all visible structures and dimensions of all principal buildings thereon, boundary fences, apparent easements, roadways and encroachments, if any."


"This survey is made for the use of the present owners of the property, and those who purchase, mortgage, or guarantee the title thereto within one year from date hereof."

SCALE:

1" = 80'

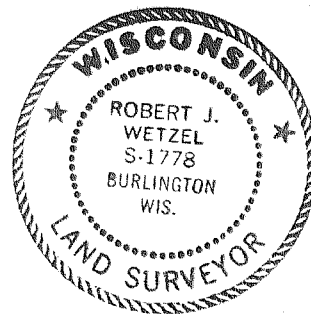

THIS IS NOT AN ORIGINAL PRINT
UNLESS THIS SEAL IS RED.

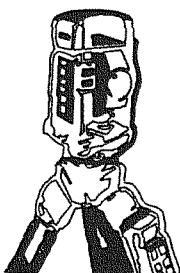

B.W. SURVEYING, INC.

LAND SURVEYS
MAPPING AND PLANNING
412 N. PINE STREET
BURLINGTON, WI 53105
(262)-767-0225

Robert J. Wetzel
ROBERT J. WETZEL S-1778

AUGUST 29, 2006
DATE

7389
JOB NUMBER

OA2434-3

318-1000