

PREPARED FOR:  
 LAURA HALBACH  
 SHOREWEST REALTORS  
 3580 S. MORELAND RD.  
 NEW BERLIN, WI 53151

# PLAT OF SURVEY

PATHFINDER SURVEYING INC.  
 W2888 KRUEGER RD. UNIT D  
 LAKE GENEVA WI. 53147


- OF -

LOTS 4, 5 & 6, BLOCK 26, HONEY LAKE, FIRST ADDITION, ACCORDING TO THE RECORDED PLAT THEREOF. SAID LAND BEING IN THE TOWN OF SPRING PRAIRIE, WALWORTH COUNTY, WISCONSIN.

## C.L. KEARNEY ROAD

(66' WIDE)

(PLATTED AS ROCHESTER AVENUE)

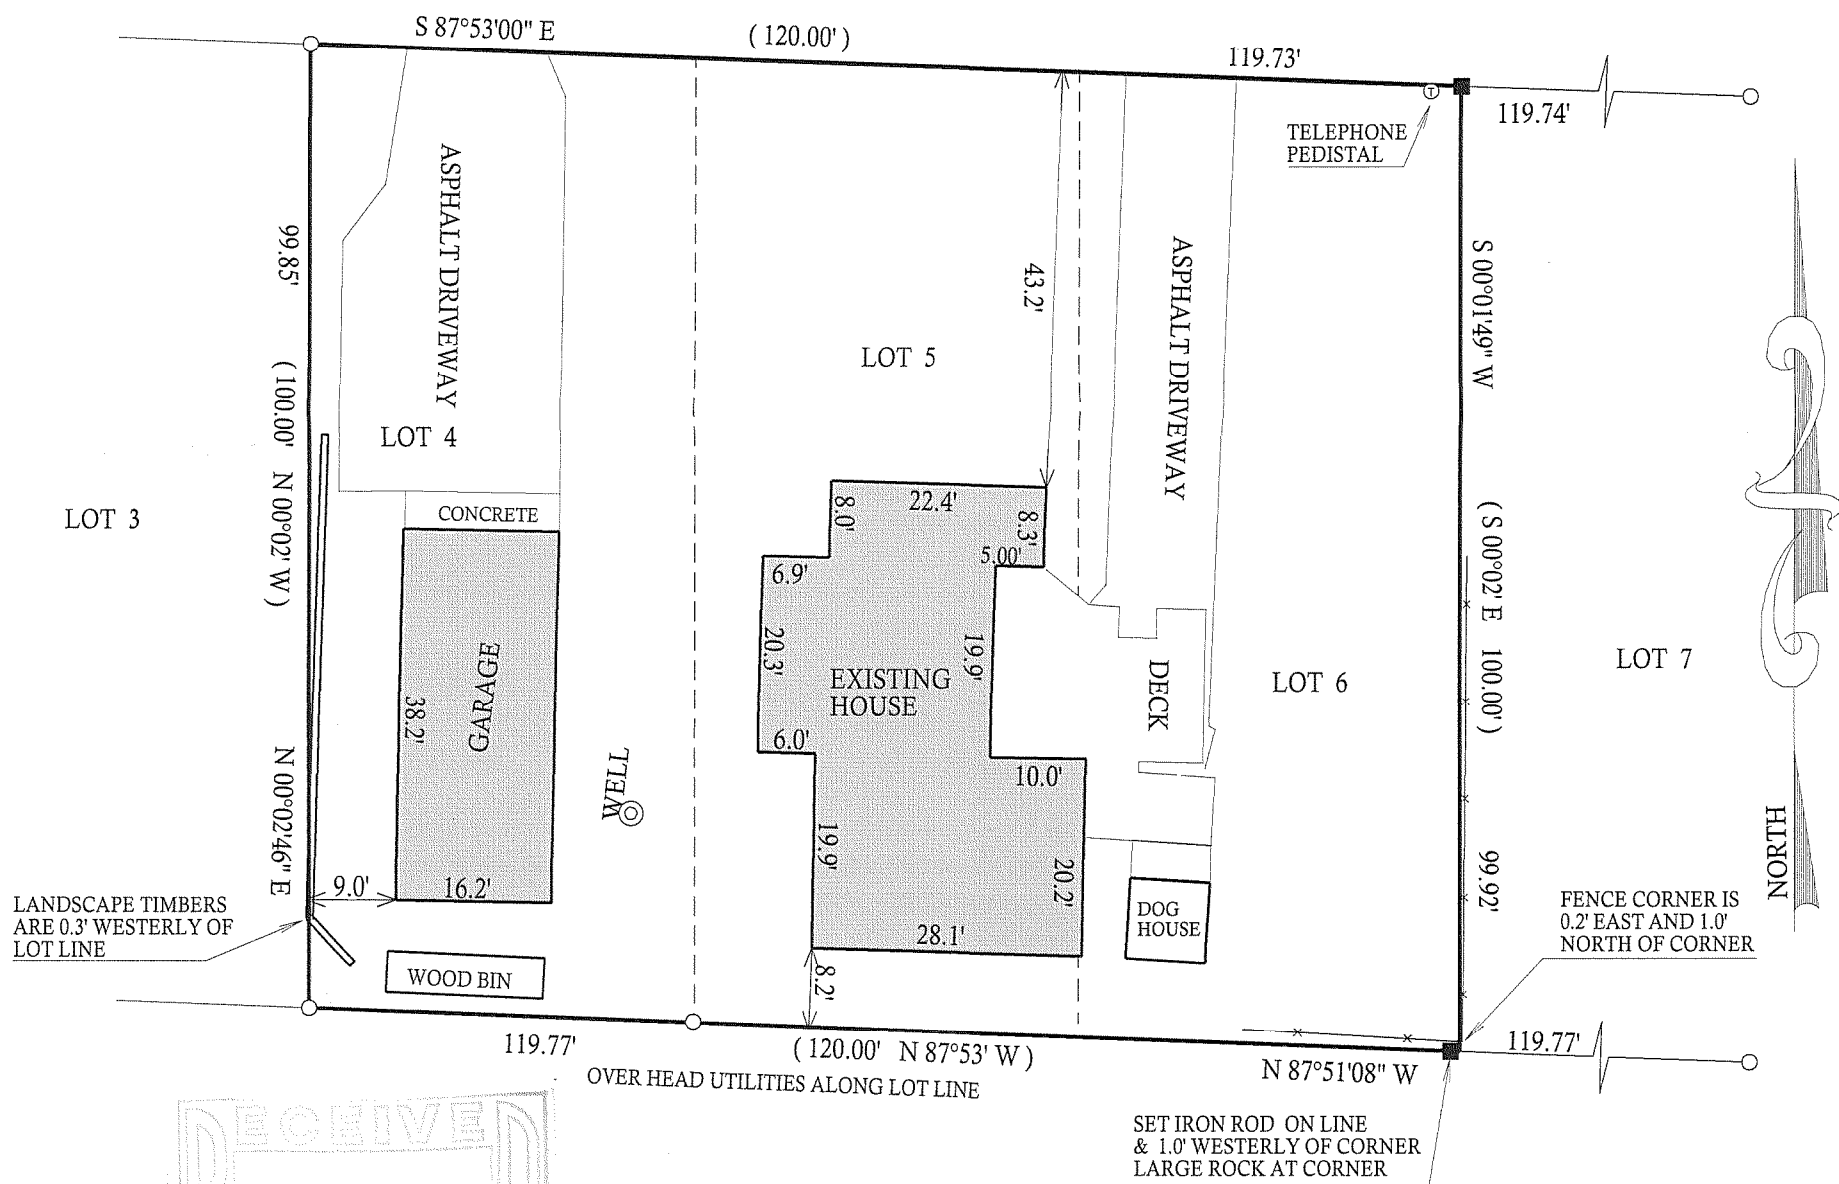

RECEIVED  
 MAY 30 2007  
 JMF


- ( ) = recorded as
- = found iron bar
- = found iron pipe
- = set iron pipe
- = set iron bar

COMPARE LEGAL DESCRIPTION ABOVE AND DRAWING WITH DEED. FOR BUILDING RESTRICTIONS AND EASEMENTS NOT SHOWN, REFER TO DEED, ABSTRACT SOURCES AND LOCAL MUNICIPAL CODES. NOTIFY THE SURVEYOR IMMEDIATELY OF ANY DISCREPANCY.

SCALE 1" = 20'

"I hereby certify that I have surveyed the above described property and that the above map is a true representation thereof and shows the size and location of all visible structures, apparent easements and encroachments if any."  
 This survey is made for the present owners of the property, and those who purchase, mortgage, or guarantee the title thereto, within one year from the date hereof.

JOB # 07-206

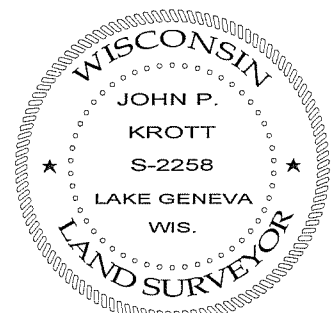

*John P. Krott*  
 JOHN KROTT S-2258  
 Wisconsin Registered Land Surveyor  
 (original if signed in red)

TAX ID # OHL1 00160 AND OHL1 00159

DATED THIS 24th, DAY OF MAY, 2007

318-1017