
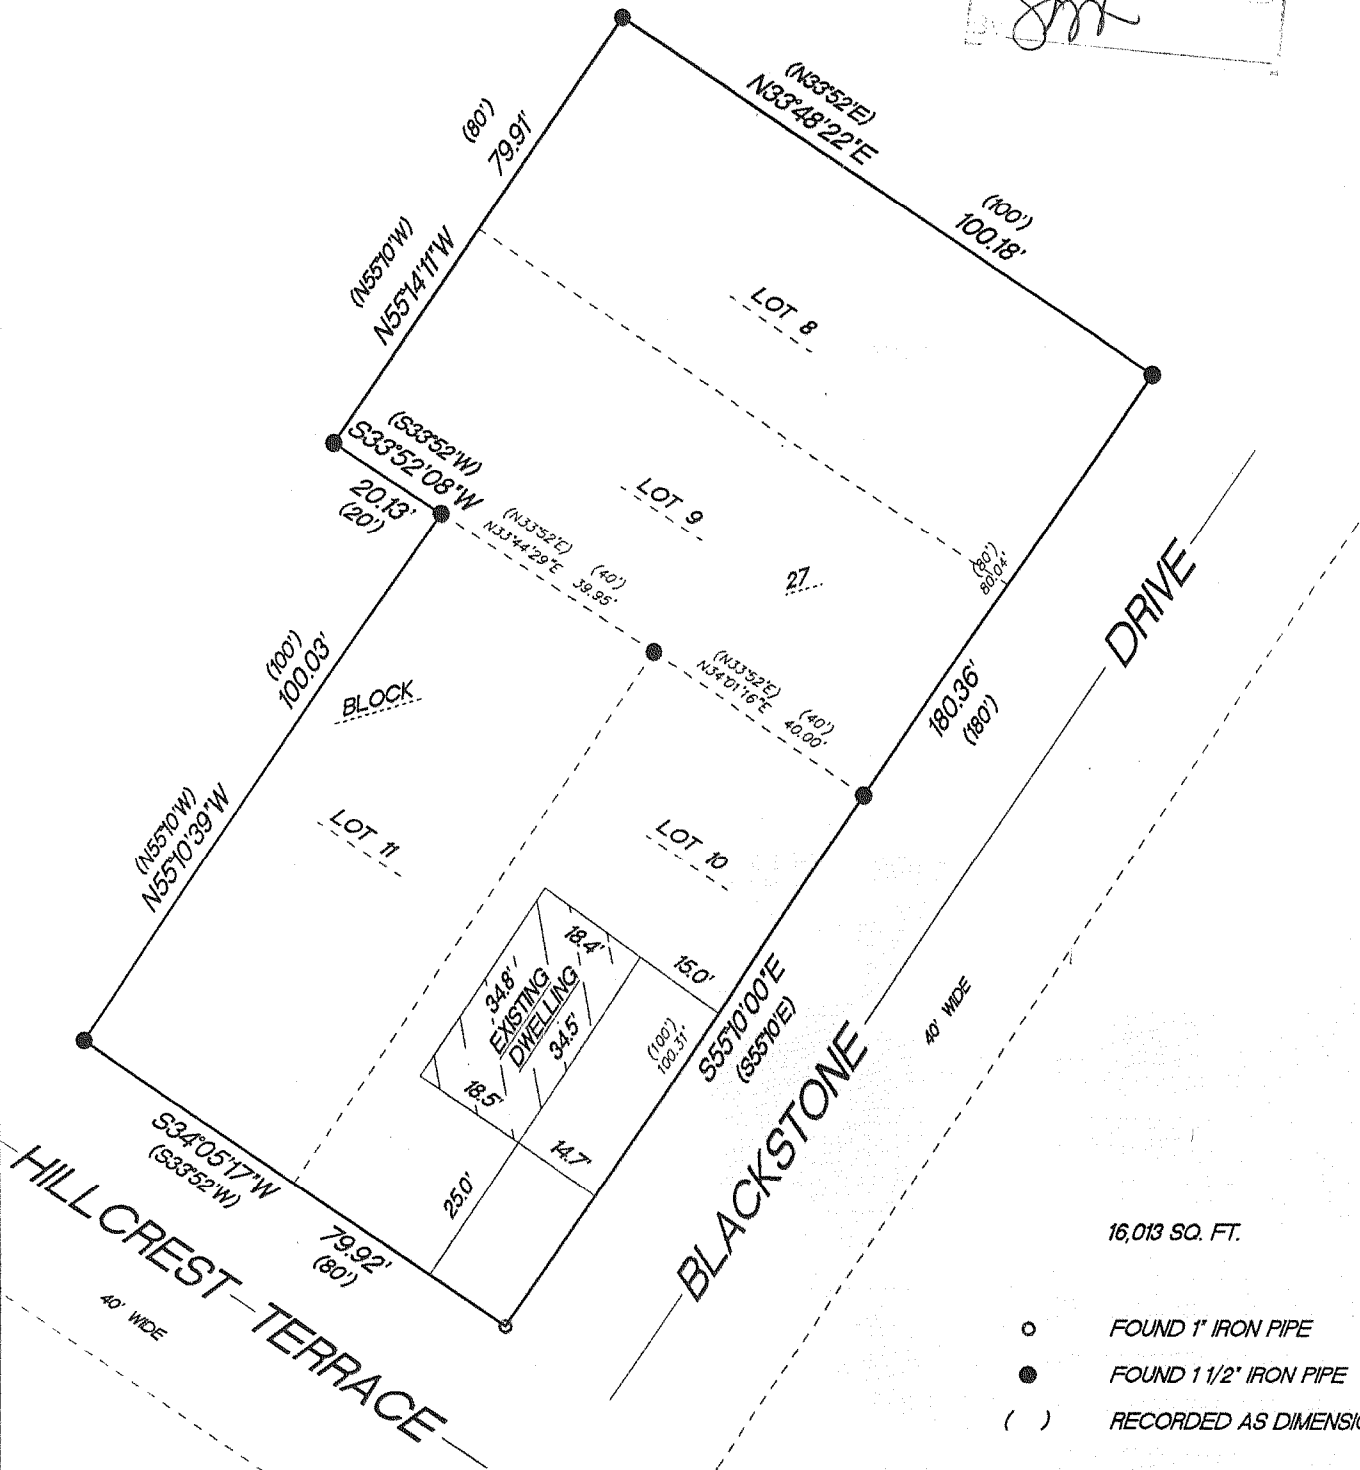


PLAT OF SURVEY

LOTS 8, 9, 10 AND 11, BLOCK 27, HONEY LAKE SUBDIVISION FIRST ADDITION, according to the recorded plat thereof, said land being in the Town of Spring Prairie, County of Walworth, and State of Wisconsin.

Surveyed for: William Di Cianni

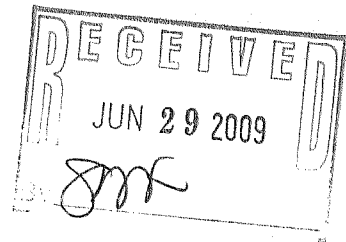

16,013 SQ. FT.

- FOUND 1" IRON PIPE
- FOUND 1 1/2" IRON PIPE
- () RECORDED AS DIMENSIONS


SCALE 1"=30'

"I hereby certify that I have surveyed the above described property and that the above map is a true representation thereof and shows the size and location of the property, its exterior boundaries, the location of all visible structures and dimension of all principal buildings thereon, boundary fences, apparent easements, roadways and encroachments if any."

"This survey is made for the use of the present owners of the property, and also those who purchase, mortgage or guarantee the title thereto within one year from date hereof."

KETTLE MORaine SURVEYING INC
 75 W36245 Wilton Road
 Eagle Wisconsin 53119
 P.O. Box 357
 (262) 594-3484

Terrance E. Pisarek R.L.S.

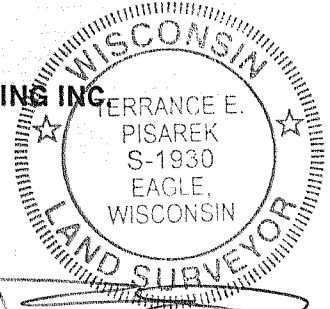

THIS IS NOT AN ORIGINAL SURVEY UNLESS THE SEAL IS RED.

6/24/09

TEP

TEP

09056

DATE

FIELD WORK BY

DRAWN BY

JOB NUMBER

0411-187 0411-188 0411-189

318-1074