PLAT OF SURVEY -OF-

LOTS 4 AND 5 OF BLOCK 15 OF HONEY LAKE SUBDIVISION FIRST ADDITION. LOCATED IN PART OF SECTION 13, TOWN 3 NORTH, RANGE 18 EAST, WALWORTH COUNTY, WISCONSIN.

SURVEY FOR: DON CHAULKIN JR.

SURVEY ADDRESS: N6185 CRESCENT PLACE,

BURLINGTON, WISCONSIN


BEARINGS HEREON RELATE TO THE WEST LINE OF CRESCENT PLACE ASSUMED BEARING \$03°00'00"E.

"I hereby certify that I have surveyed the above described property and that the above map is a correct representation thereof and shows the size and location of the property, its exterior boundaries, the location of all visible structures and dimensions of all principal buildings thereon, boundary fences, apparent easements, roadways and encroachments, if any."

"This survey is made for the use of the present owners of the property, and those who purchase, mortgage, or guarantee the title thereto within one year from date hereof."

B.W. SURVEYING, INC.


412 N. PINE STREET BURLINGTON, WI 53105 (262)-767-0225

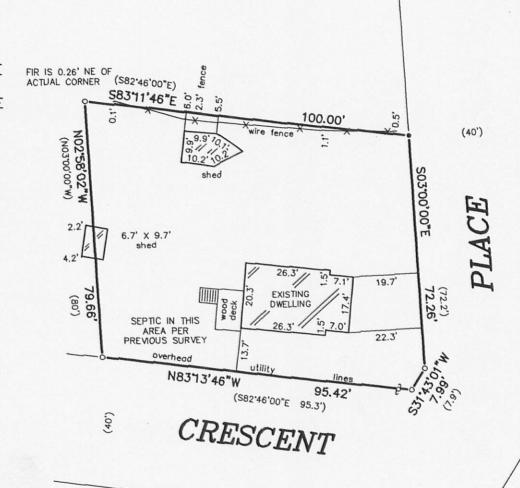


LEGEND

- FOUND IRON ROD
- SET NAIL
- ∂ UTILITY POLE

RECORDED AS By By

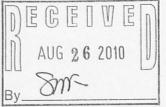

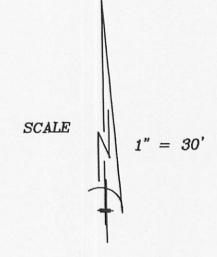



THIS IS NOT AN ORIGINAL PRINT UNLESS THIS SEAL IS RED.

ROBERT J. WETZEL S-1778

AUGUST 6, 2009

3073 JOB NUMBER

OHL1-113P

318-1084