

3801-818

PLAT OF SURVEY -OF-

LOTS 4 AND 5 OF BLOCK 15 OF HONEY LAKE SUBDIVISION FIRST ADDITION. LOCATED IN PART OF SECTION 13, TOWN 3 NORTH, RANGE 18 EAST, WALWORTH COUNTY, WISCONSIN.

SURVEY FOR: DON CHAULKIN JR.




SURVEY ADDRESS: N6185 CRESCENT PLACE, BURLINGTON, WISCONSIN

BEARINGS HEREON RELATE TO THE WEST LINE OF CRESCENT PLACE ASSUMED BEARING S03°00'00"E.

NOTE: SHED/DOGHOUSE HEREON NOT SHOWN PER OWNER.

"I hereby certify that I have surveyed the above described property and that the above map is a correct representation thereof and shows the size and location of the property, its exterior boundaries, the location of all visible structures and dimensions of all principal buildings thereon, boundary fences, apparent easements, roadways and encroachments, if any."

"This survey is made for the use of the present owners of the property, and those who purchase, mortgage, or guarantee the title thereto within one year from date hereof."

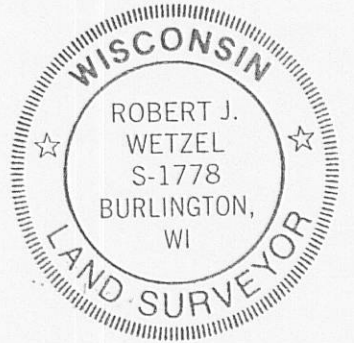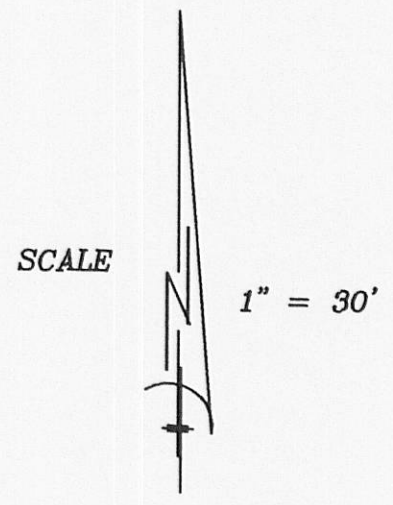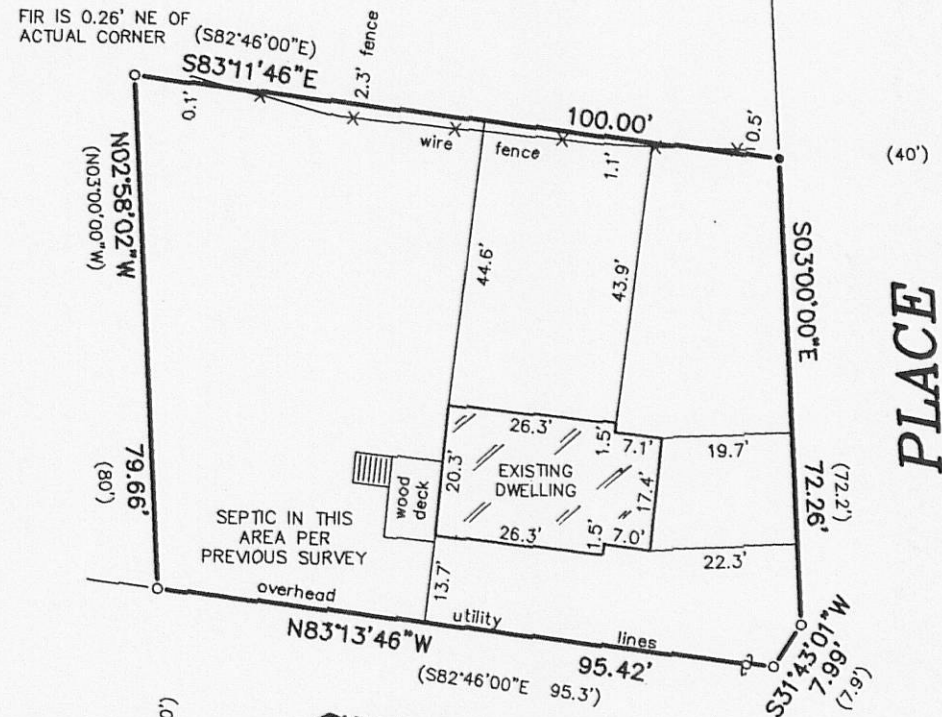


B.W. SURVEYING, INC.

412 N. PINE STREET
BURLINGTON, WI 53105
(262)-767-0225

LEGEND

- FOUND IRON ROD
- SET NAIL
- ⊕ UTILITY POLE
- () RECORDED AS

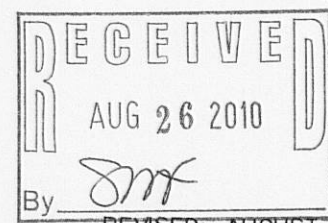

REVISED: AUGUST 10, 2009

THIS IS NOT AN ORIGINAL PRINT UNLESS THIS SEAL IS RED.

Robert J. Wetzel
ROBERT J. WETZEL S-1778

AUGUST 6, 2009
DATE

8073
JOB NUMBER

OHL 1 - 113B

318-1085