

PLAT OF SURVEY


-OF-

LOTS 8, 9, AND THE SOUTHWESTERLY 21 FEET OF LOT 11,
BLOCK 27, HONEY LAKE SUBDIVISION FIRST ADDITION,
ACCORDING TO THE RECORDED PLAT THEREOF. SAID LAND
BEING IN THE TOWN OF SPRING PRAIRIE, COUNTY OF
WALWORTH AND STATE OF WISCONSIN.

SURVEY FOR: JOHN CAIN



"THIS LOT LINE ADJUSTMENT IS FOR THE PURPOSE OF A SALE OR EXCHANGE OF LAND BETWEEN ADJOINING LAND OWNERS THAT DOES NOT CREATE ADDITIONAL LOTS AND THE ORIGINAL PARCELS ARE NOT REDUCED BELOW THE MINIMUM SIZE REQUIRED BY THE WALWORTH COUNTY CODE OF ORDINANCES (ZONING/SHORELAND ZONING)."

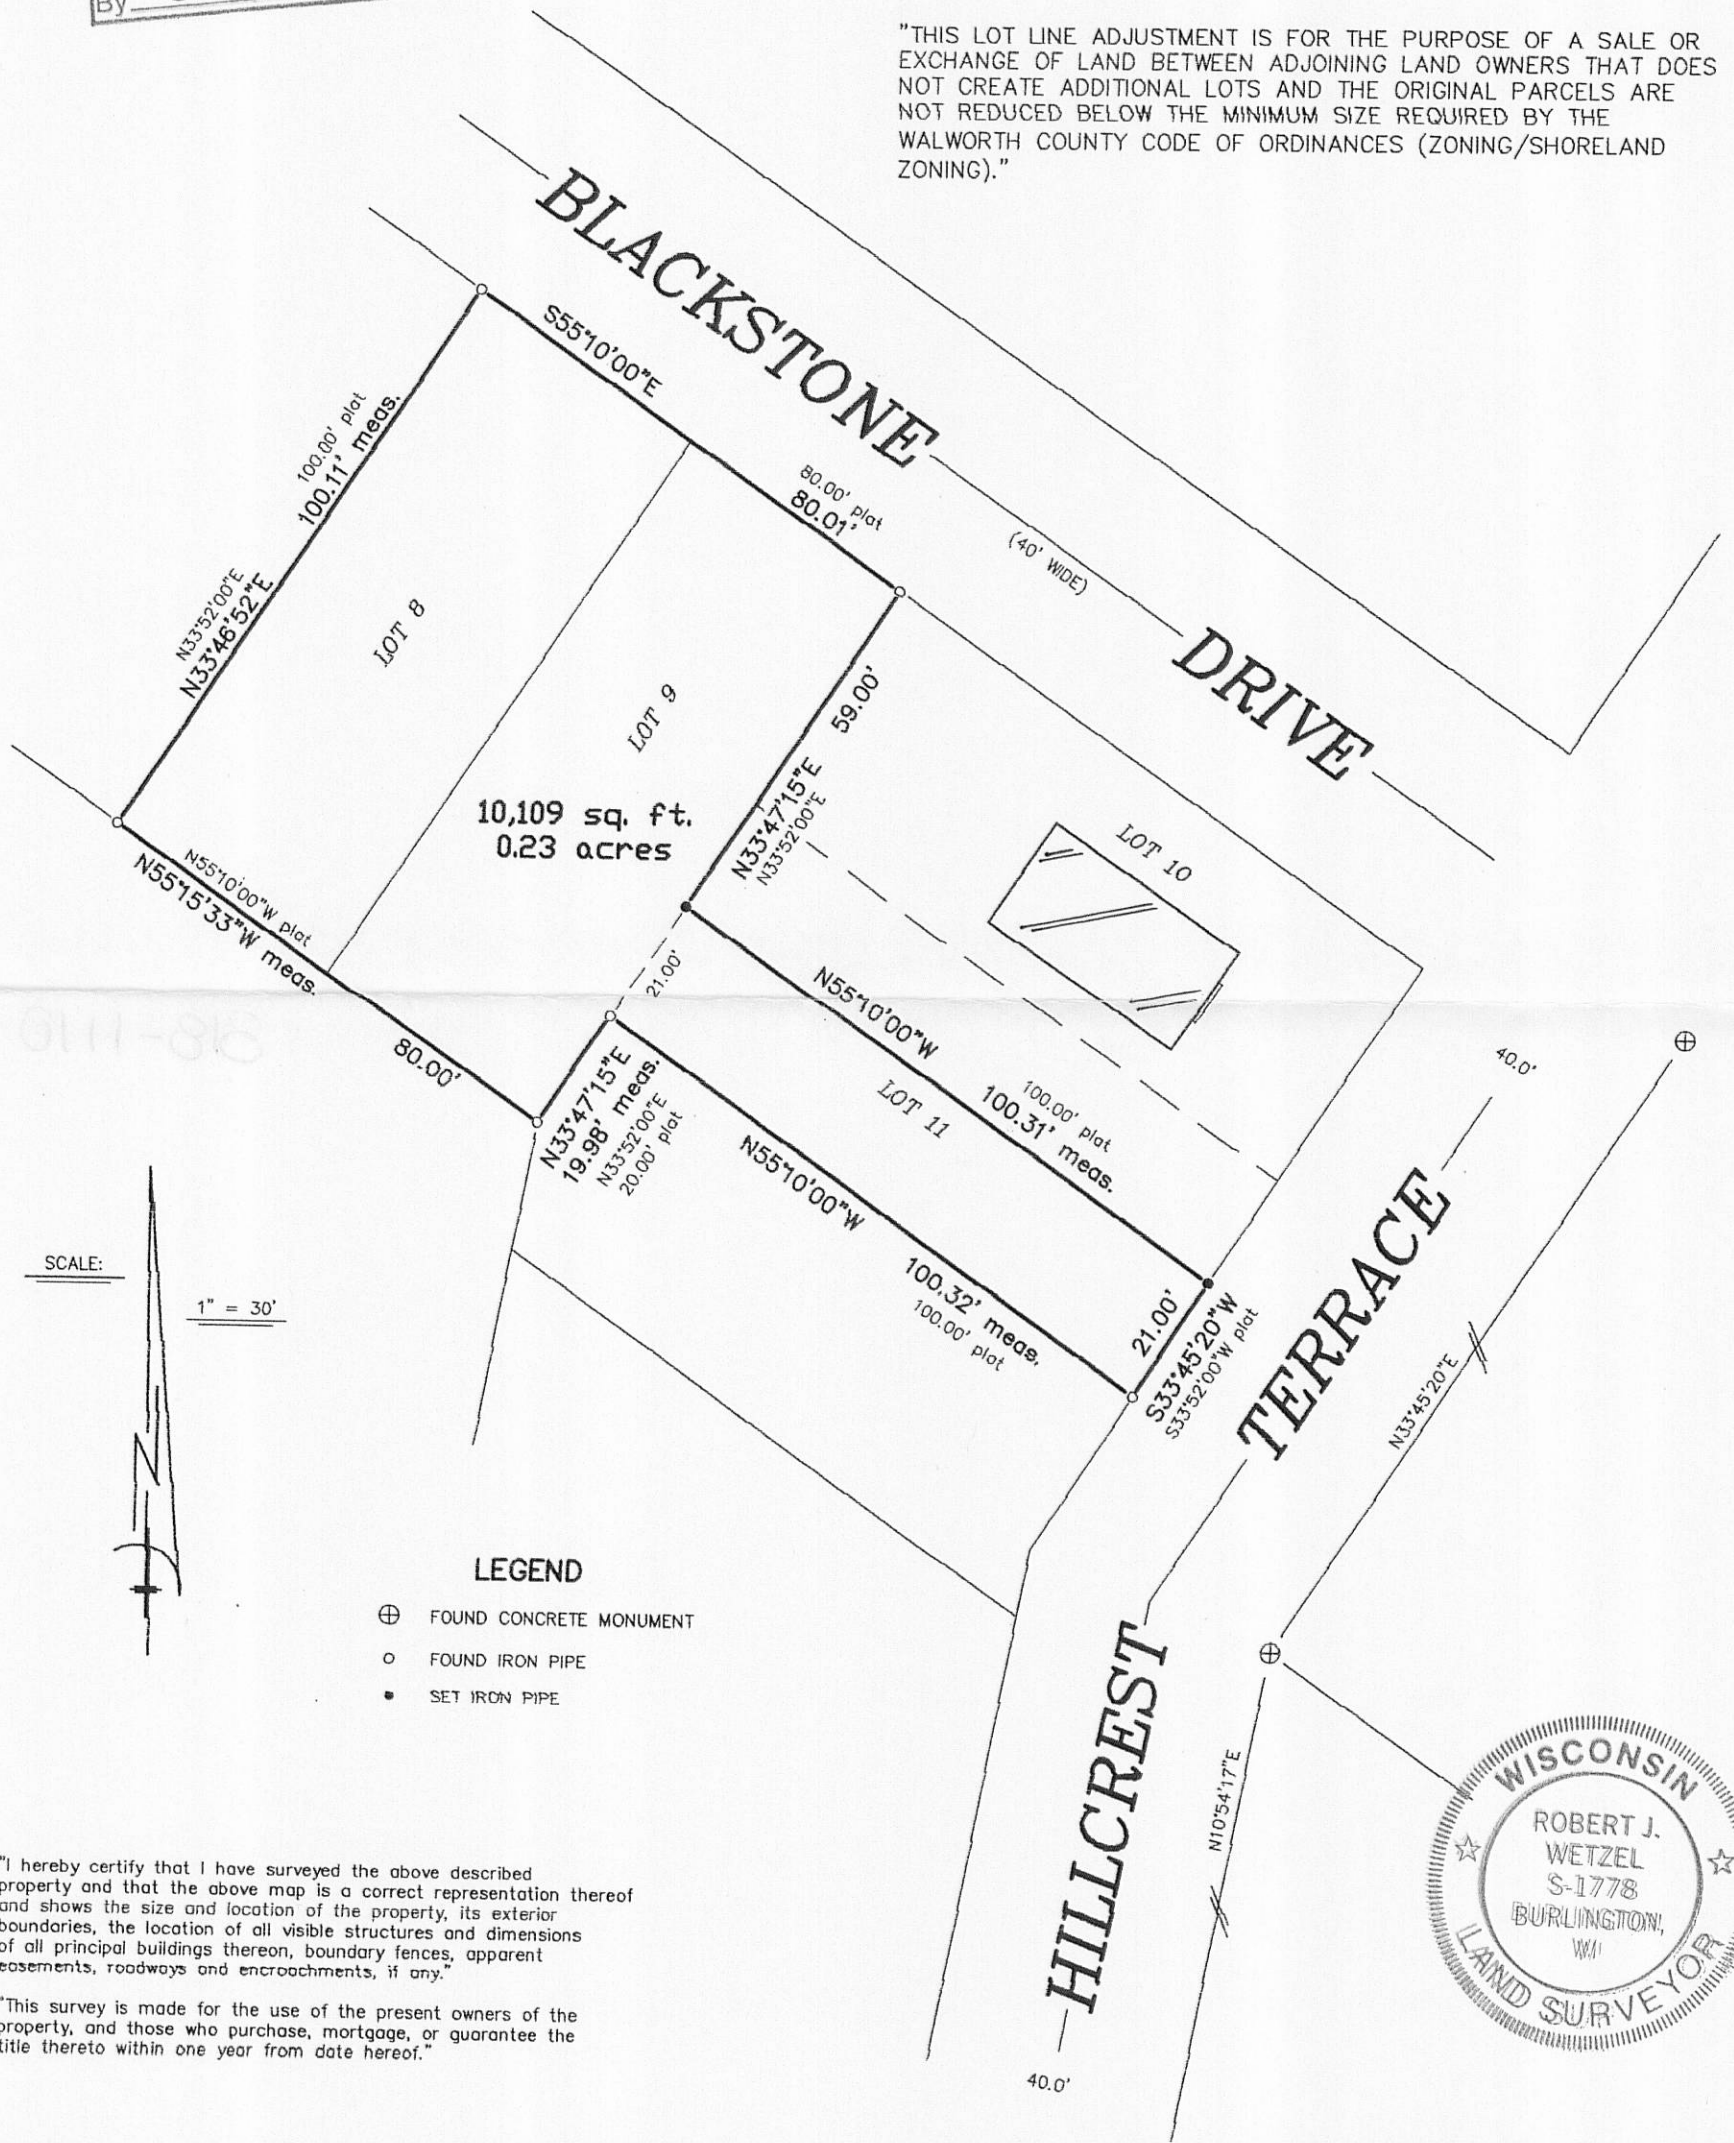

LEGEND

- ⊕ FOUND CONCRETE MONUMENT
- FOUND IRON PIPE
- SET IRON PIPE

"I hereby certify that I have surveyed the above described property and that the above map is a correct representation thereof and shows the size and location of the property, its exterior boundaries, the location of all visible structures and dimensions of all principal buildings thereon, boundary fences, apparent easements, roadways and encroachments, if any."

"This survey is made for the use of the present owners of the property, and those who purchase, mortgage, or guarantee the title thereto within one year from date hereof."



THIS IS NOT AN ORIGINAL PRINT UNLESS THIS SEAL IS RED.

B.W. SURVEYING, INC.

LAND SURVEYS
MAPPING AND PLANNING
412 N. PINE STREET
BURLINGTON, WI 53105
(262)-767-0225

Robert J. Wetzel
ROBERT J. WETZEL S-1778

JUNE 24, 2011
DATE

8341-A
JOB NUMBER

OHLI-187 OHLI-189

318-1110