

# PLAT OF SURVEY -OF-


THE SOUTHERLY 20' OF LOT 20, AND ALL OF LOTS 21  
THRU 26, BLOCK 26 HONEY LAKE SUBDIVISION FIRST  
ADDITION, ACCORDING TO THE RECORDED PLAT THEROF.  
SAID LAND BEING IN THE TOWN OF SPRING PRAIRIE,  
COUNTY OF WALWORTH AND STATE OF WISCONSIN.

SURVEY FOR: PAUL JAGLOWSKI  
SURVEY ADDRESS: N6281 HILLCREST TERRACE





SCALE 1" = 40'

- LEGEND**
- FOUND IRON PIPE
  - SET IRON PIPE
  - ⊙ FOUND CONCRETE MONUMENT

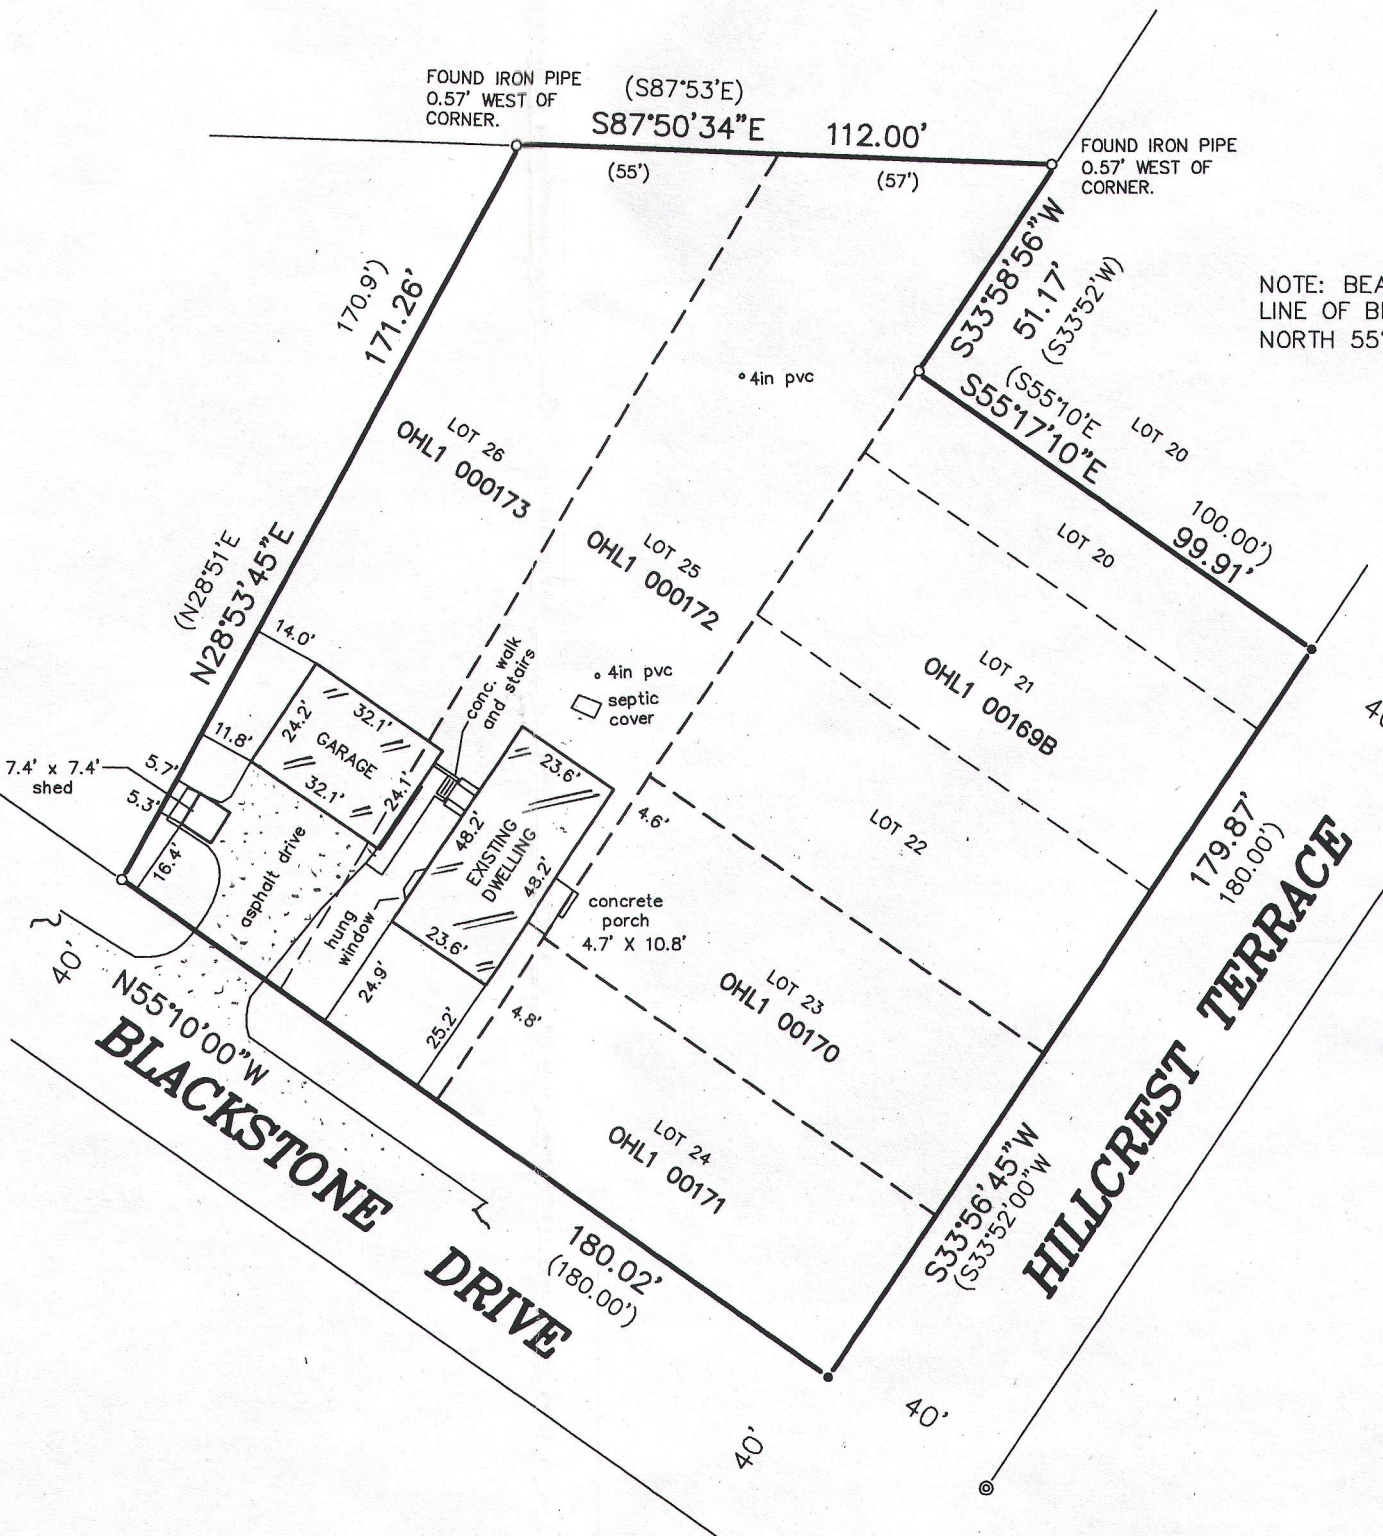


NOTE: BEARINGS HEREON RELATE TO THE NORTH  
LINE OF BLACKSTONE DRIVE, ASSUMED BEARING  
NORTH 55°10'00" WEST.

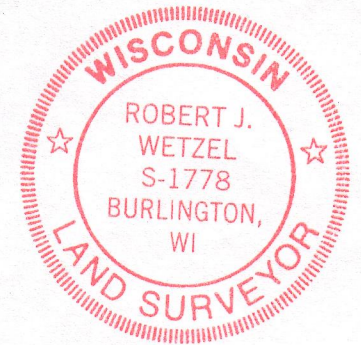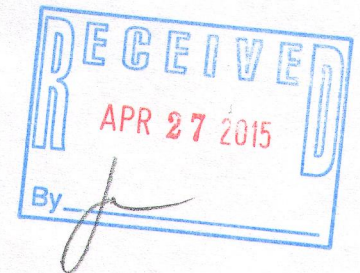

"I hereby certify that I have surveyed the above described property and that the above map is a correct representation thereof and shows the size and location of the property, its exterior boundaries, the location of all visible structures and dimensions of all principal buildings thereon, boundary fences, apparent easements, roadways and encroachments, if any."

"This survey is made for the use of the present owners of the property, and those who purchase, mortgage, or guarantee the title thereto within one year from date hereof."

THIS IS NOT AN ORIGINAL PRINT  
UNLESS THIS SEAL IS RED.

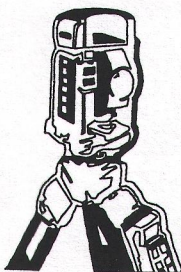

**B.W. SURVEYING, INC.**

LAND SURVEYS  
MAPPING AND PLANNING  
412 N. PINE STREET  
BURLINGTON, WI 53105  
(262)-767-0225

*Robert J. Wetzel*  
ROBERT J. WETZEL S-1778

AUGUST 26, 2014  
DATE

8803  
JOB NUMBER

OHL1 -172 318-1174