


PLAT OF SURVEY  
-OF-

LOTS 1, 2 AND 19 IN BLOCK 2 OF HONEY LAKE SUBDIVISION, ACCORDING TO THE  
RECORDED PLAT THEREOF. SAID LAND BEING IN THE TOWN OF SPRING PRAIRIE, COUNTY  
OF WALWORTH AND STATE OF WISCONSIN.

SURVEY FOR: ANDREW LEMKE  
SURVEY ADDRESS: W113 EUCLID AVENUE, BURLINGTON, WI 53105

NOTE: REFER TO A CURRENT TITLE REPORT FOR EASEMENTS,  
RESTRICTIONS OR COVENANTS WHICH MAY AFFECT THIS PROPERTY.

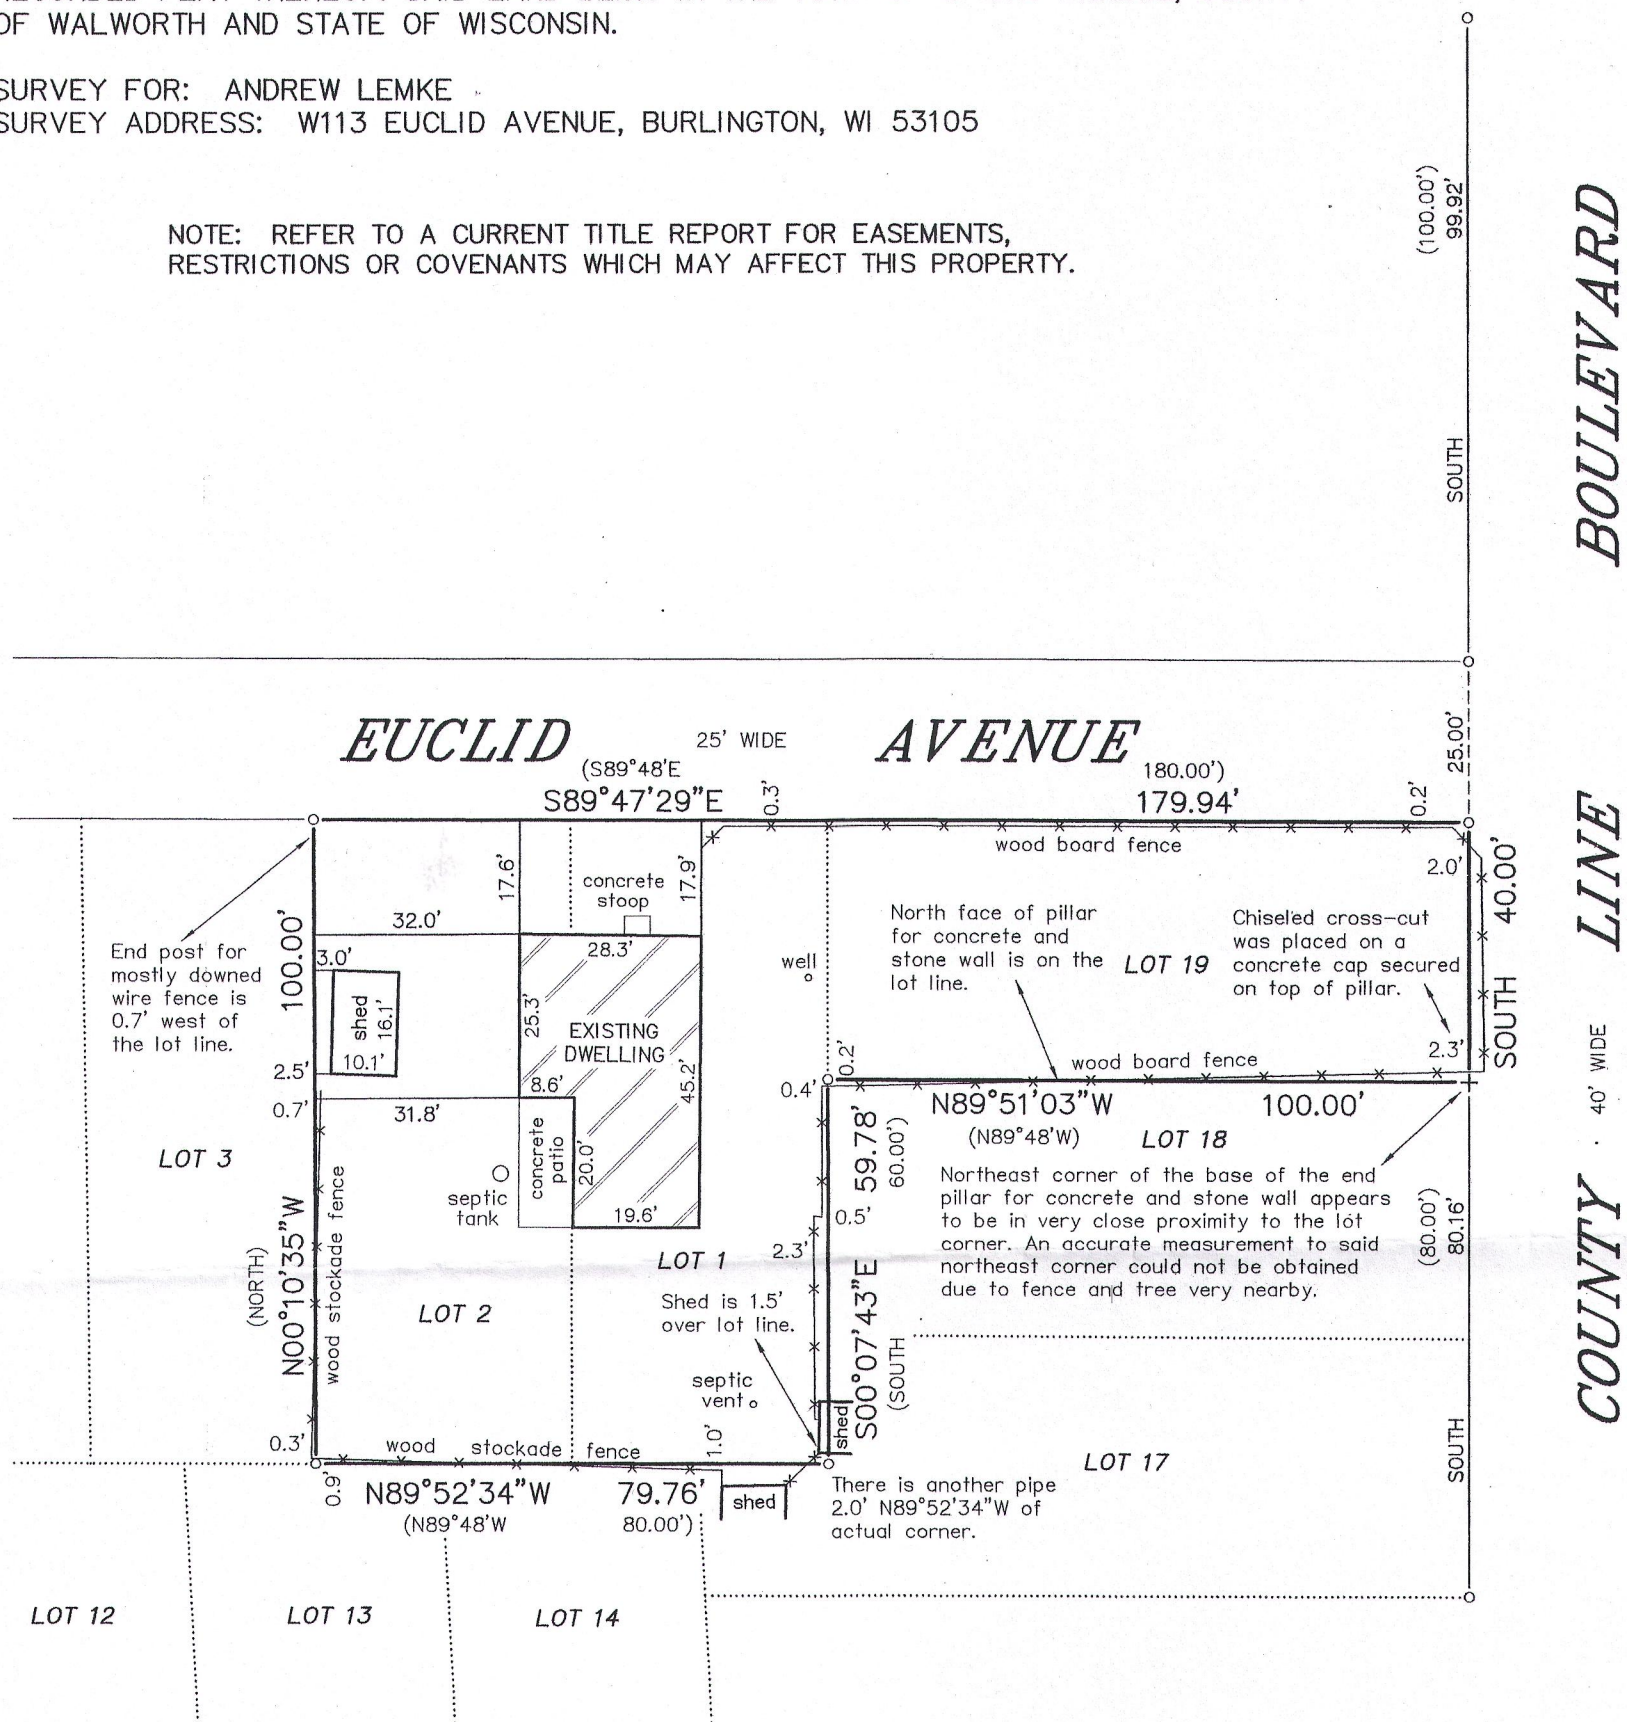

LEGEND


- FOUND IRON PIPE
- + SET CHISELED CROSS-CUT
- ( ) RECORDED AS

BEARINGS HEREON RELATE TO THE WEST  
RIGHT-OF-WAY LINE OF COUNTY LINE BOULEVARD.  
ASSUMED BEARING OF SOUTH AS PLATTED.



"I HEREBY CERTIFY THAT I HAVE SURVEYED THE ABOVE  
DESCRIBED PROPERTY AND THAT THE ABOVE MAP IS A CORRECT  
REPRESENTATION THEREOF AND SHOWS THE SIZE AND LOCATION  
OF THE PROPERTY, ITS EXTERIOR BOUNDARIES, THE LOCATION  
OF ALL VISIBLE STRUCTURES AND DIMENSIONS OF ALL  
PRINCIPAL BUILDINGS THEREON, BOUNDARY FENCES, APPARENT  
EASEMENTS, ROADWAYS AND ENCROACHMENTS, IF ANY."

"THIS SURVEY IS MADE FOR THE USE OF THE PRESENT OWNERS  
OF THE PROPERTY, AND THOSE WHO PURCHASE, MORTGAGE, OR  
GUARANTEE THE TITLE THERETO WITHIN ONE YEAR FROM DATE  
HEREOF."

**SATTER SURVEYING, LLC**  
LAND SURVEYS, MAPPING AND PLANNING  
272 ORIGIN STREET  
BURLINGTON, WI 53105  
262-661-4239

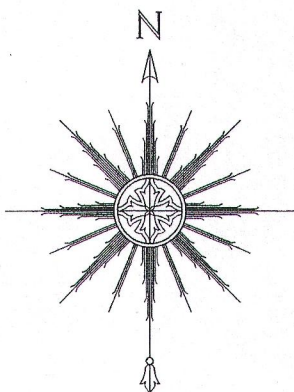

0 15' 30' 60'  
SCALE: 1" = 30'

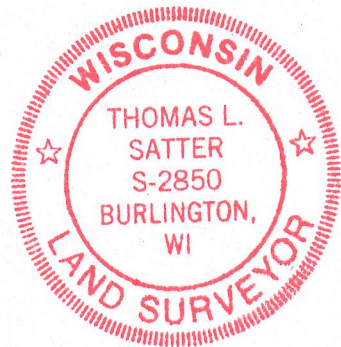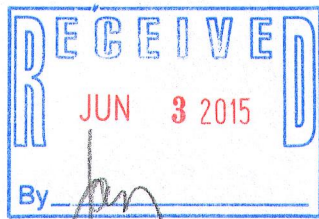

THIS IS NOT AN ORIGINAL PRINT  
UNLESS THIS SEAL IS RED.

Thomas L. Satter  
THOMAS L. SATTER S-2850

MAY 14, 2015  
DATE

041518  
JOB NUMBER

OHL-4  
OHL-13

318-1179