

North 1/4 Corner
Section 27-3-18
(concrete monument)

Spring Prairie Road

N89°34'16"E
200.00'

63.27'

Scale
1" = 60'



denotes iron
pipe

578.60'
N01°03'54"W

545.60'

62.76'

foundation
only
SEE
DETAIL

70.62'


579.07'
S01°03'54"E

546.07'

276.92'

200.01'
S89°42'18"W

DETAIL

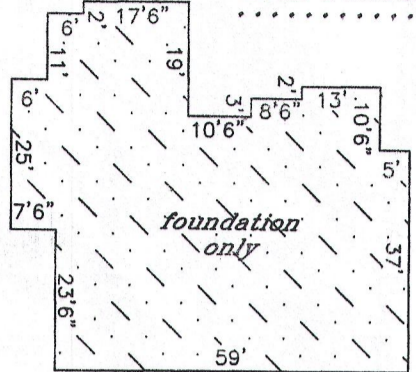

Proposed building field staked true size. Contractor to verify all dimensions before building by same and adhere to drainage plan in effect for this subdivision. Refer to a current title report for easements or restrictions which may affect the use of this site that are not shown on the recorded certified survey map.

tax key no.: 0A 4588 00001

J.K.R. SURVEYING, INC.
8121 22ND AVENUE
KENOSHA, WI 53143



I hereby certify that
this property was
surveyed under my
direction and this
plat is a true re-
presentation thereof.

[Signature]

Reg. Land Surveyor
May 13, 2016
Revised 8/12/16

Plat of Survey of

LOT 1 OF

CERTIFIED SURVEY MAP NO. 4588

in NE1/4 Section 27-3-18

TOWN OF SPRING PRAIRIE
WALWORTH COUNTY, WIS.

-for-
Harpe Development

004588-1 218-1210