



PLAT OF SURVEY
-OF-

LOTS 1, 22, AND 23, BLOCK 14, HONEY LAKE SUBDIVISION FIRST ADDITION, BEING A SUBDIVISION OF A PART OF THE SOUTHEAST 1/4 OF SECTION 13, TOWNSHIP 3 NORTH, RANGE 18 EAST IN THE TOWN OF SPRING PRAIRIE, COUNTY OF WALWORTH, STATE OF WISCONSIN.

SURVEY FOR: LAUREL SCHNEIDER
SURVEY OF: N6206 CRESCENT PLACE

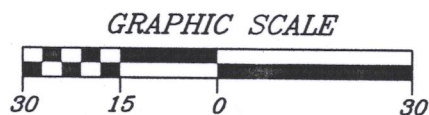



SCALE: 1" = 30'

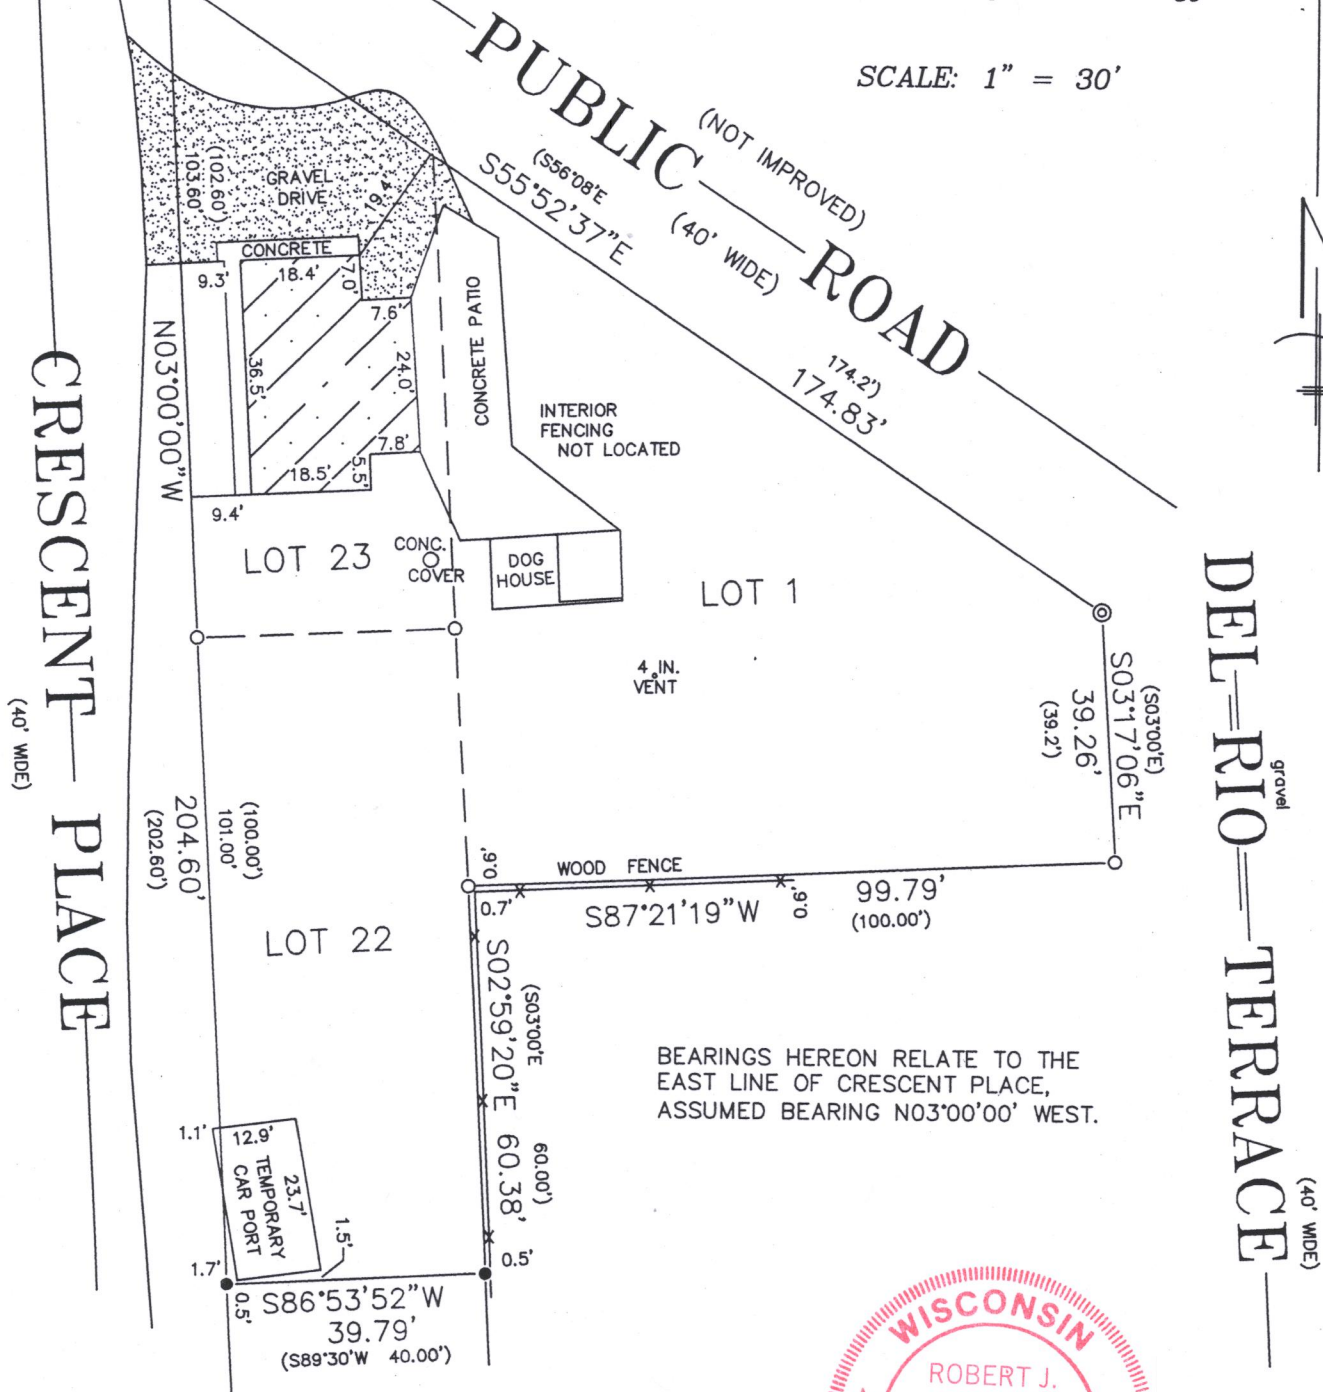

BEARINGS HEREON RELATE TO THE
EAST LINE OF CRESCENT PLACE,
ASSUMED BEARING N03°00'00" WEST.

"I hereby certify that I have surveyed the above described property and that the above map is a correct representation thereof and shows the size and location of the property, its exterior boundaries, the location of all visible structures and dimensions of all principal buildings thereon, boundary fences, apparent easements, roadways and encroachments, if any."

"This survey is made for the use of the present owners of the property, and those who purchase, mortgage, or guarantee the title thereto within one year from date hereof."

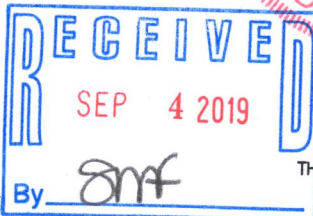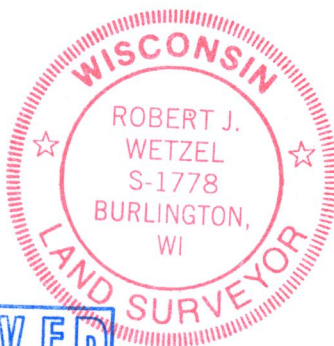

THIS IS NOT AN ORIGINAL PRINT
UNLESS THIS SEAL IS RED.

Robert J. Wetzel
ROBERT J. WETZEL S-1778

JULY 15, 2019
DATE

9907
JOB NUMBER

B.W. SURVEYING

412 N. PINE STREET
BURLINGTON, WI 53105
(414)-767-0225



OHL1-112

318-1310