PLAT OF SURVEY


LOCATION:

Aspen Drive, Spring Prairie, Wisconsin

LEGAL DESCRIPTION: Lot 4 in PLEASANT HILL SUBDIVISION, being a Subdivision located in the Northeast 1/4 of Section 22, Town 3 North, Range 18 East, in the City Spring Prairie, Walworth County, Wisconsin.

March 26, 2020

Survey No. 109465-B

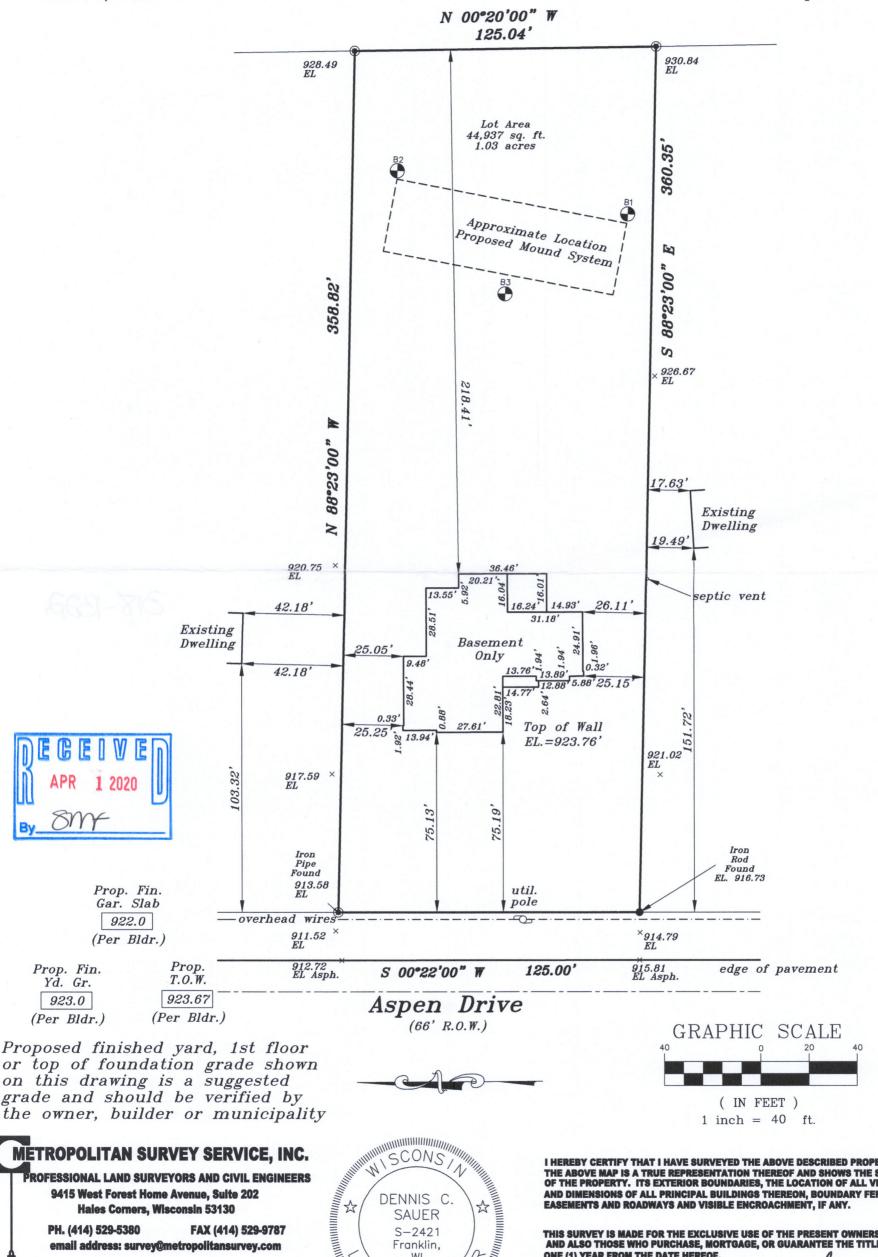

MISCONS

METROPOLITAN SURVEY SERVICE, INC.

PROFESSIONAL LAND SURVEYORS AND CIVIL ENGINEERS 9415 West Forest Home Avenue, Suite 202 Hales Corners, Wisconsin 53130

PH. (414) 529-5380 FAX (414) 529-9787 email address: survey@metropolitansurvey.com

- — Denotes Iron Pipe Found
- — Denotes Iron Rod Found

000.0 - Denotes Proposed Grade

Fra. WI SURVE

I HEREBY CERTIFY THAT I HAVE SURVEYED THE ABOVE DESCRIBED PROPERTY AND THAT THE ABOVE MAP IS A TRUE REPRESENTATION THEREOF AND SHOWS THE SIZE AND LOCATION OF THE PROPERTY. ITS EXTERIOR BOUNDARIES, THE LOCATION OF ALL VISIBLE STRUCTURES AND DIMENSIONS OF ALL PRINCIPAL BUILDINGS THEREON, BOUNDARY FENCES, APPARENT EASEMENTS AND ROADWAYS AND VISIBLE ENCROACHMENT, IF ANY.

THIS SURVEY IS MADE FOR THE EXCLUSIVE USE OF THE PRESENT OWNERS OF THE PROPERTY, AND ALSO THOSE WHO PURCHASE, MORTGAGE, OR GUARANTEE THE TITLE THERETO WITHIN ONE (1) YEAR FROM THE DATE HEREOF.

SIGNED

Dennis C. Sauer Professional Land Surveyor S-2421

Denotes Proposed Silt Screen