


THE SOUTH LINE OF THE NORTHEAST 1/2 OF LOT 5, AND THE SOUTHWEST LINE OF LOTS 1 AND 2, BLOCK 19, AND ALSO THE SOUTHWEST 1/2 OF LOT 5, AND THE SOUTHWEST LINE OF LOTS 1 AND 2, BLOCK 23, OF HONEY LAKE FIRST ADDITION. A SUBDIVISION OF PART OF THE SOUTHEAST 1/4 OF SEC. 13, T. 3 N., R. 18 E., WAINWORTH COUNTY, WISCONSIN.

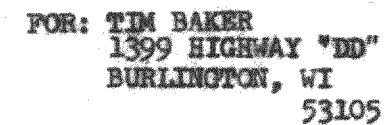

● = CONCRETE MONUMENT FOUND
 Ø = IRON PIPE STAKE FOUND
 ○ = IRON PIPE STAKE SET

I HEREBY CERTIFY THAT THE LINES DESCRIBED ABOVE WERE SURVEYED UNDER MY DIRECTION AND THAT THE PLAT DRAWN HEREON IS A CORRECT REPRESENTATION OF SAID SURVEY.

SURVEY.
John F. Degen 8-19-82.
JOHN F. DEGEN, LAND SURVEYOR #242
589 N. PINE ST., BURLINGTON, WI

318-226

12 D #15