
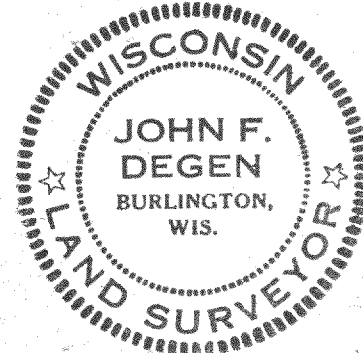


PLAT OF  
OF

THE SOUTH LINE OF THE NORTHEAST 1/2 OF LOT 5, AND THE SOUTHWEST LINE OF LOTS 1 AND 2, BLOCK 19,  
AND ALSO THE SOUTHWEST 1/2 OF LOT 5, AND THE SOUTHWEST LINE OF LOTS 1 AND 2, BLOCK 23, OF HONEY  
LAKE FIRST ADDITION. A SUBDIVISION OF PART OF THE SOUTHEAST 1/4 OF SEC. 13, T. 3 N., R. 18 E.,  
WAINWORTH COUNTY, WISCONSIN.

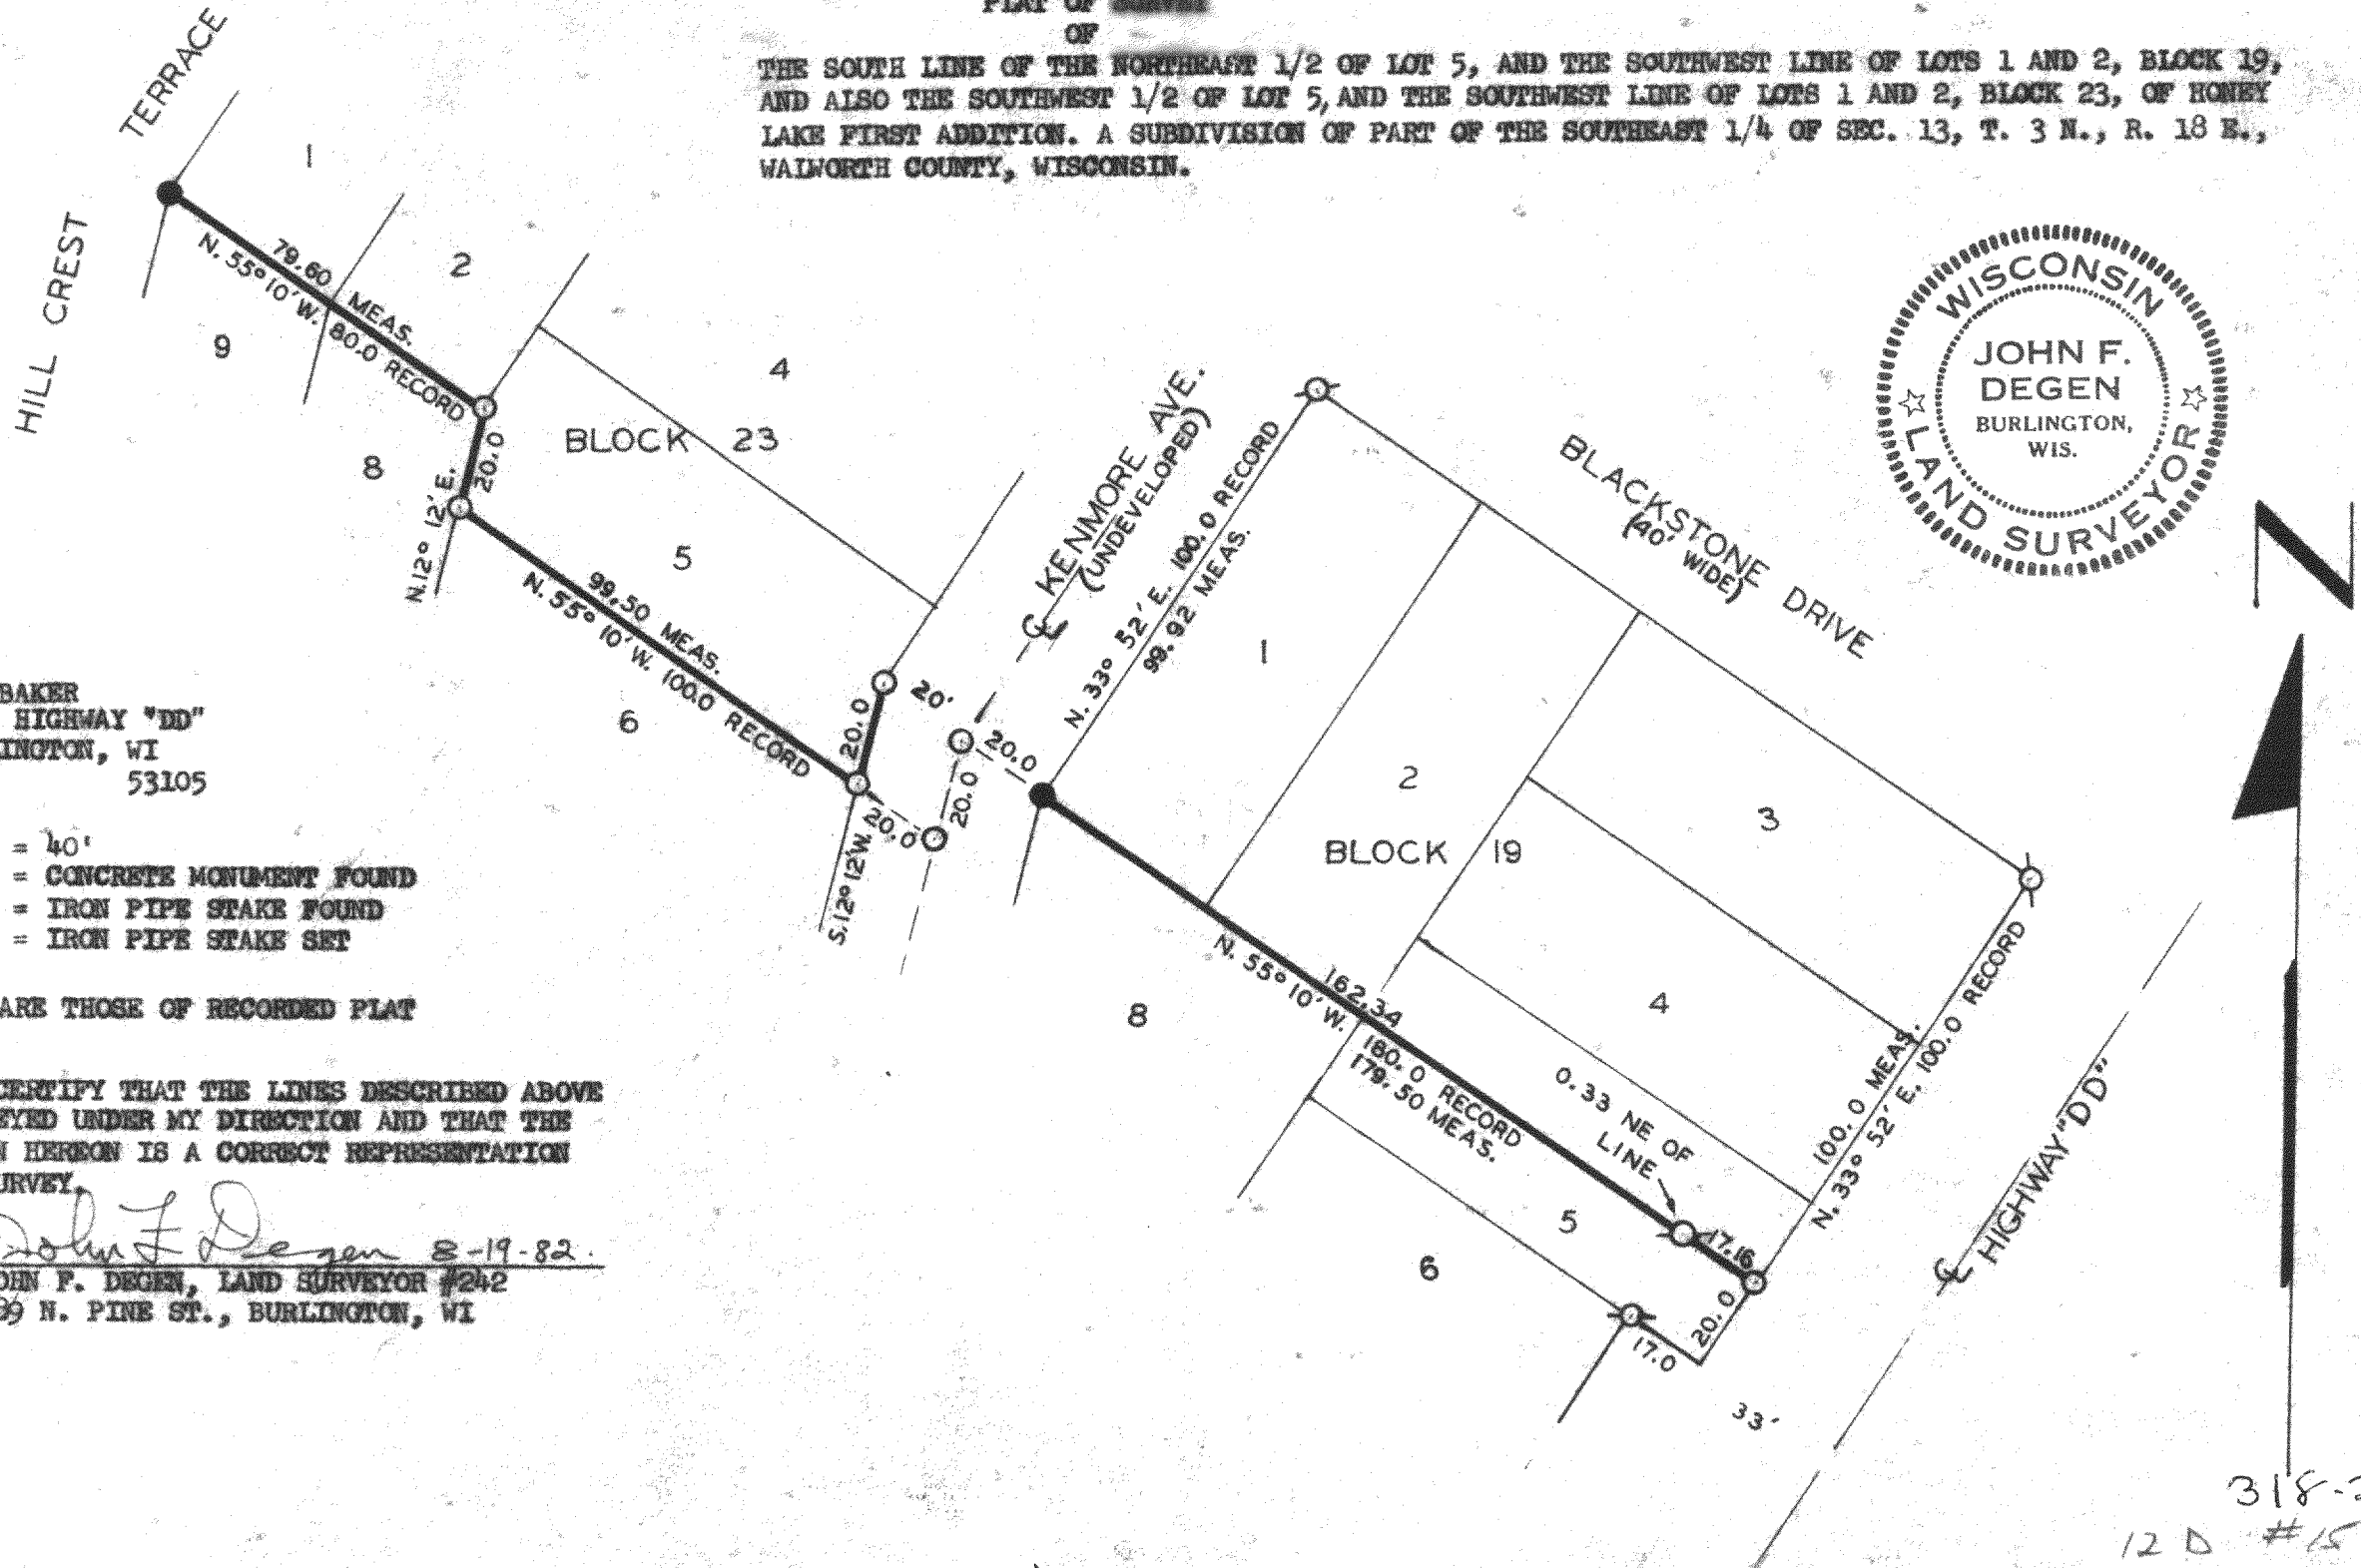

FOR: TIM BAKER  
1399 HIGHWAY "DD"  
BURLINGTON, WI  
53105

SCALE: 1" = 40'  
● = CONCRETE MONUMENT FOUND  
♂ = IRON PIPE STAKE FOUND  
○ = IRON PIPE STAKE SET

BEARINGS ARE THOSE OF RECORDED PLAT

I HEREBY CERTIFY THAT THE LINES DESCRIBED ABOVE  
WERE SURVEYED UNDER MY DIRECTION AND THAT THE  
PLAT DRAWN HEREON IS A CORRECT REPRESENTATION  
OF SAID SURVEY.

*John F. Degen* 8-19-82.  
JOHN F. DEGEN, LAND SURVEYOR #242  
589 N. PINE ST., BURLINGTON, WI

318-226  
12 D #15