


Plat of Survey

FOR: FIRST BANK & TRUST - RIGGS

DESCRIPTION: Lot 1, Pleasant Hill Subdivision, a subdivision located in NE 1/4 of Section 22, T.3N., R.18E., Walworth County, Wisconsin.

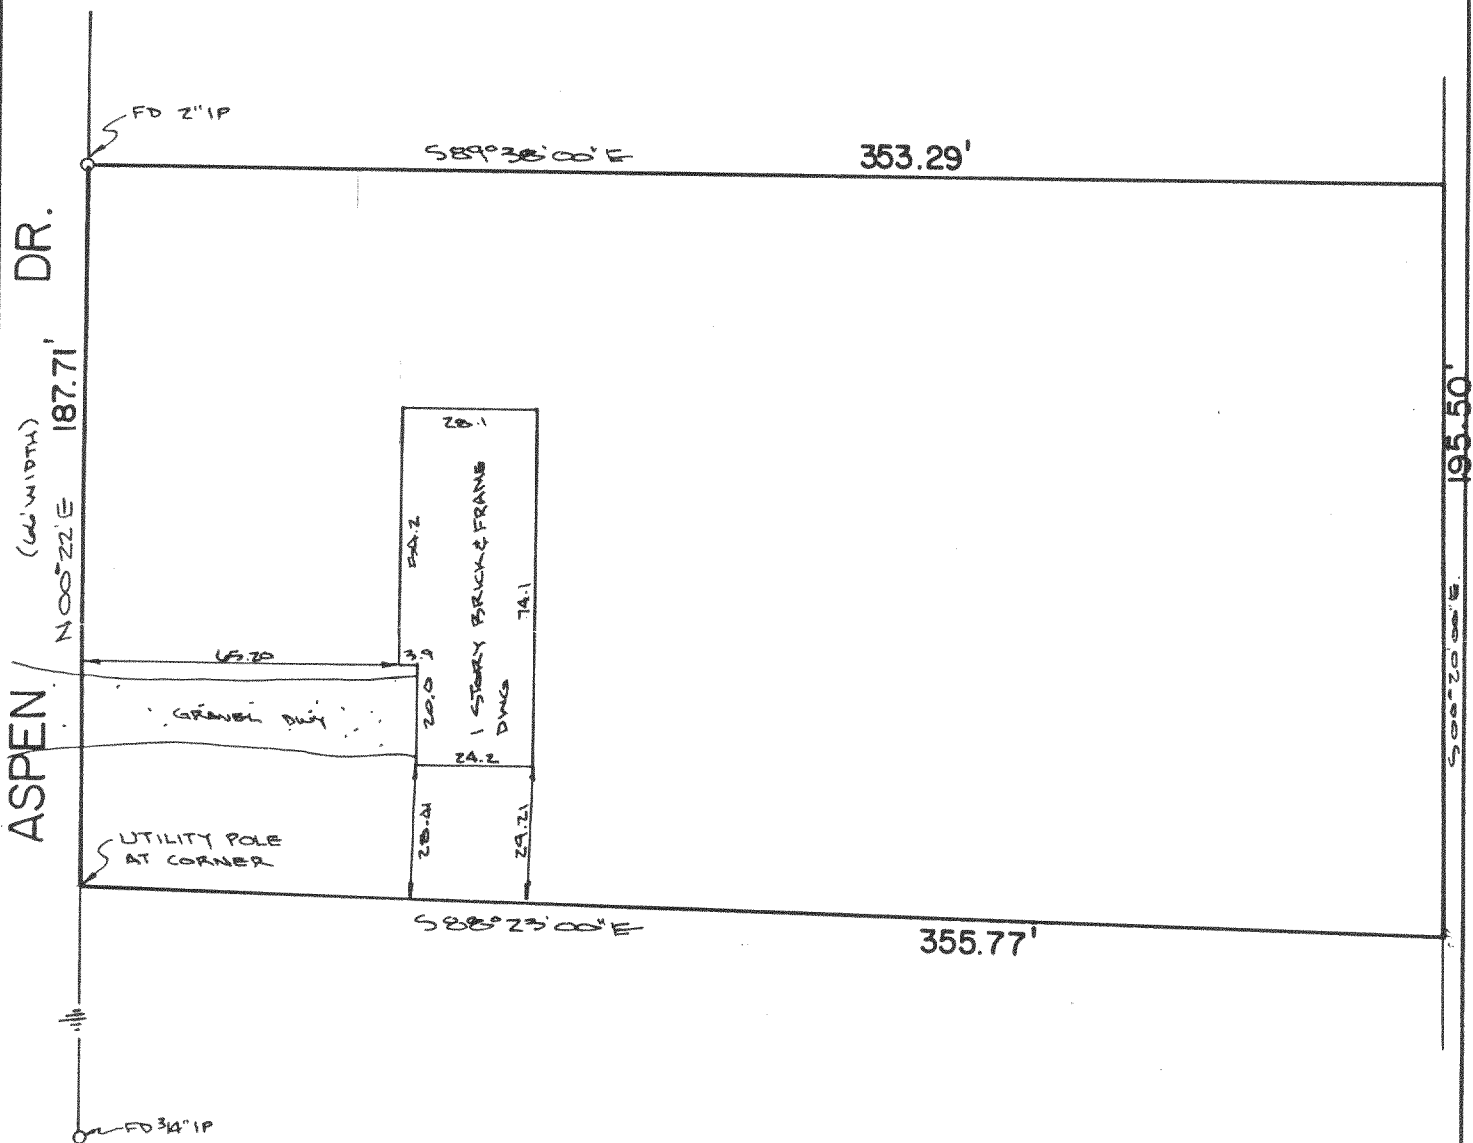

☒ — MONUMENTATION OF MISSING BOUNDARY CORNERS HAS BEEN WAIVED BY 1ST BANK & TRUST AS PER CHAPTER A-E5 OF THE WISCONSIN ADMINISTRATIVE CODE.

STATE OF WISCONSIN)
WAUKESHA COUNTY) SS

CERTIFICATE

I CERTIFY THAT I HAVE SURVEYED THE ABOVE DESCRIBED PROPERTY, AND THE ABOVE MAP ITS A TRUE REPRESENTATION THEREOF AND SHOWS THE SIZE AND LOCATION OF THE PROPERTY, ITS EXTERIOR BOUNDARIES, THE LOCATION AND DIMENSIONS OF ALL STRUCTURES THEREON, FENCES, APPARENT EASEMENTS AND ROADWAYS AND VISIBLE ENCROACHMENTS, IF ANY.
THIS SURVEY IS MADE FOR THE EXCLUSIVE USE OF THE PRESENT OWNERS OF THE PROPERTY, AND ALSO THOSE WHO PURCHASE, MORTGAGE, OR GUARANTEE THE TITLE THERETO, WITHIN ONE (1) YEAR FROM DATE HEREOF.


REGISTERED LAND SURVEYOR

DATE

TERRA TECHnology

PLANNING • ENGINEERING • SURVEYING

1700 E. RACINE AVENUE
WAUKESHA, WI 53186
414-544-1111

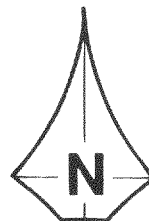

SCALE: 1" = 50'

DRAFTED BY:

CHECKED BY:

FIELD BOOK: 4/51

JOB NUMBER: 2644

OPH-1

318-254