

Plat of Survey

FOR: REPUBLIC SAVINGS AND LOAN ASSOCIATION - MARTIN, WILLIAM

DESCRIPTION: Lot 9, Block 7, Lots 1, 2 and 11, Block 12, Honey Lake Subdivision, First Addition, located in Section 13, T3N, R18E, Town of Spring Prairie, Walworth County, Wisconsin.



☒ — MONUMENTATION OF MISSING BOUNDARY CORNERS HAS BEEN WAIVED BY Republic AS PER CHAPTER A-ES OF THE WISCONSIN ADMINISTRATIVE CODE.



CERTIFICATE

STATE OF WISCONSIN)
WAUKESHA COUNTY) SS

I CERTIFY THAT I HAVE SURVEYED THE ABOVE DESCRIBED PROPERTY, AND THE ABOVE MAP IS A TRUE REPRESENTATION THEREOF AND SHOWS THE SIZE AND LOCATION OF THE PROPERTY, ITS EXTERIOR BOUNDARIES, THE LOCATION AND DIMENSIONS OF ALL STRUCTURES THEREON, FENCES, APPARENT EASEMENTS AND ROADWAYS AND VISIBLE ENCROACHMENTS, IF ANY.
THIS SURVEY IS MADE FOR THE EXCLUSIVE USE OF THE PRESENT OWNERS OF THE PROPERTY, AND ALSO THOSE WHO PURCHASE, MORTGAGE, OR GUARANTEE THE TITLE THERETO, WITHIN ONE (1) YEAR FROM DATE HEREOF.

REGISTERED LAND SURVEYOR

DATE

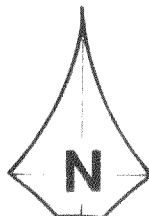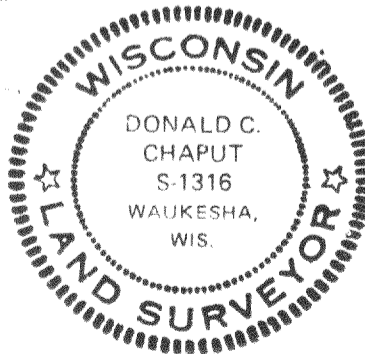

SCALE 1"=60'

The Cornerstone Group, Inc.
PLANNING • ENGINEERING • SURVEYING
1700 E. RACINE AVENUE
WAUKESHA, WI 53186
414-544-1111

DRAFTED BY: JMT

CHECKED BY: DCC

FIELD BOOK: 4-12

JOB NUMBER: 2532 318-255

041147, 86, 908