


PLAT OF SURVEY  
-OF-



LOTS 1, 2, 3 & 4, BLOCK 9, HONEY LAKE SUBDIVISION 1ST ADDITION, being part of the Southeast 1/4 of Section 13, Township 3 North, Range 18 East in the Town of Spring Prairie, Walworth County, Wisconsin.

Survey For: Dean LaMeer  
Survey Location: 277 Potter Road

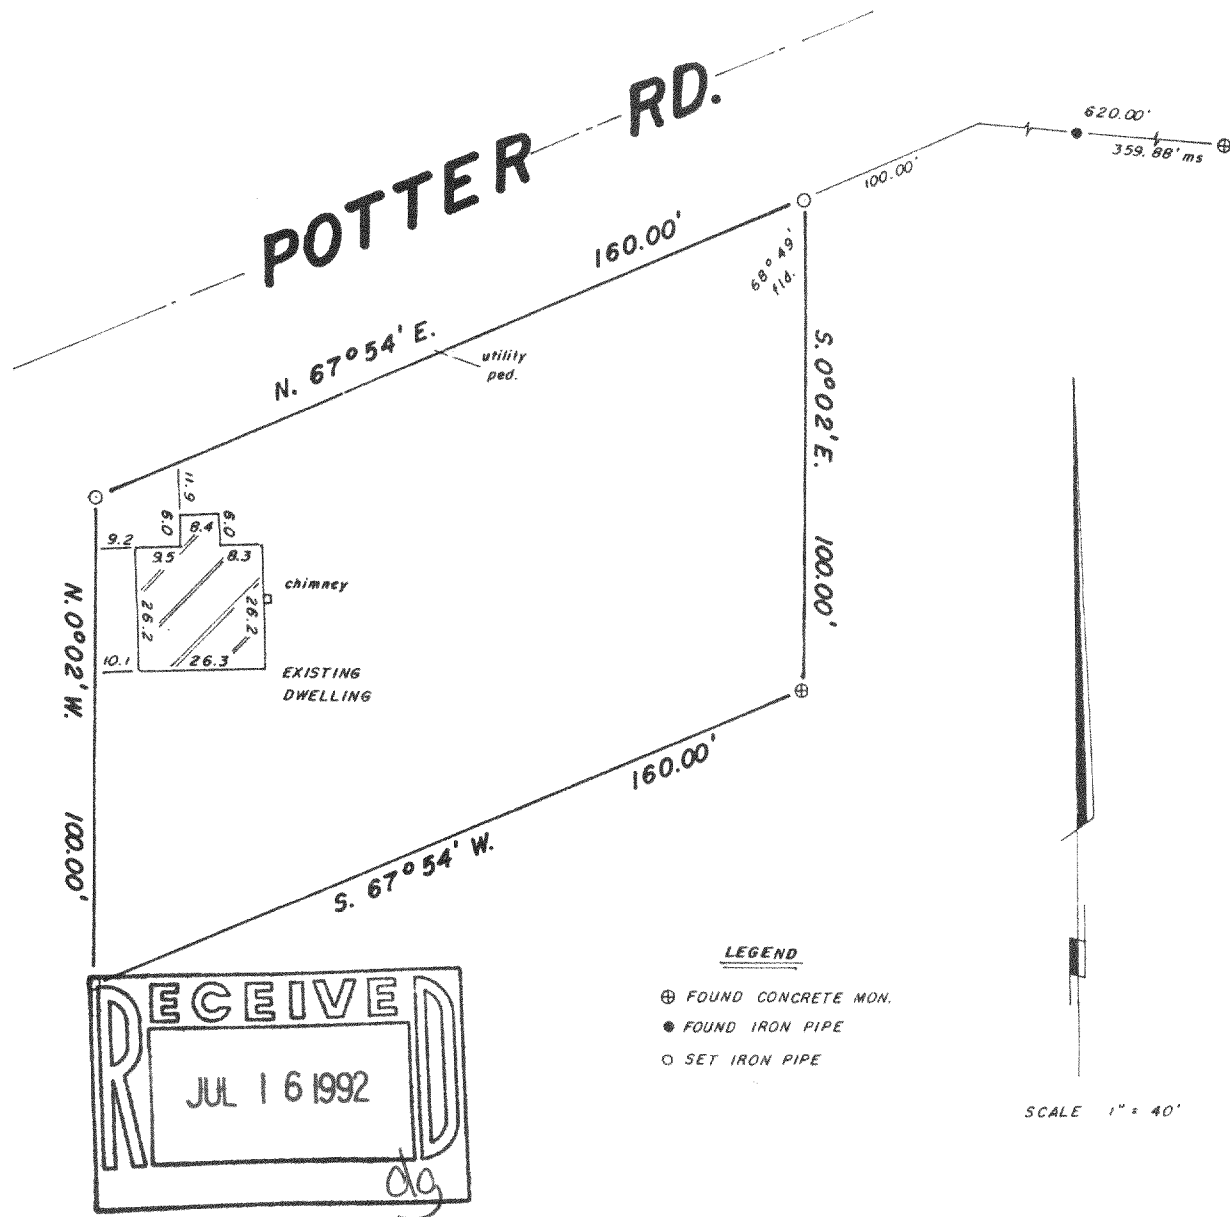

**B.W. SURVEYING**

Land Surveys  
Mapping And Planning  
35117 Academy Road  
Burlington, Wisconsin 53105  
(414) 534-4109

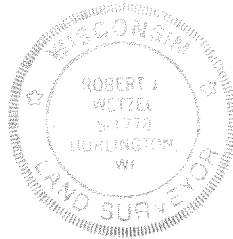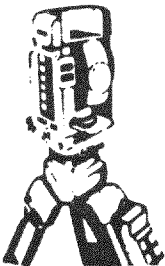

THIS IS NOT AN ORIGINAL PRINT  
UNLESS THIS SEAL IS RED

*Robert J. Wetzel*  
ROBERT J. WETZEL  
REGISTERED LAND SURVEYOR - 1778

"This survey is made for the use of the present owners of the property, and those who purchase, mortgage, or guarantee the title thereto within one year from date hereof"

JUNE 1, 1992  
DATE

919  
JOB NUMBER

318-382

0441-61 0441-63  
0441-62