


PLAT OF SURVEY

LEGAL DESCRIPTION
Lot 2 of Certified Survey Map Number 1999,
as recorded in Volume 9 of Certified Survey
Maps as Pages 277 and 278 as Document
Number 206054, Being located in the
Northeast 1/4 of Section 22, Town 3 North,
Range 18 East, Town of Spring Prairie,
County of Walworth, State of Wisconsin.

ORDERED BY: DAN FINKE CONSTRUCTION
5870 HWY "36"
BURLINGTON, WI. 53105

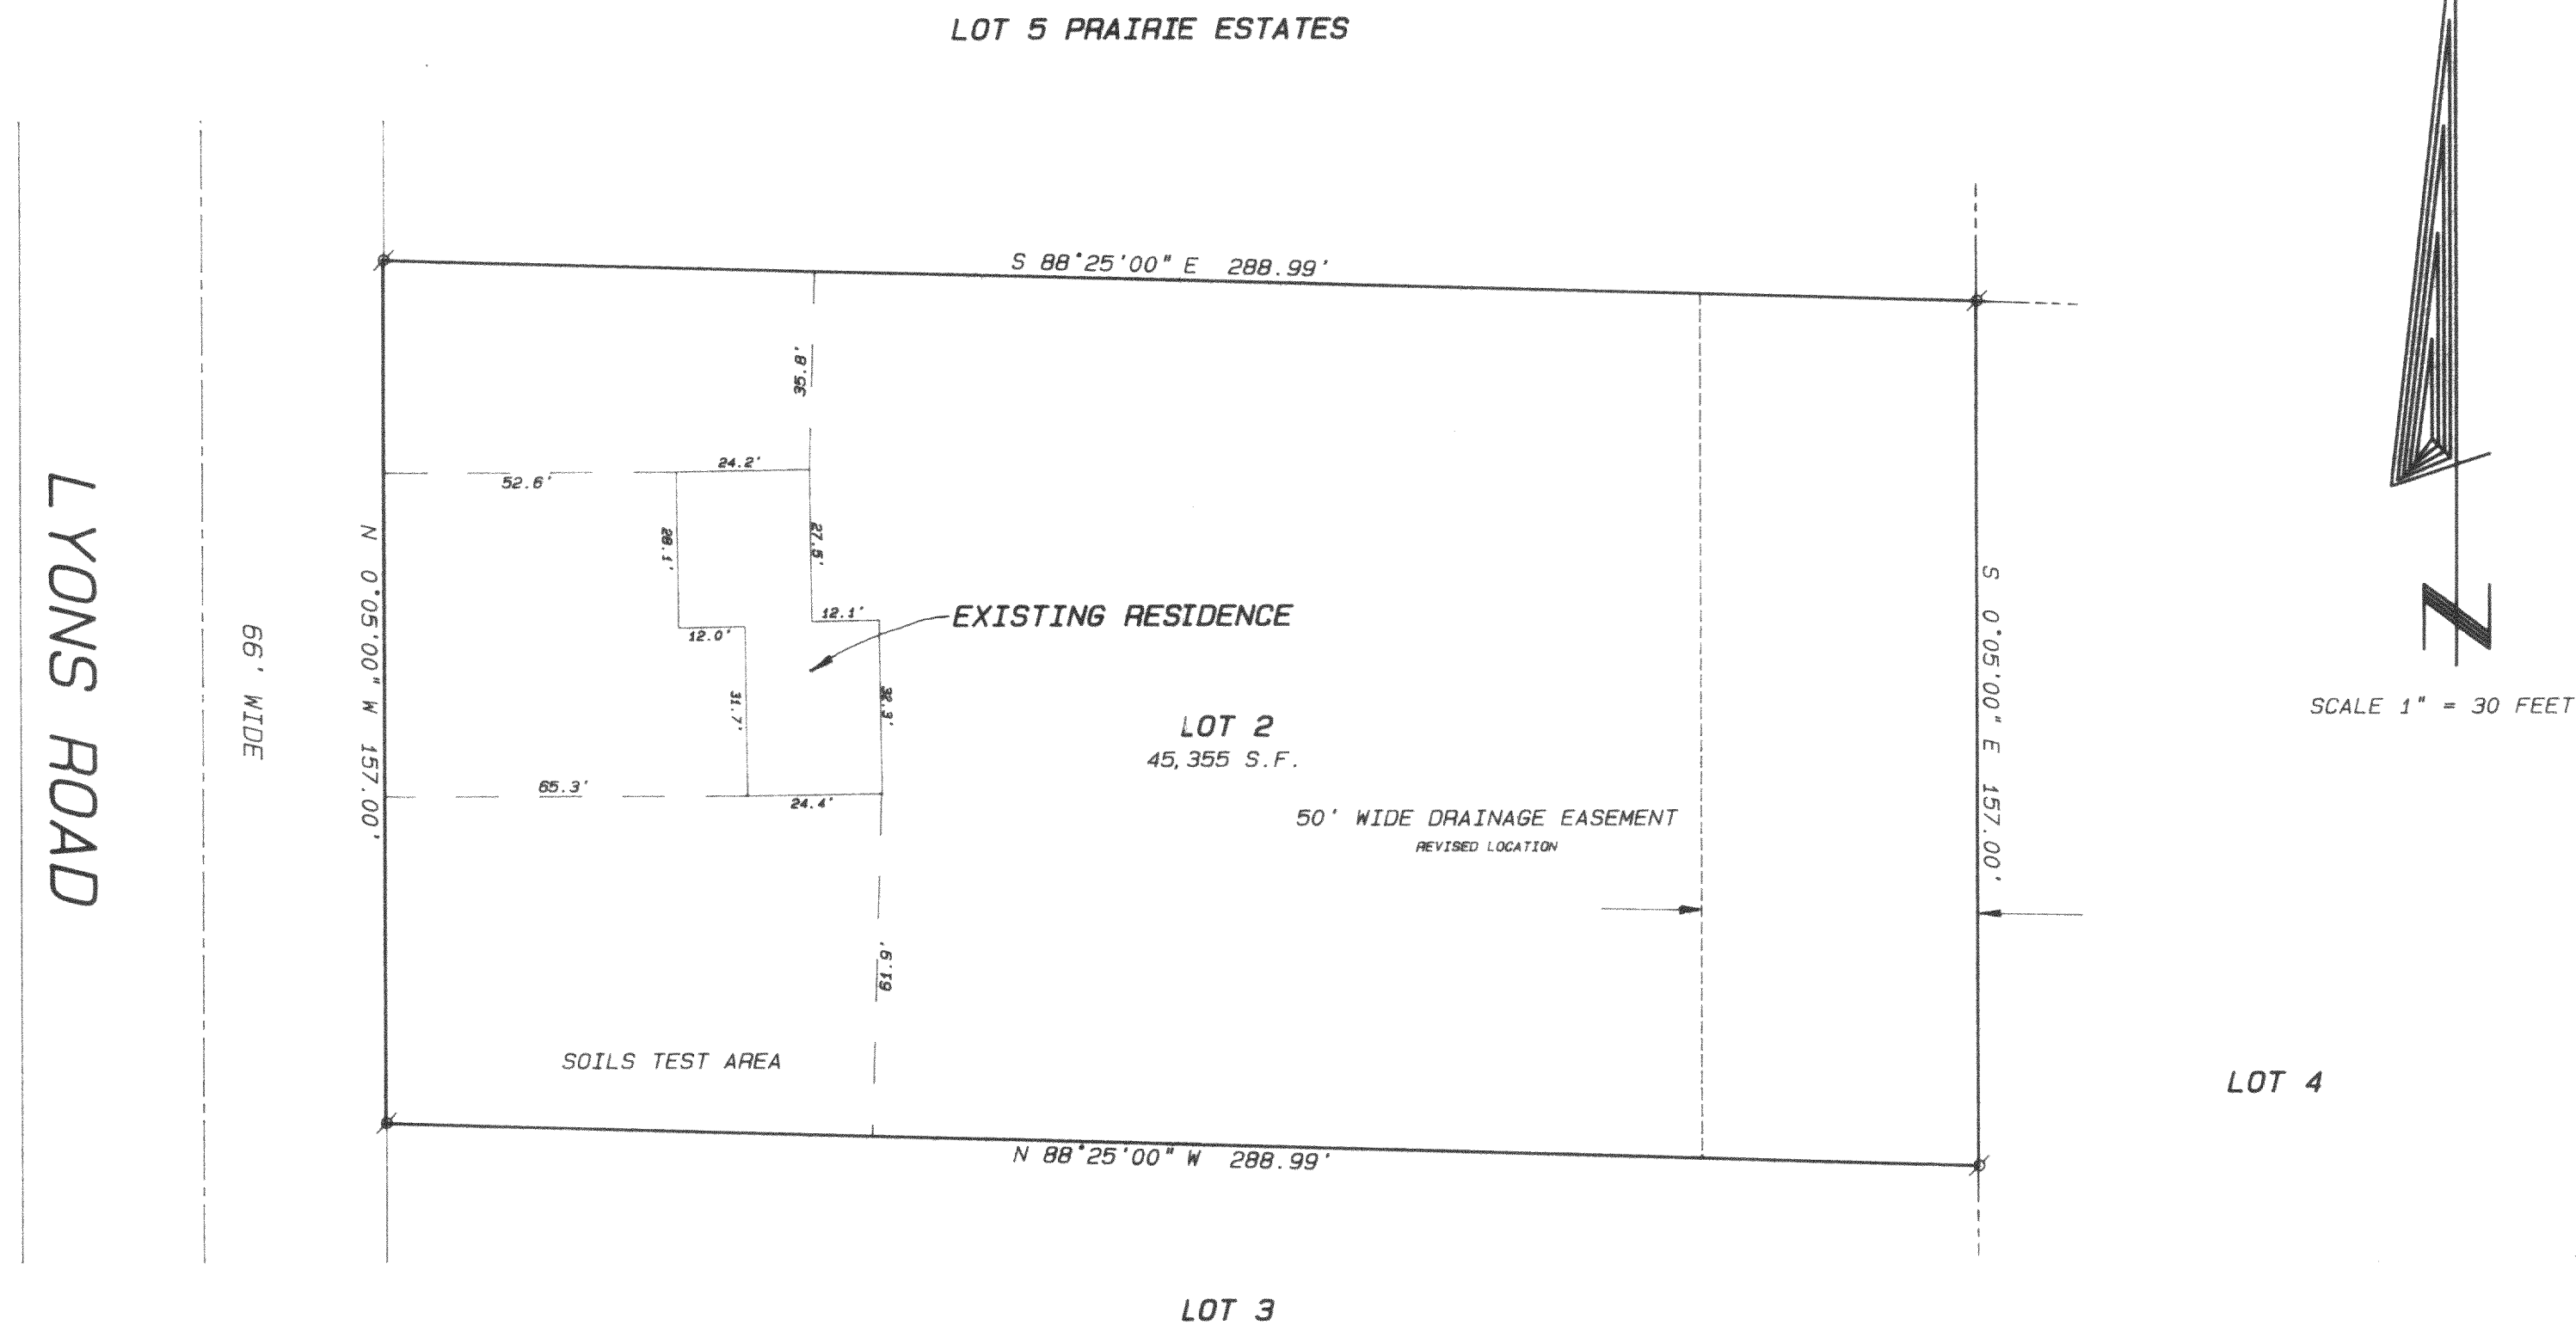

I hereby certify that I have surveyed the above described property and that the above map is a true representation thereof and shows the size and location of the property, its exterior boundaries, the location of all visible structures and dimensions of all principal buildings thereon, boundary fences, apparent easements, roadways and visible encroachments, if any.

This survey is made for the use of the present owners of the property, and also those who purchase, mortgage, or guarantee the title thereto within one year from date hereof.

Kenneth B. Abernathy, Jr.
KENNETH B. ABERNATHY, JR.
WISCONSIN REGISTERED LAND SURVEYOR,
S-1594

Date: April 23, 1992 Job No. 1992.109

ABERNATHY and ASSOCIATES

Kenneth B. Abernathy Jr.

Wisconsin Registered Land Surveyor S-1594

Rt. 3, Box 273
Elkhorn, Wisconsin 53121
Phone: (414) 723-4260 (office)
(414) 723-4813 (residence)


PLAT OF SURVEY

LOT 2 OF CERTIFIED SURVEY MAP NO. 1999 AS
RECORDED IN VOL. 9 OF CERTIFIED SURVEY MAPS
AS PAGES 277 AND 278 AS DOCUMENT NO.
206054, BEING LOCATED IN THE NORTHEAST 1/4
OF SECTION 22, TOWN 3 NORTH, RANGE 18 EAST,
WALWORTH COUNTY, WISCONSIN.

ORDERED BY: DAN FINKE CONSTRUCTION
5870 HWY "36"
BURLINGTON, WI. 53105

LOT 5 PRAIRIE ESTATES


66' WIDE
LYONS ROAD

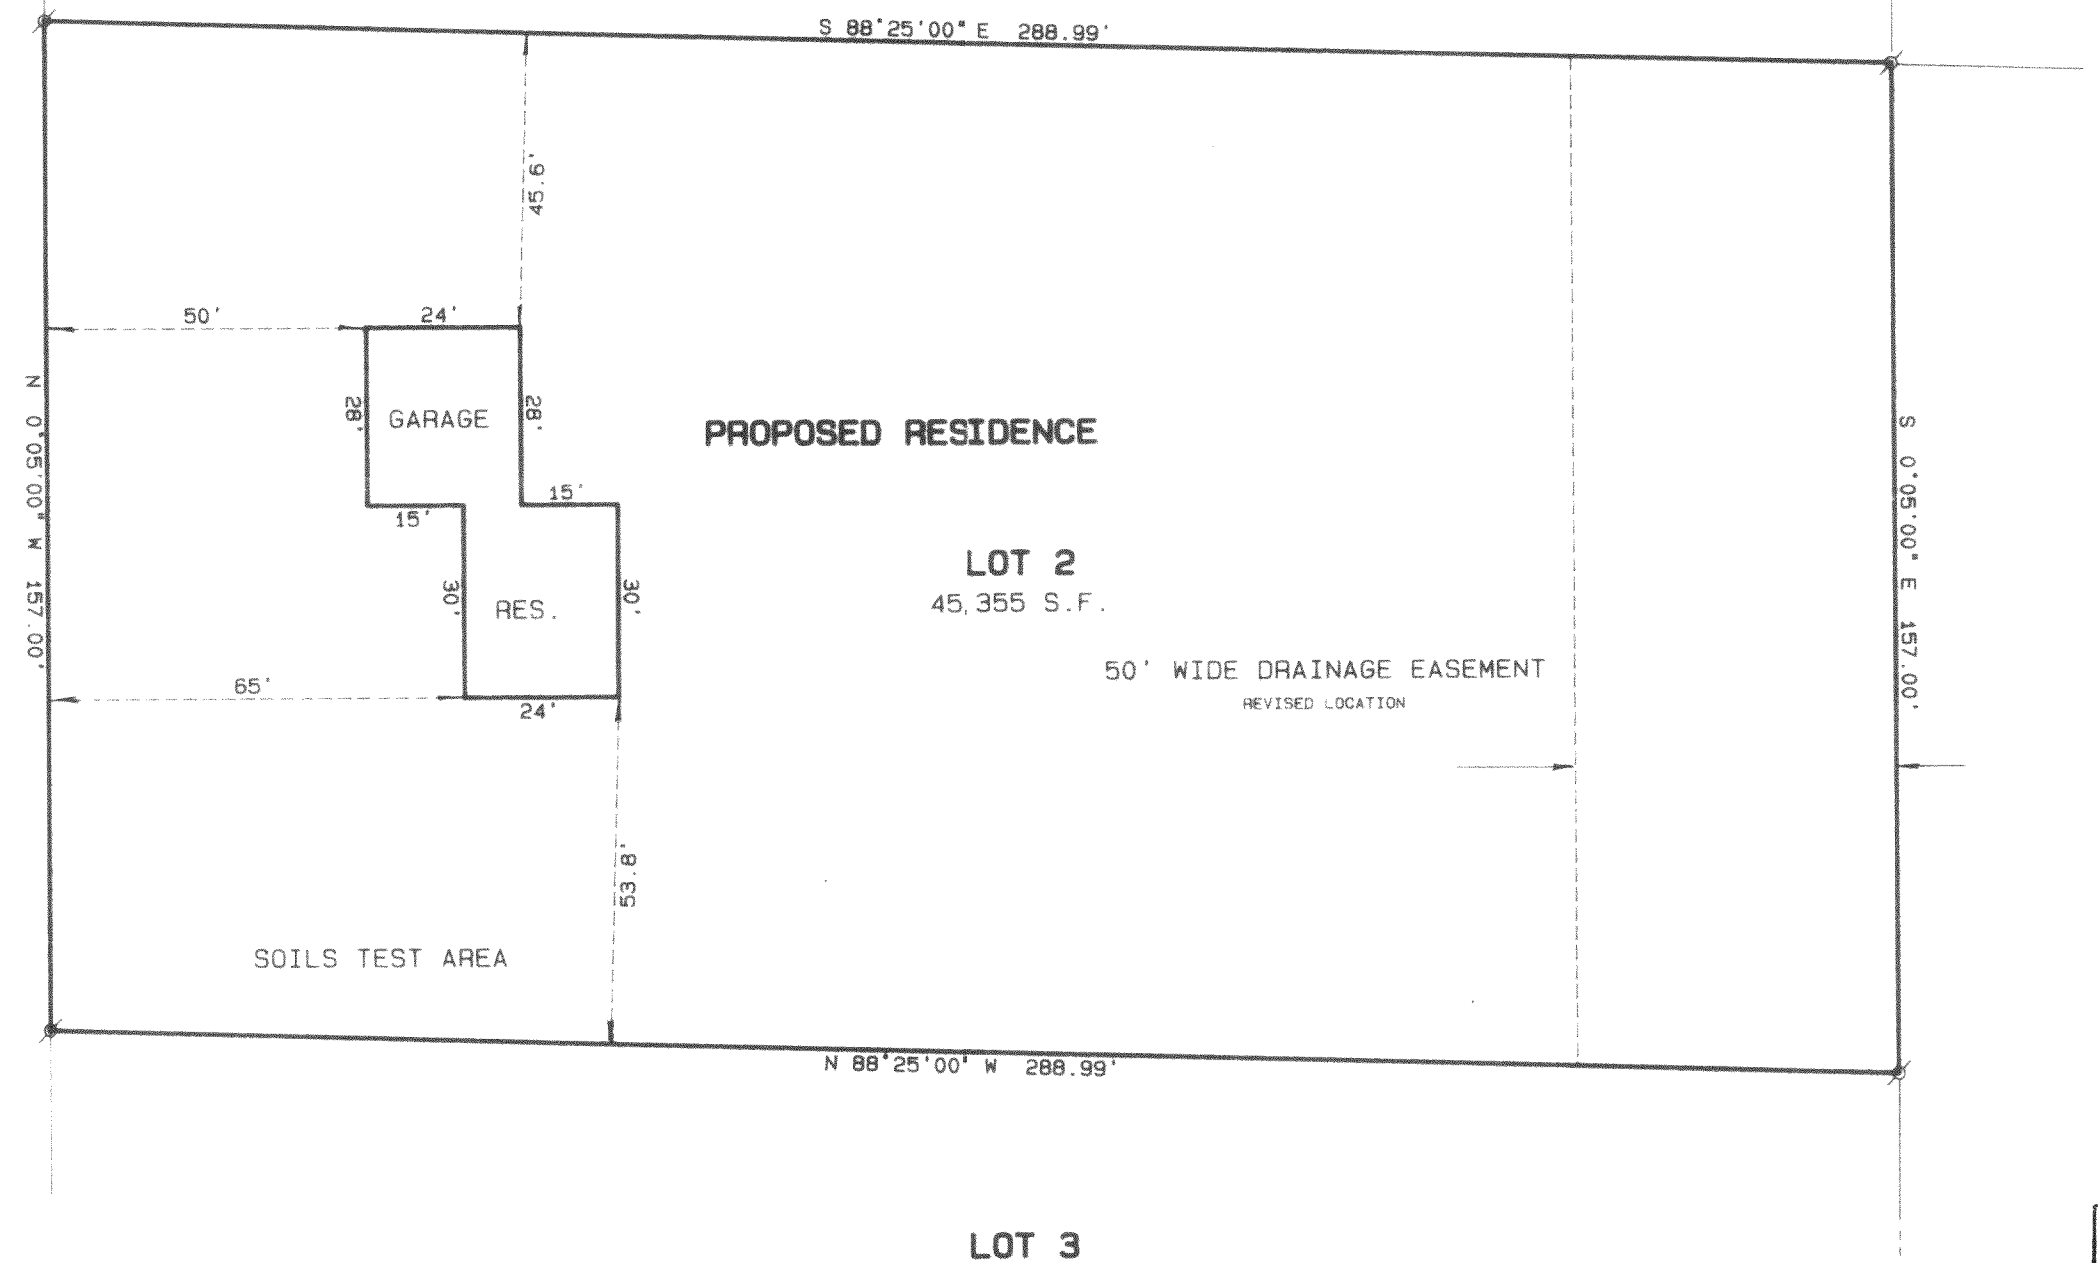

SCALE 1" = 30 FEET

Legend


- FOUND IRON PIPE
- FOUND IRON ROD
- FOUND BRASS CAPPED MONUMENT
- FOUND CONCRETE MONUMENT
- CHISEL CUT IN CONCRETE
- SET IRON ROD, 24" LONG, WEIGHING 1.5 LBS., LINEAL FT., 3/4" DIA.
- SET IRON ROD, 30" LONG, WEIGHING 4.5 LBS., LINEAL FT., 1-11/16" DIA.
- (xx) RECORDED AS DIMENSION
- EXISTING FENCE

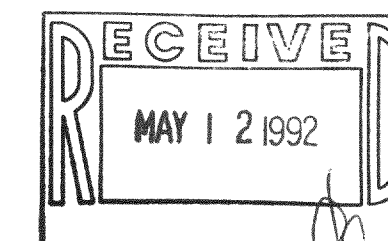

SCALE: 1" = 30 FEET

"I hereby certify that I have surveyed the above described property and that the above map is a true representation thereof and shows the size and location of the property, its exterior boundaries, the location of all visible structures and dimensions of all principal buildings thereon, boundary fences, apparent easements, roadways and visible encroachments, if any."

"This survey is made for the use of the present owners of the property, and also those who purchase, mortgage, or guarantee the title thereto within one year from date hereof."

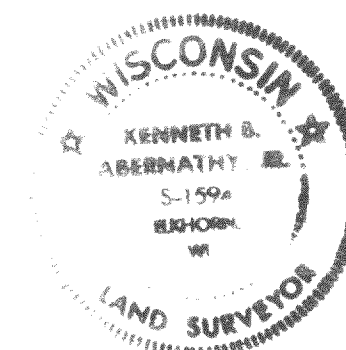

Kenneth B. Abernathy Jr.
KENNETH B. ABERNATHY, JR.
WISCONSIN REGISTERED LAND SURVEYOR,
S-1594

Date: FEB. 11, 1992 Job No. 92.109