


PLAT OF SURVEY
-OF-


THE WEST 40 FEET OF LOT 7, LOTS 8, 9, 10, 11 and 12, BLOCK 1, EXCEPTING THE EAST 14.54 FEET OF LOTS 11 and 12, and also EXCEPTING THE EAST 44.54 FEET OF LOT 10, BLOCK 1, HONEY LAKE SUBDIVISION, according to the recorded plat thereof. Said land being in the Town of Spring Prairie, County of Walworth and State of Wisconsin.

Survey For: Valley Bank
Survey Location: 1492 County Hwy. DD
Owner: Jerome Wehner

C.T.H. "DD"


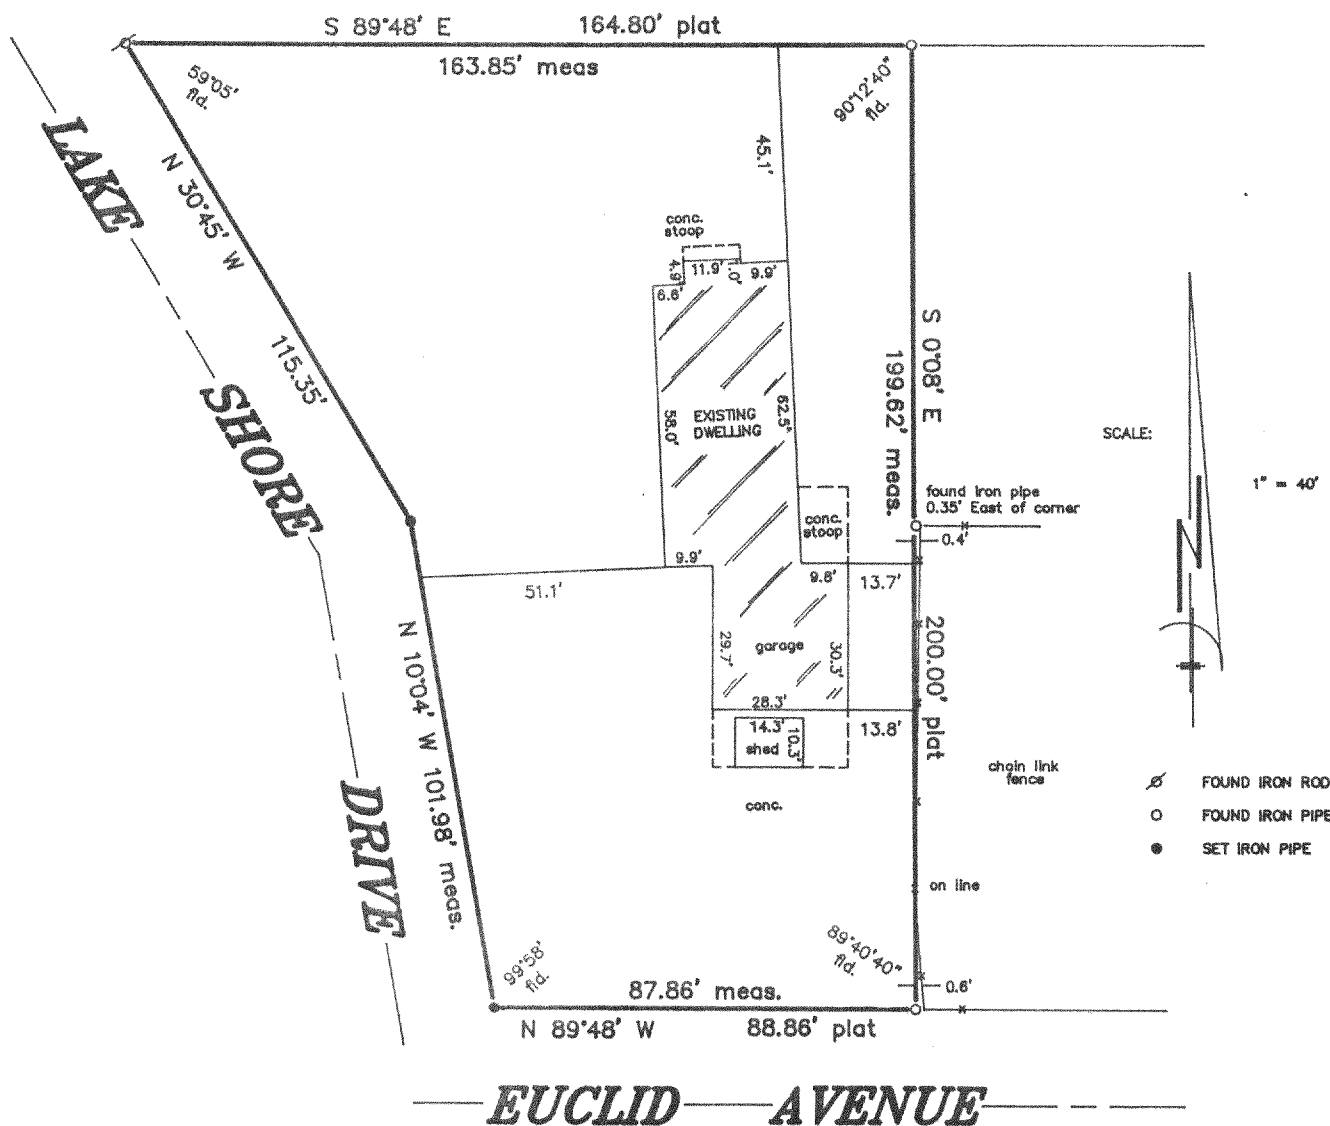


EUCLID AVENUE

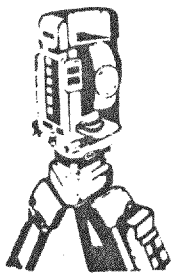

B.W. SURVEYING

Land Surveys
Mapping And Planning
35117 Academy Road
Burlington, Wisconsin 53105
(414) 534-4109

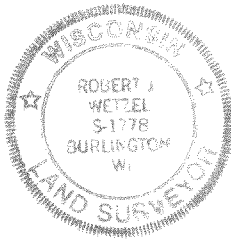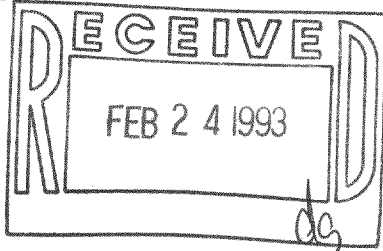

THIS IS NOT AN ORIGINAL PRINT
UNLESS THIS SEAL IS RED

Robert J. Wetzel
ROBERT J. WETZEL
REGISTERED LAND SURVEYOR - 1778

"I hereby certify that I have surveyed the above described property and that the above map is a true representation thereof and shows the size and location of the property, its exterior boundaries, the location of all visible structures and dimensions of all principal buildings thereon, boundary fences, apparent easements, roadways and encroachments, if any."

"This survey is made for the use of the present owners of the property, and those who purchase, mortgage, or guarantee the title thereto within one year from date hereof."

12/21/92
DATE

1103
JOB NUMBER