

Plat of a survey for **CHARLES DYKSTRA** of Parcel 2, Certified Survey Map No. 2327, a division of part of the  $SE\frac{1}{4}$  of the  $NE\frac{1}{4}$  of Section 15-3-18 in the Town of Spring Prairie, Walworth County, Wisconsin, and recorded in Volume 11 at pages 203 and 204 as Document No. 263787.

Tops of	Stakes	Elevations
5' E of	NE corner	82.97
5' W of	NW corner	82.96
Proposed	finished Grade	84.6

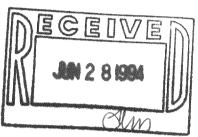

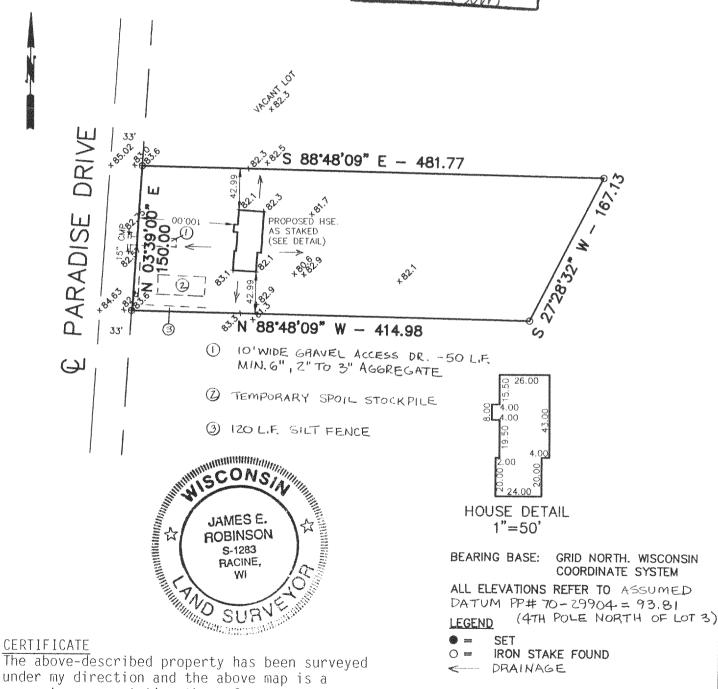

## NM

May 31, 1994

## Nielsen Madsen & Barber, S.C.

1339 Washington Avenue Racine, Wisconsin 53403 Phone (414) 634-5588 / 552-7902

Facsimile (414) 634-5024

rdcsimile (414) 034-30

correct representation thereof.

FIELD WORK 5-26-94 BY JRN, BSH

DRAWN \_\_\_ 5-27-94 BY\_

SCALE 1" = 100

JOB NO. <u>94.160</u>