
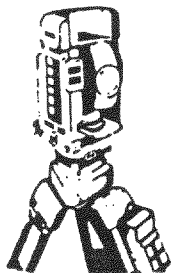


PLAT OF SURVEY
-OF-


LOTS 8, 9 & the North 1/2 of LOT 10, BLOCK 30, HONEY LAKE SUBDIVISION FIRST ADDITION,
according to the recorded plat thereof. Said land being in the Town of Spring Prairie,
County of Walworth and State of Wisconsin.

Survey For: Equity Homes

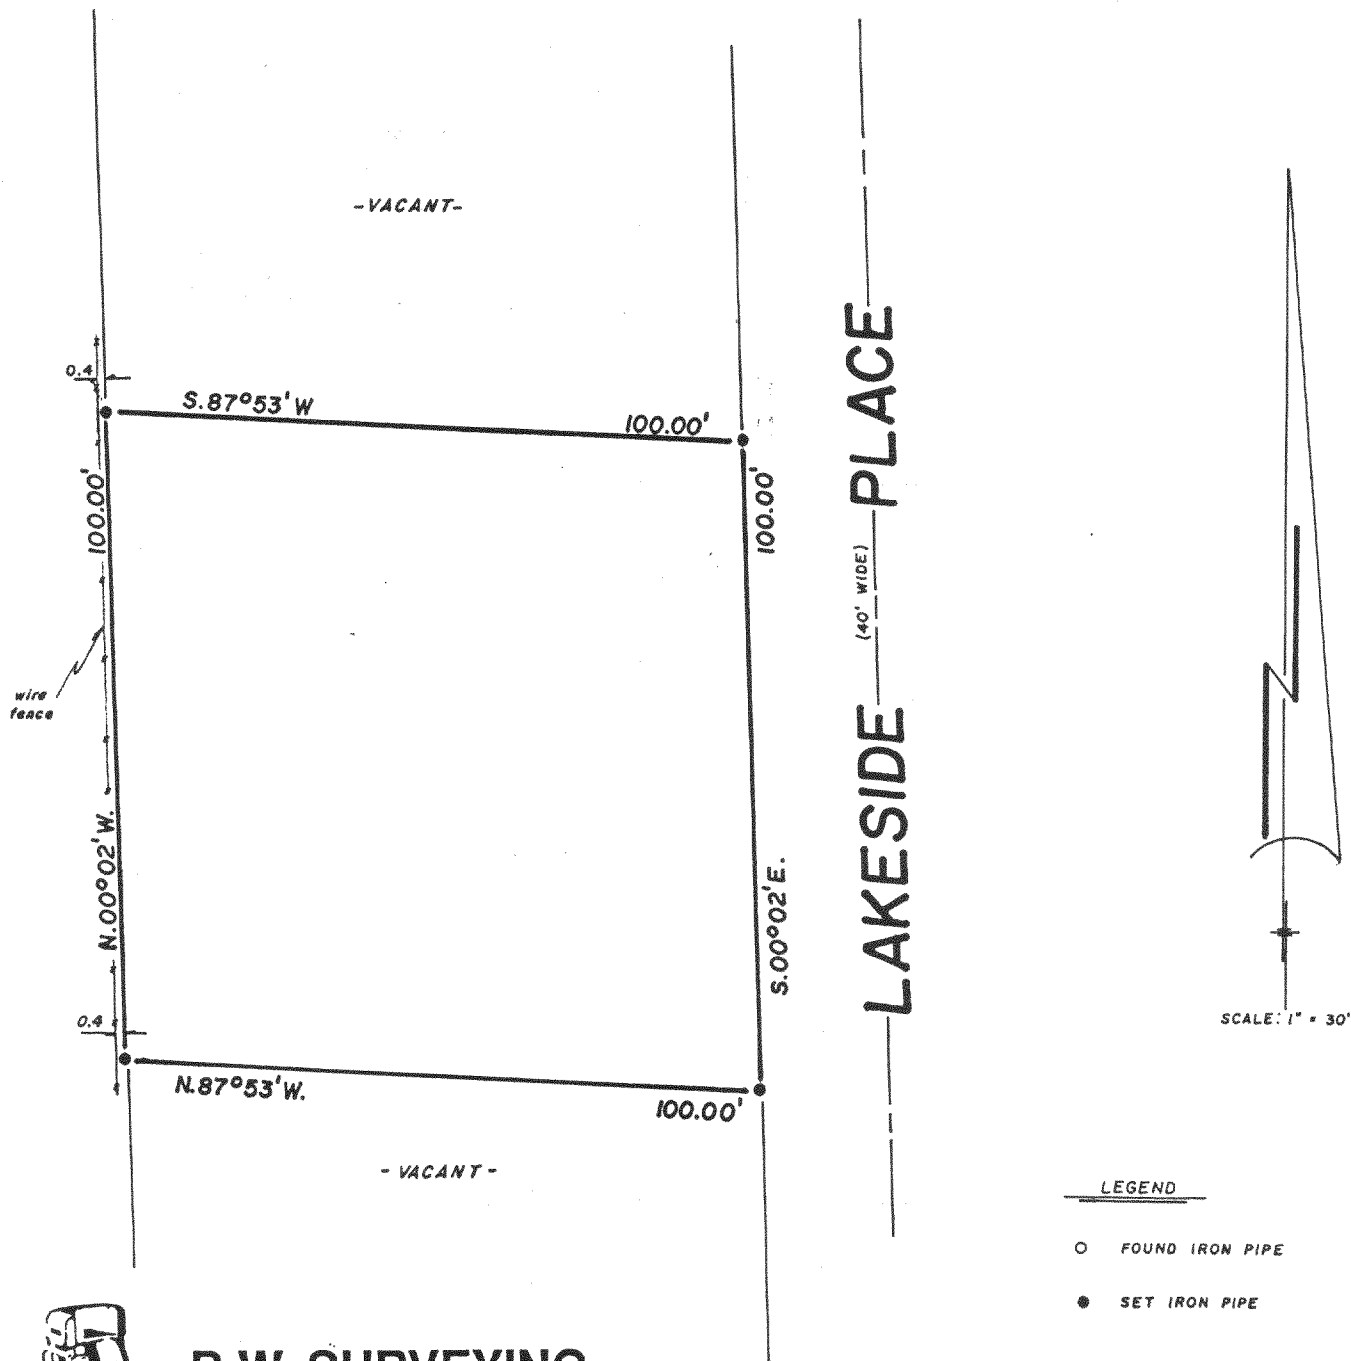


B.W. SURVEYING

Land Surveys
Mapping And Planning
35117 Academy Road
Burlington, Wisconsin 53105
(414) 534-4109

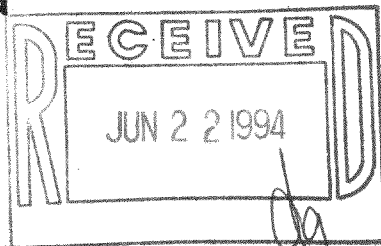

LEGEND
○ FOUND IRON PIPE
● SET IRON PIPE

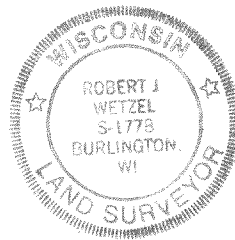

"I hereby certify that I have surveyed the above described property and that the above map is a true representation thereof and shows the size and location of the property, its exterior boundaries, the location of all visible structures and dimensions of all principal buildings thereon, boundary fences, apparent easements, roadways and encroachments, if any."

"This survey is made for the use of the present owners of the property, and those who purchase, mortgage, or guarantee the title thereto within one year from date hereof."

THIS IS NOT AN ORIGINAL PRINT
UNLESS THIS SEAL IS RED

Robert J. Wetzel
ROBERT J. WETZEL
REGISTERED LAND SURVEYOR - 1778

JULY 9, 1993
DATE

1314 A
JOB NUMBER

0461-214A, 0461-215

318-478