
## **PLAT OF SURVEY**

LOCATION: 7720 S.T.H. "11", Spring Prairie, Wisconsin

LEGAL DESCRIPTION: Lot 2 in CERTIFIED SURVEY MAP NO. 2534, located in the Southeast 1/4 of Section 29, Town 3 North, Range 18 East, Town of Spring Prairie, Walworth County, Wisconsin. ALSO that part of the Southeast 1/4 of the Southeast 1/4 of Section 29, Township 3 North, Range 18 East of the Fourth Principal Meridian, in the Town of Spring Prairie, Walworth County, Wisconsin, described as follows: Commence at the Southeast corner of said Southeast 1/4 Section; thence S 87°50'26" W, 263.18 feet (recorded as 259.20 feet) to a point of curvature; thence Southwesterly 38.58 feet along the arc of said curve being a curve to the right, having a radius of 1433.32 feet (recorded as 1432.60 feet), a central angle of 1°27'43", and whose long chord bears S88°34'22" W, 38.57 feet; thence N 02°28'00" W, 50.03 feet to a point on the North line of State Trunk Highway "ll" and the place of beginning of this description; thence Northwesterly 66.11 feet along said North line being the arc of a curve to the right, having a radius of 1383.32 feet (recorded as 1382.60 feet), a central angle of 02°44'17", and whose long chord bears N 89°15'52" W, 66.10 feet to the Southeast corner of Certified Survey Map No. 2304; thence N 02°28'00" W along the East line of said Map, 282.40 feet to the Northeast corner of said Map; thence N 89°15'26" W along the North line of said Map, 394.38 feet; thence N 02°29'31" W, 243.69 feet; thence S 89°15'26" E, 460.59 feet; thence S 02°28'00" E, 526.07 feet to \_\_\_\_\_ the place of beginning.

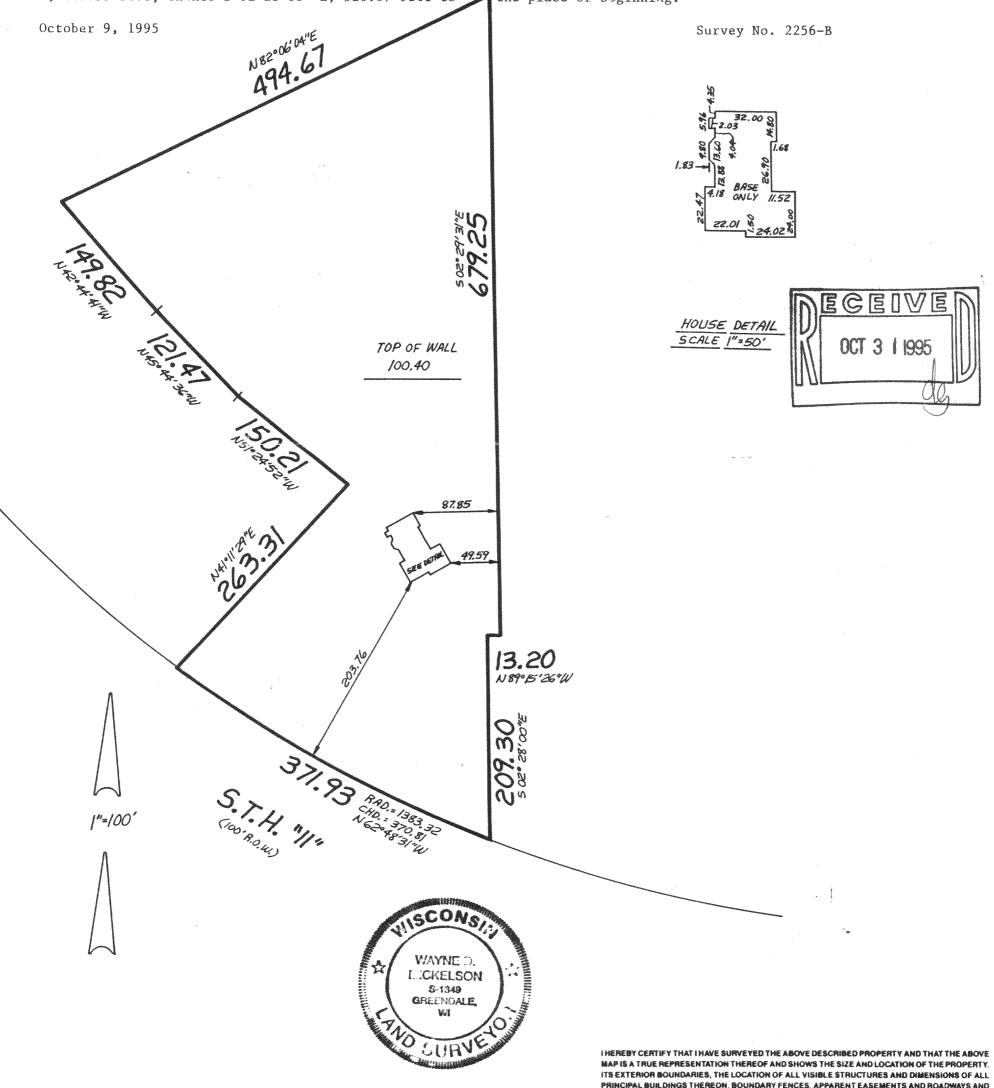

**METROPOLITAN ENTERPRISES, INC.** 

**REGISTERED LAND SURVEYORS** 9415 W. FOREST HOME AVE., SUITE 202, HALES CORNERS, WI 53130 PH. 529-5380 FAX 529-9787

THIS SURVEY IS MADE FOR THE EXCLUSIVE USE OF THE PRESENT OWNERS OF THE PROPERTY, AND ALSO THOSE WHO PURCHASE, MORTGAGE, OR GUARANTEE THE TITLE THERETO WITHIN ONE (1) YEAR

VISIBLE ENCROACHMENTS, IF ANY.

Wayne D. Mickelson

318-541 OA-2534-2