SCALE 1" = 20'


ø = IRON PIPE FOUND.

¥ = PVC PIPE ON MOUND SYSTEM

MOUND SYSTEM DIMENSIONS SHOWN AS TAKEN FROM FOOT OF SLOPE OF ACTUAL MOUND.

FOR: SZEWCZYNSKI

hereof.

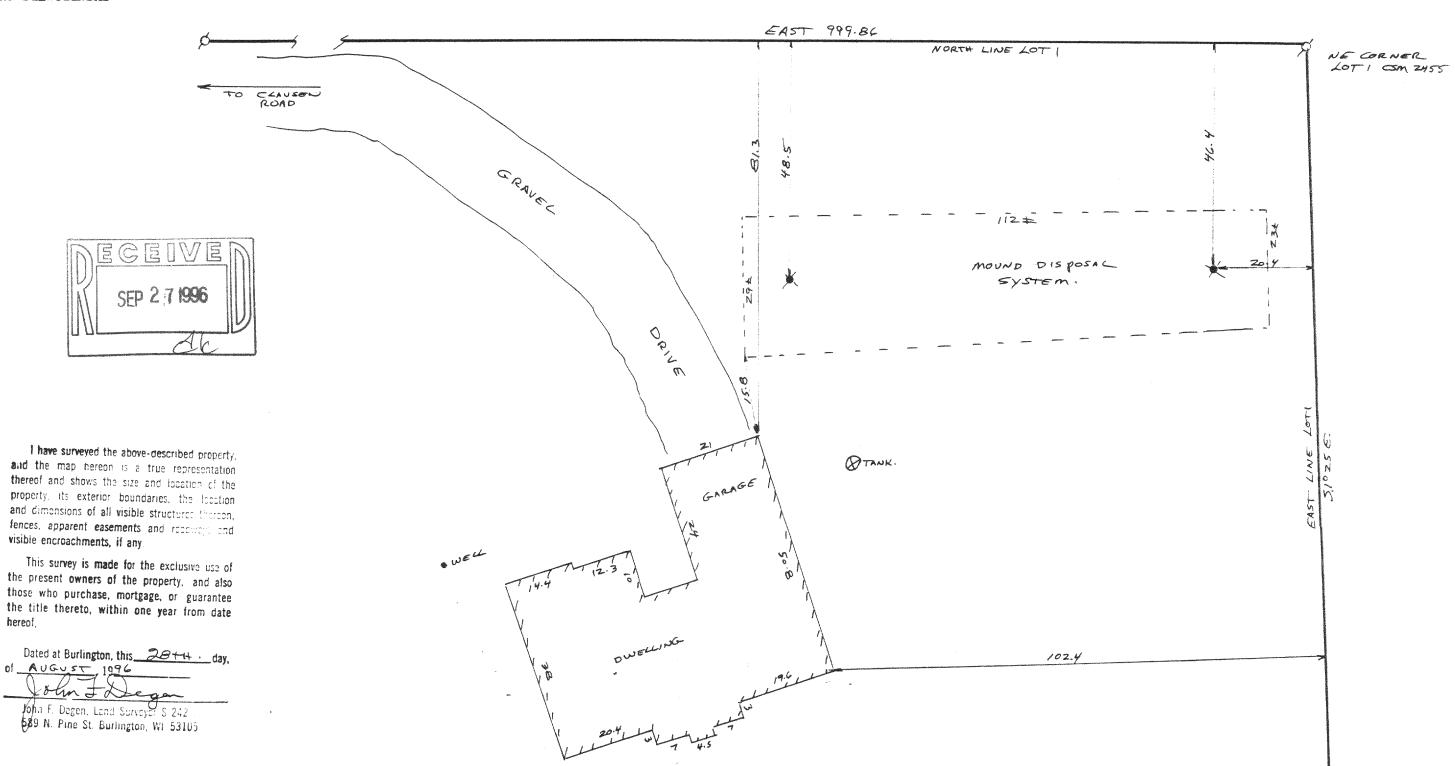

OR-2455-1 318-560