


PLAT OF SURVEY
-OF-


LOT 2 OF CERTIFIED SURVEY MAP NO. 747, part of the Southwest 1/4 of Section 3, Township 3, North, Range 18 East, Town of Spring Prairie, County of Walworth, State of Wisconsin.

Survey For: Dick Katzman
Survey Location: W 1184 County Road "D"

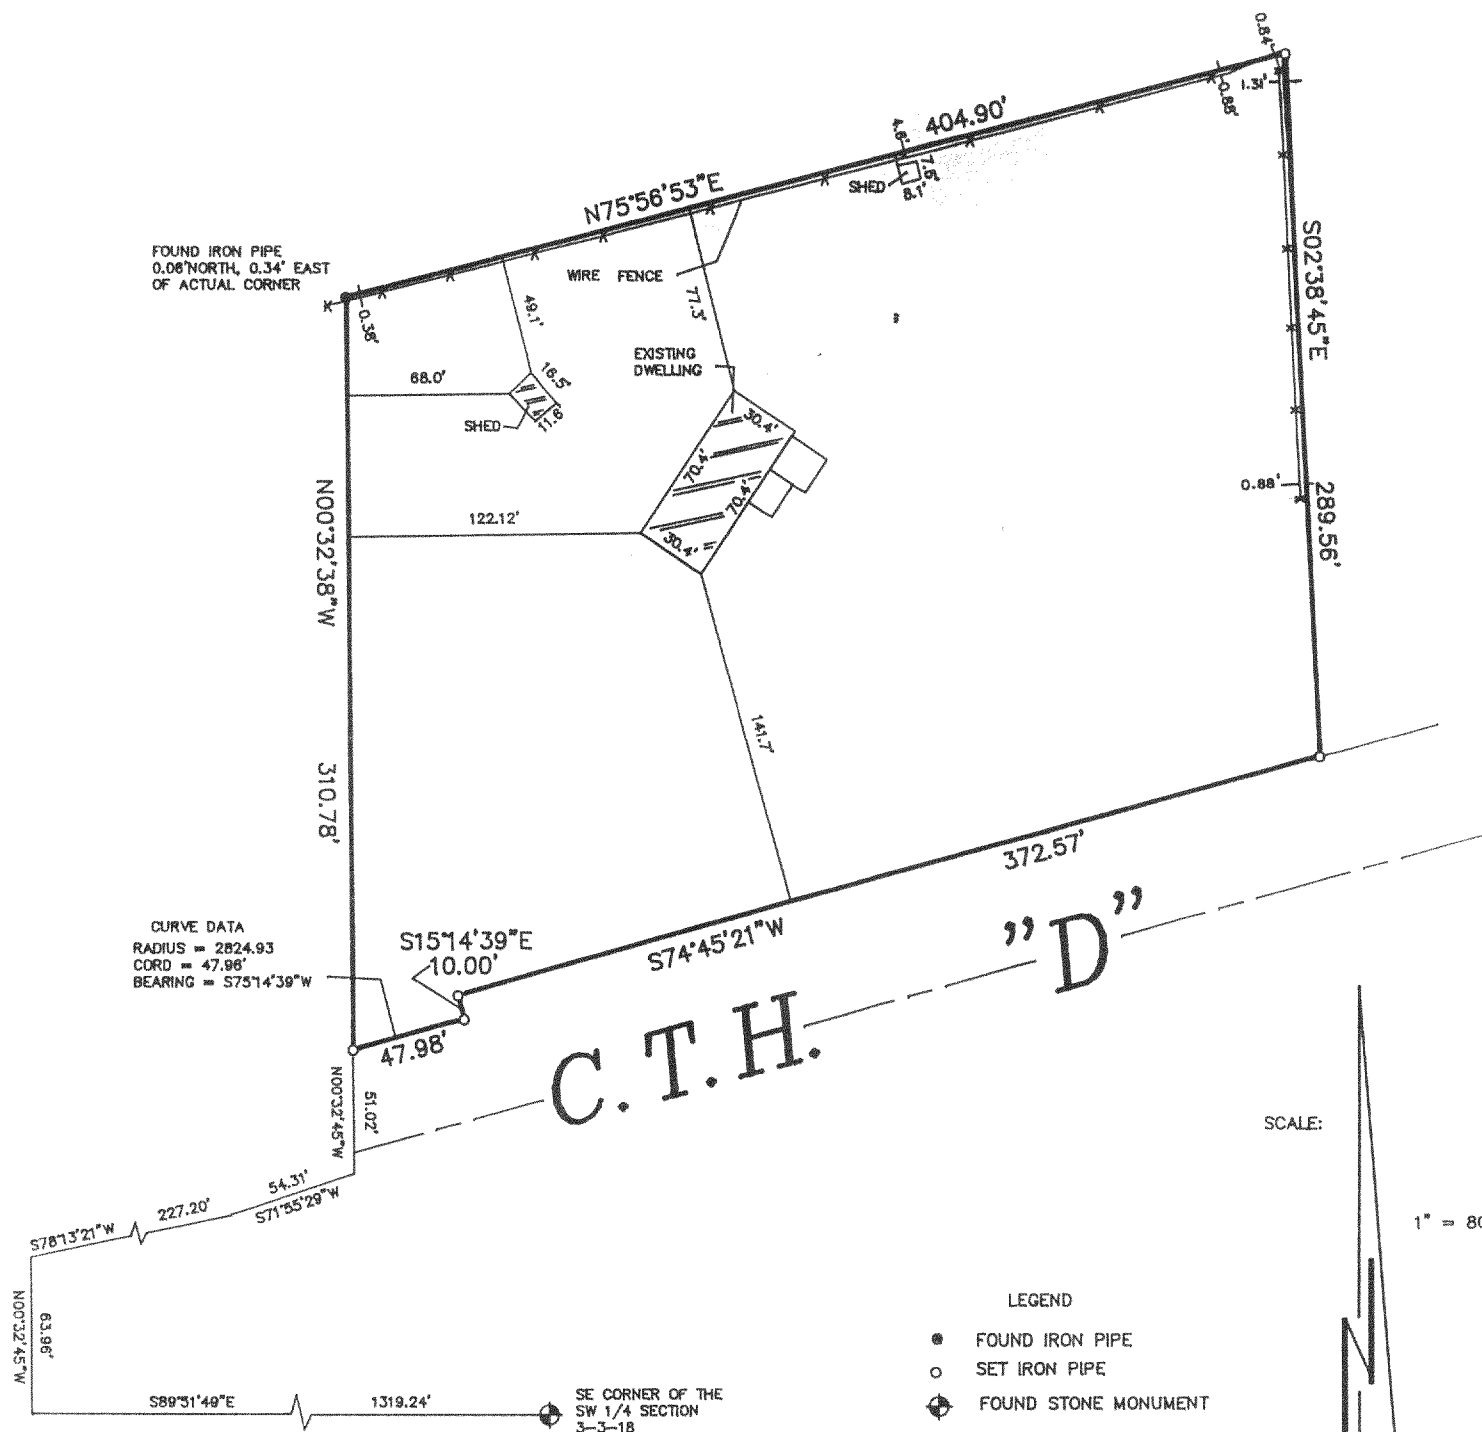


"I hereby certify that I have surveyed the above described property and that the above map is a correct representation thereof and shows the size and location of the property, its exterior boundaries, the location of all visible structures and dimensions of all principal buildings thereon, boundary fences, apparent easements, roadways and encroachments, if any."

"This survey is made for the use of the present owners of the property, and those who purchase, mortgage, or guarantee the title thereto within one year from date hereof."

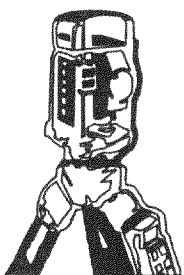

B.W. SURVEYING

LAND SURVEYS
MAPPING AND PLANNING
412 N. PINE STREET
BURLINGTON, WI 53105
(414)-767-0225

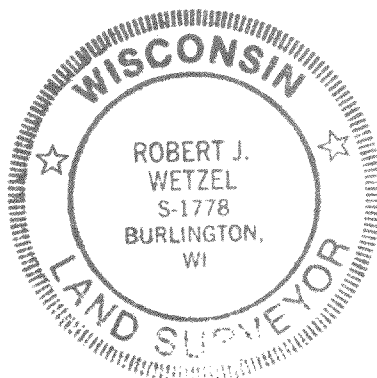


THIS IS NOT AN ORIGINAL PRINT
UNLESS THIS SEAL IS RED.

Robert J. Wetzel
ROBERT J. WETZEL S-1778

7/28/97
DATE

3049
JOB NUMBER

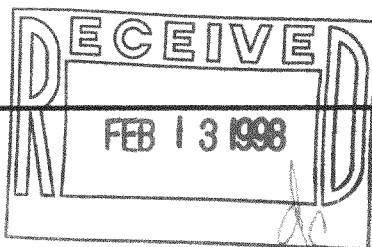

0A-747-2
318-606