


PLAT OF SURVEY  
-OF-

LOTS 4, 5, 6, 7, 8, and 9, BLOCK 30, HONEY LAKE SUBDIVISION FIRST ADDITION, according to the recorded plat thereof. Said land being in the Town of Spring Prairie, County of Walworth and the State of Wisconsin.

Survey For: Bear Realty  
Survey Location: \_\_\_\_\_ Lake Side Place

- LEGEND**
- FOUND IRON PIPE
  - SET IRON PIPE
  - ( ) MEASURED AS


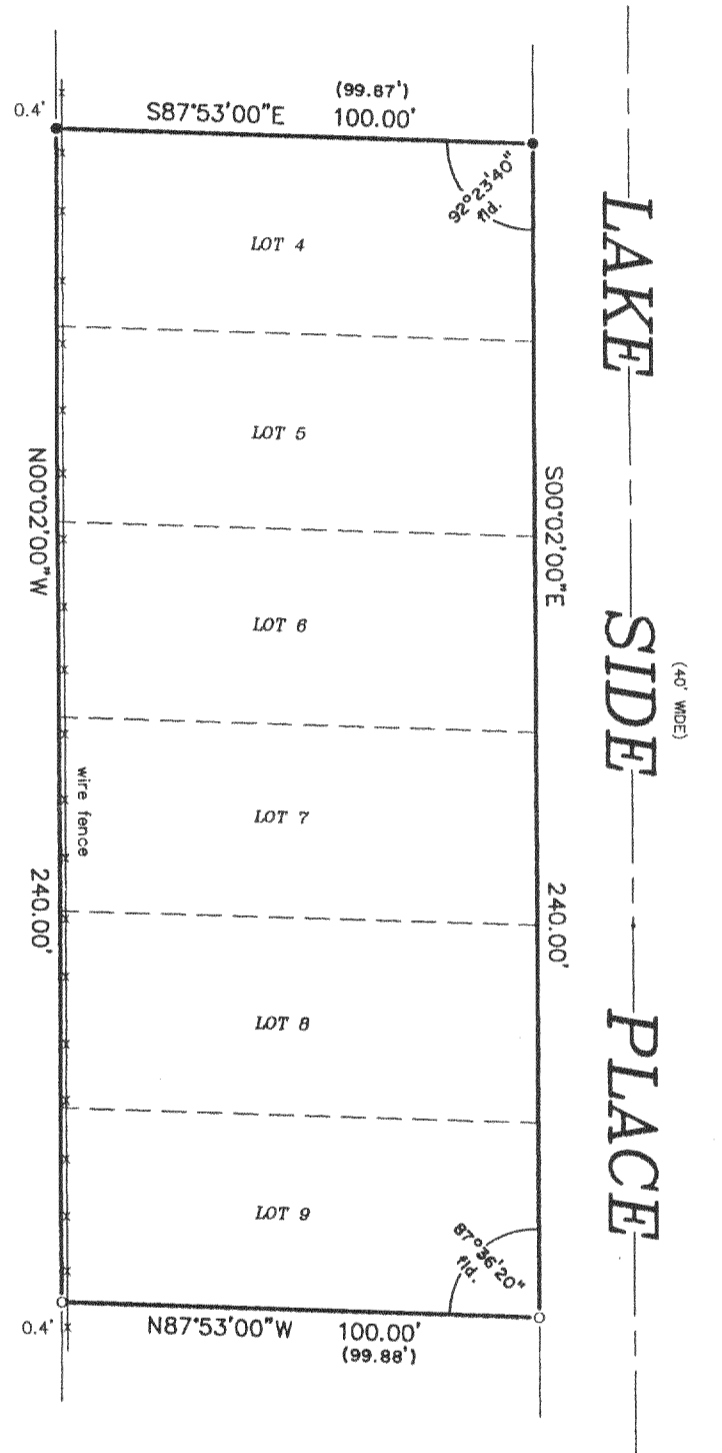


SCALE: 1" = 40'




"I hereby certify that I have surveyed the above described property and that the above map is a correct representation thereof and shows the size and location of the property, its exterior boundaries, the location of all visible structures and dimensions of all principal buildings thereon, boundary fences, apparent easements, roadways and encroachments, if any."

"This survey is made for the use of the present owners of the property, and those who purchase, mortgage, or guarantee the title thereto within one year from date hereof."

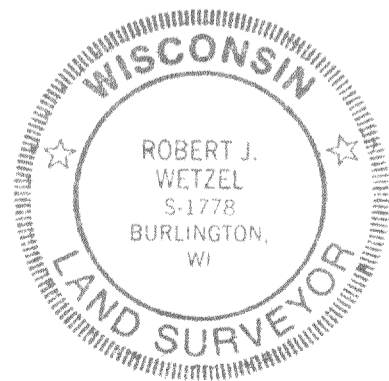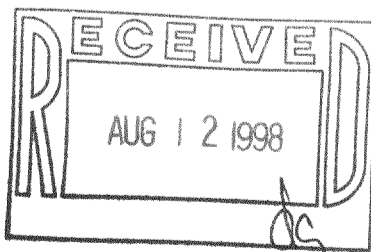

THIS IS NOT AN ORIGINAL PRINT  
UNLESS THIS SEAL IS RED.

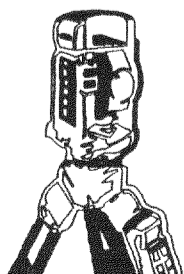

**B.W. SURVEYING**

LAND SURVEYS  
MAPPING AND PLANNING  
412 N. PINE STREET  
BURLINGTON, WI 53105  
(414)-767-0225

*Robert J. Wetzel*  
ROBERT J. WETZEL

JULY 6, 1998  
DATE

3548  
JOB NUMBER

OHL1-212  
OHL1-214  
OHL1-214A

318-630