


PLAT OF SURVEY

LOCATION: W964 Clayton Court, Spring Prairie, Wisconsin

LEGAL DESCRIPTION: Lot 2 in PARADISE ESTATES A CONDOMINIUM, a Condominium in the Town of Spring Prairie, Walworth County, Wisconsin, being a part of the Southeast 1/4 and the Southwest 1/4 of the Northeast 1/4 and the Northeast 1/4, Northwest 1/4 and Southwest 1/4 of the Southeast 1/4 of Section 15, Township 3 North, Range 18 East of the Fourth Principal Meridian, in the Town of Spring Prairie, Walworth County, Wisconsin.

October 9, 2000

Survey No. 4600-B

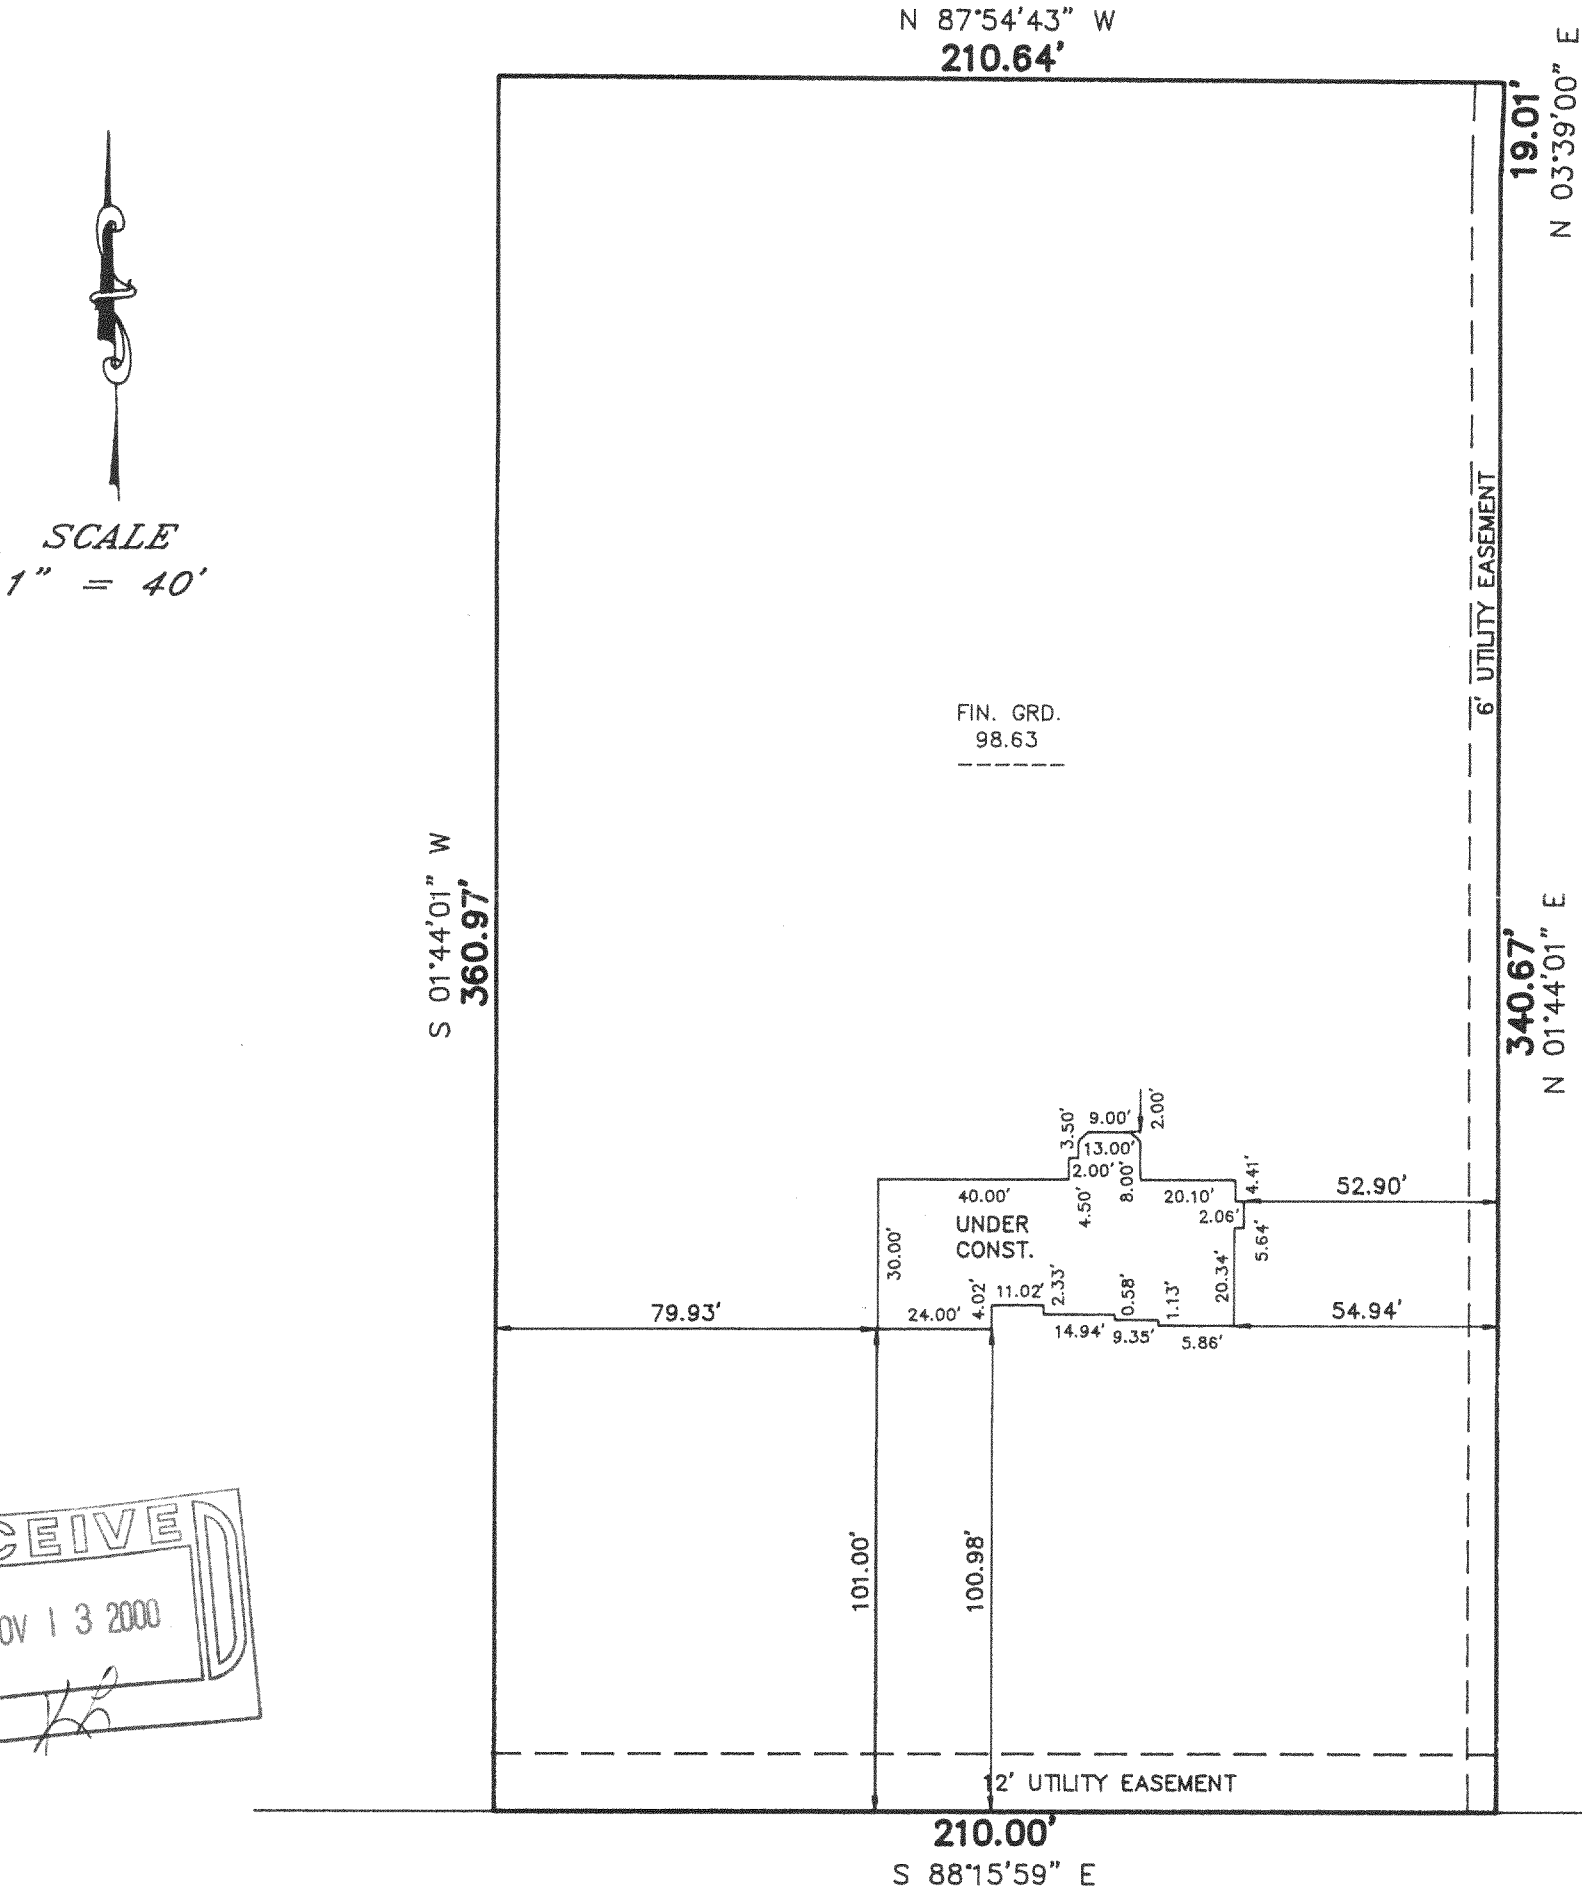

CLAYTON COURT
(66' R/W)

METROPOLITAN ENTERPRISES, INC.
REGISTERED LAND SURVEYORS
9415 W. FOREST HOME AVE., SUITE 202, HALES CORNERS, WI 53130
PH. 529-5380 FAX 529-9787



I HEREBY CERTIFY THAT I HAVE SURVEYED THE ABOVE DESCRIBED PROPERTY AND THAT THE ABOVE MAP IS A TRUE REPRESENTATION THEREOF AND SHOWS THE SIZE AND LOCATION OF THE PROPERTY, ITS EXTERIOR BOUNDARIES, THE LOCATION OF ALL VISIBLE STRUCTURES AND DIMENSIONS OF ALL PRINCIPAL BUILDINGS THEREON, BOUNDARY FENCES, APPARENT EASEMENTS AND ROADWAYS AND VISIBLE ENCROACHMENTS, IF ANY.

THIS SURVEY IS MADE FOR THE EXCLUSIVE USE OF THE PRESENT OWNERS OF THE PROPERTY, AND ALSO THOSE WHO PURCHASE, MORTGAGE, OR GUARANTEE THE TITLE THERETO WITHIN ONE (1) YEAR FROM DATE HEREOF.

SIGNED *Wayne D. Mickelson*

Wayne D. Mickelson
Registered Land Surveyor 8-1348

OPE - 2