

ROBERS & BOYD, INC.
CONSULTING ENGINEERS & LAND SURVEYORS


PHONE (414) 763-2652

116 E. CHESTNUT ST.

BURLINGTON, WIS. 53105

PLAT OF SURVEY
OF

THE SOUTHERLY 20.00 OF LOT 20, LOT 21 AND 22, S1/2
HONEY LAKE SUBDIVISION FIRST ADDITION, T3N, R.3E, WK-NORTH
CO., WISCONSIN

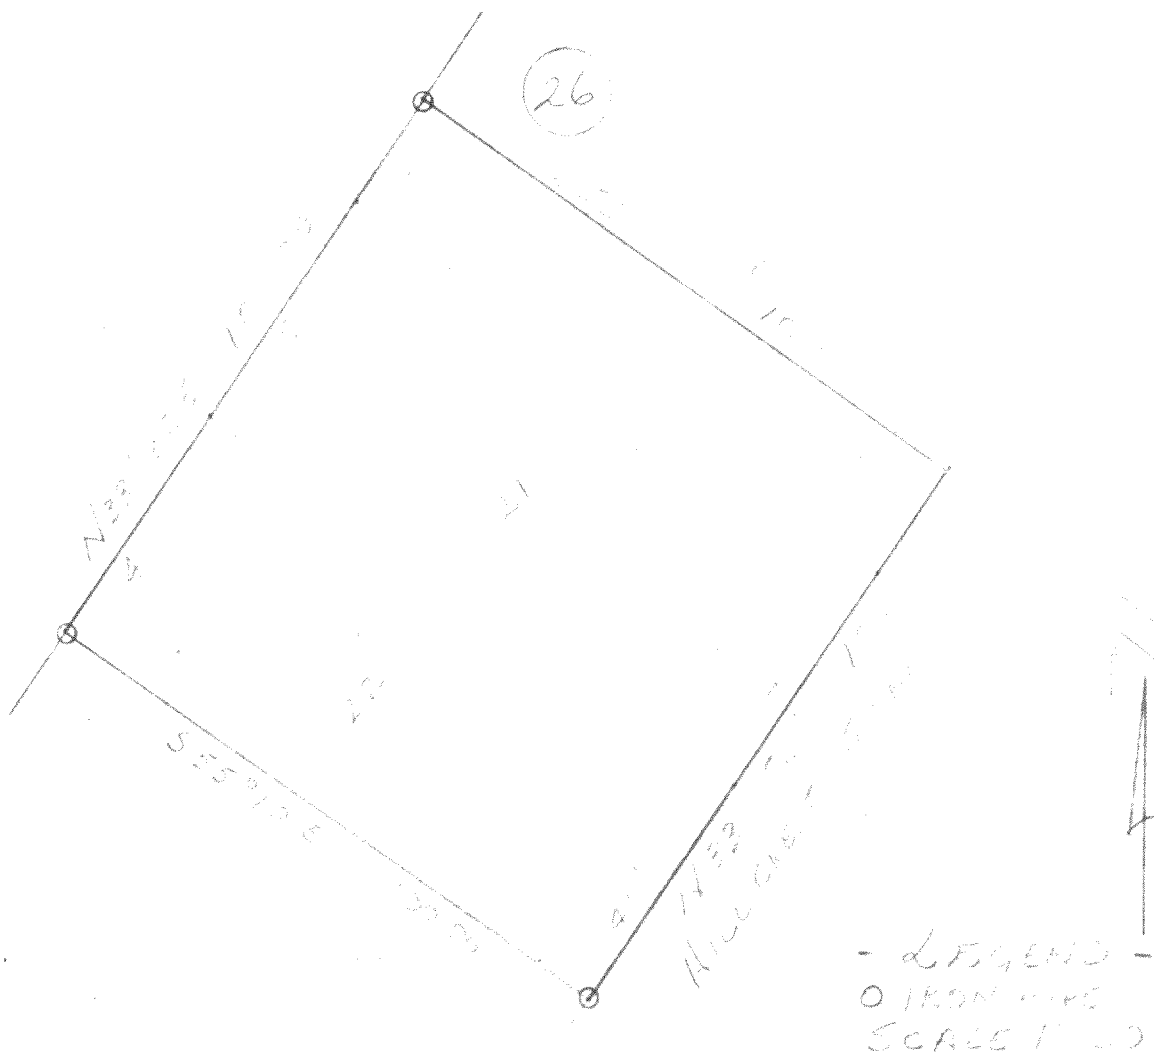


- LEGEND -
O IRON PINS
SCALE 1" = 20'

I HEREBY CERTIFY THAT WE HAVE SURVEYED THE LANDS DESCRIBED
ABOVE ACCORDING TO OFFICIAL RECORDS AND THAT THE PLAT
DRAWN HEREON IS A CORRECT REPRESENTATION OF SAID SURVEY.

WIS. REG. LAND SURVEYOR

Matthew A. Rober
500787

DATE 6-1-73

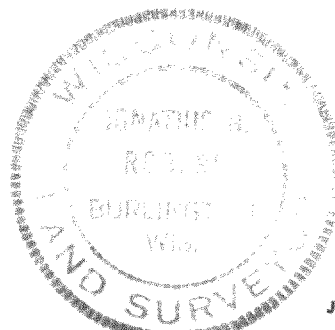

JOB NO.

730930