

**ROBERS & BOYD, INC.**  
CONSULTING ENGINEERS & LAND SURVEYORS


PHONE (414) 763-2652

116 E. CHESTNUT ST.

BURLINGTON, WIS. 53105

PLAT OF SURVEY  
OF

THE SOUTHERLY 20.00 OF LOT 20, LOT 21 AND 22, S1/2  
HONEY-LAKE SUBDIVISION FIRST ADDITION, T2N, R.3E, WK-NORTH  
CO., WISCONSIN

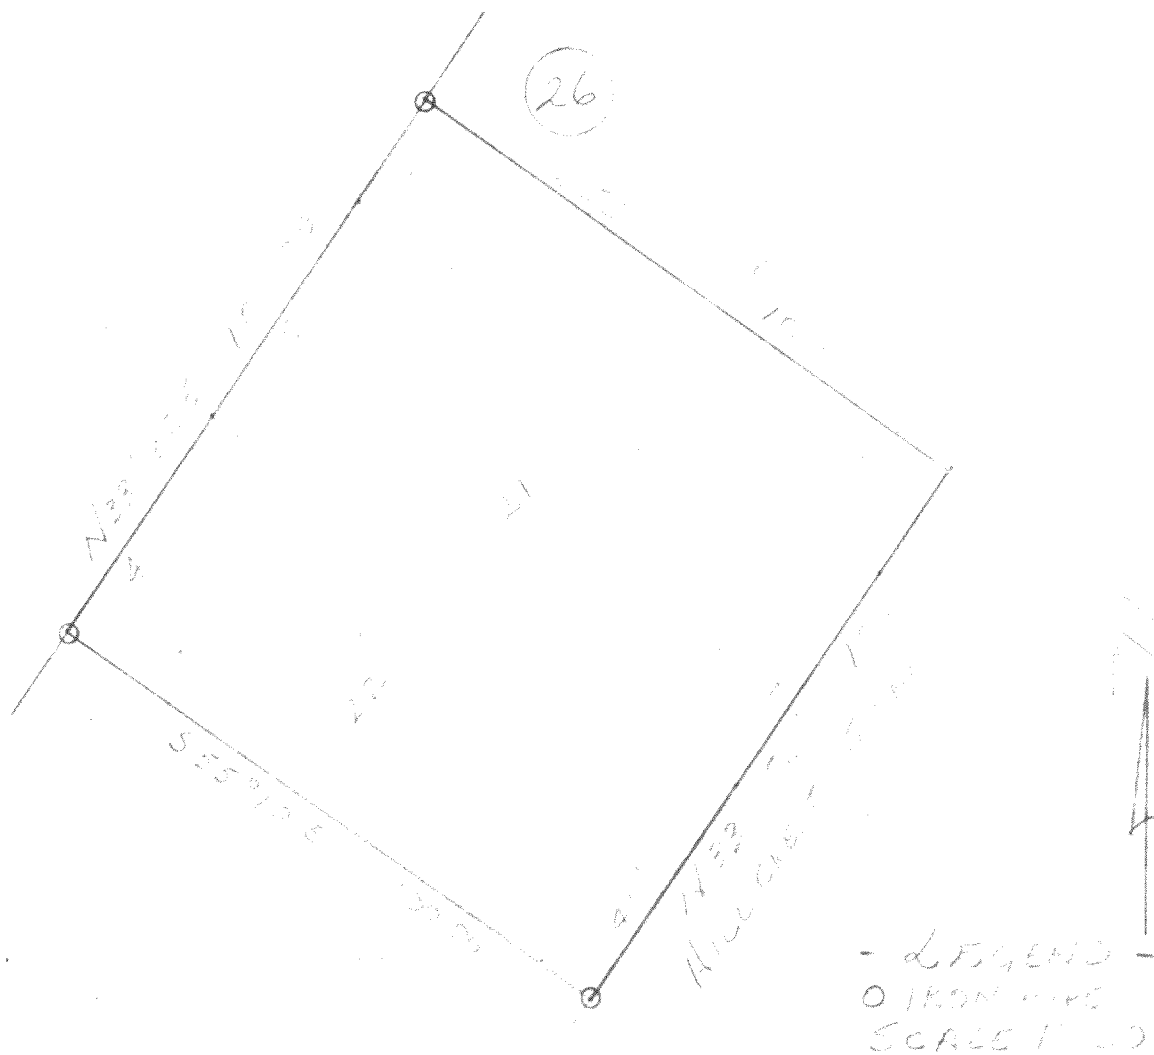

I HEREBY CERTIFY THAT WE HAVE SURVEYED THE LANDS DESCRIBED  
ABOVE ACCORDING TO OFFICIAL RECORDS AND THAT THE PLAT  
DRAWN HEREON IS A CORRECT REPRESENTATION OF SAID SURVEY.

WIS. REG. LAND SURVEYOR

500797

DATE

6-1-73

JOB NO.

730930