


PLAT OF SURVEY  
-OF-

LOTS NUMBER SIX (6), SEVEN (7), AND EIGHT (8)  
IN BLOCK NUMBER TEN (10) IN HONEY LAKE  
SUBDIVISION, FIRST ADDITION, TOWN OF SPRING  
PRAIRIE, PURSUANT TO THE RECORDED PLAT  
THEREOF - SUBJECT TO RESTRICTIONS AND  
COVENANTS OF RECORD.

SURVEY FOR: GERALD RUDOLPH


NOTE: PROPOSED DWELLING TO BE STAKED  
UPON NOTIFICATION BY THE ABOVE NAMED  
CLIENT.

I HEREBY CERTIFY THAT THE EXISTING DWELLING  
AS LOCATED ON THIS PLAT OF SURVEY IS LOCATED  
AS SHOWN THUS ( ). DATED THIS 26TH DAY OF  
SEPTEMBER, 2002.

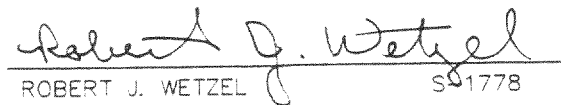  
ROBERT J. WETZEL S-1778

"I hereby certify that I have surveyed the above described  
property and that the above map is a correct representation thereof  
and shows the size and location of the property, its exterior  
boundaries, the location of all visible structures and dimensions  
of all principal buildings thereon, boundary fences, apparent  
easements, roadways and encroachments, if any."

"This survey is made for the use of the present owners of the  
property, and those who purchase, mortgage, or guarantee the  
title thereto within one year from date hereof."

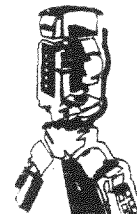

B.W. SURVEYING, INC.

412 N. PINE STREET  
BURLINGTON, WI 53105  
(262)-767-0225


SCALE:

1" = 30'





LEGEND

○ FOUND IRON PIPE

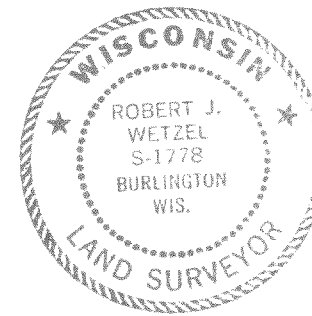

THIS IS NOT AN ORIGINAL PRINT  
UNLESS THIS SEAL IS RED.

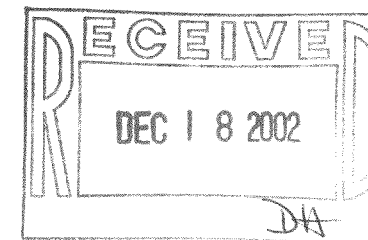

  
ROBERT J. WETZEL S-1778

JUNE 28, 2002  
DATE

5456  
JOB NUMBER

