

ROBERS & BOYD, INC.
CONSULTING ENGINEERS & LAND SURVEYORS

PHONE (414) 763-2652

116 E. CHESTNUT ST.

BURLINGTON, WIS. 53105

PLAT OF SURVEY AND DESCRIPTION

HOUSE FOUNDATION

OF


LOTS 5, 6, 7, 99, 100

PART OF THE SE 1/4 SECTION 18, T38N, R8E,


TOWN OF SPRING PRAIRIE, WALWORTH COUNTY, WISCONSIN



WAVELAND - AVE

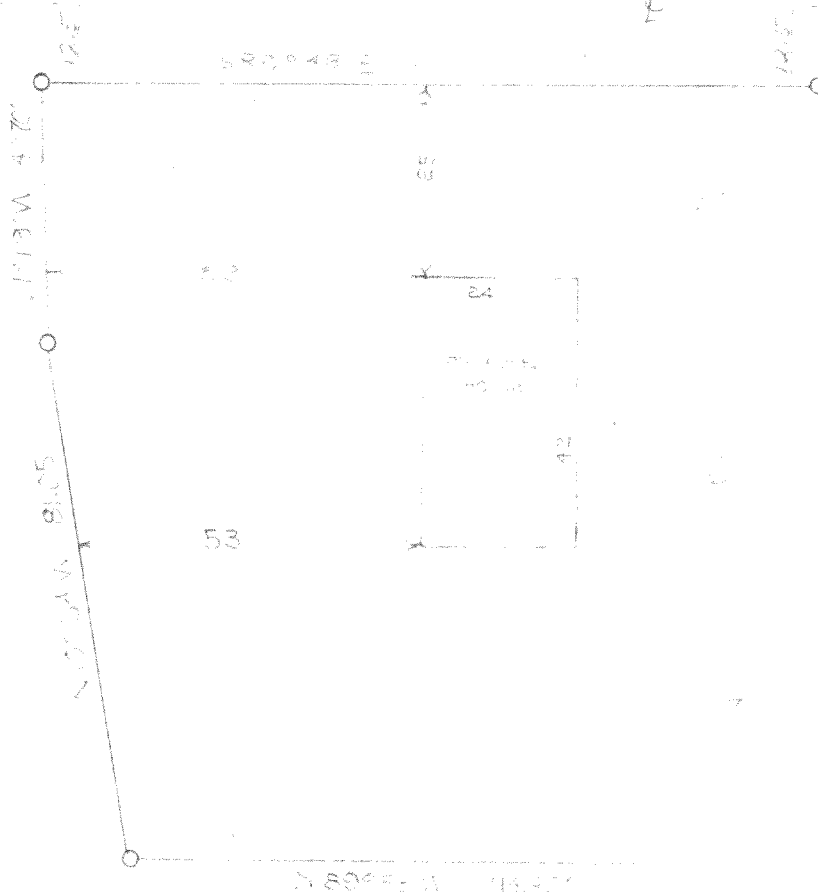

LEGEND
IRON PIPE
SCALE 1"=30'

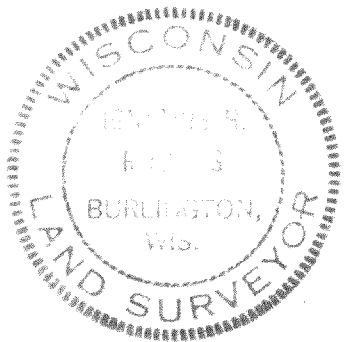

I HEREBY CERTIFY THAT WE HAVE SURVEYED THE LANDS DESCRIBED ABOVE ACCORDING TO OFFICIAL RECORDS AND THAT THE PLAT DRAWN HEREON IS A CORRECT REPRESENTATION OF SAID SURVEY.

Edward A. Rober
WIS. REG. LAND SURVEYOR

DATE 6-13-73

JOB NO. 73105