


JUN - 4 2003
DRP

I HEREEY CERTIFY THAT THE EXISTING FOUNDATION AS SHOWN
BY THIS PLAT OF SURVEY IS LOCATED AS SHOWN THUS ().
DATED THIS 7TH DAY OF APRIL, 2003.

Robert J. Wetzel
ROBERT J. WETZEL S-1778

PROPOSED ADDRESS: _____ SUGAR CREEK PRAIRIE DRIVE

SCALE: 1" = 40'

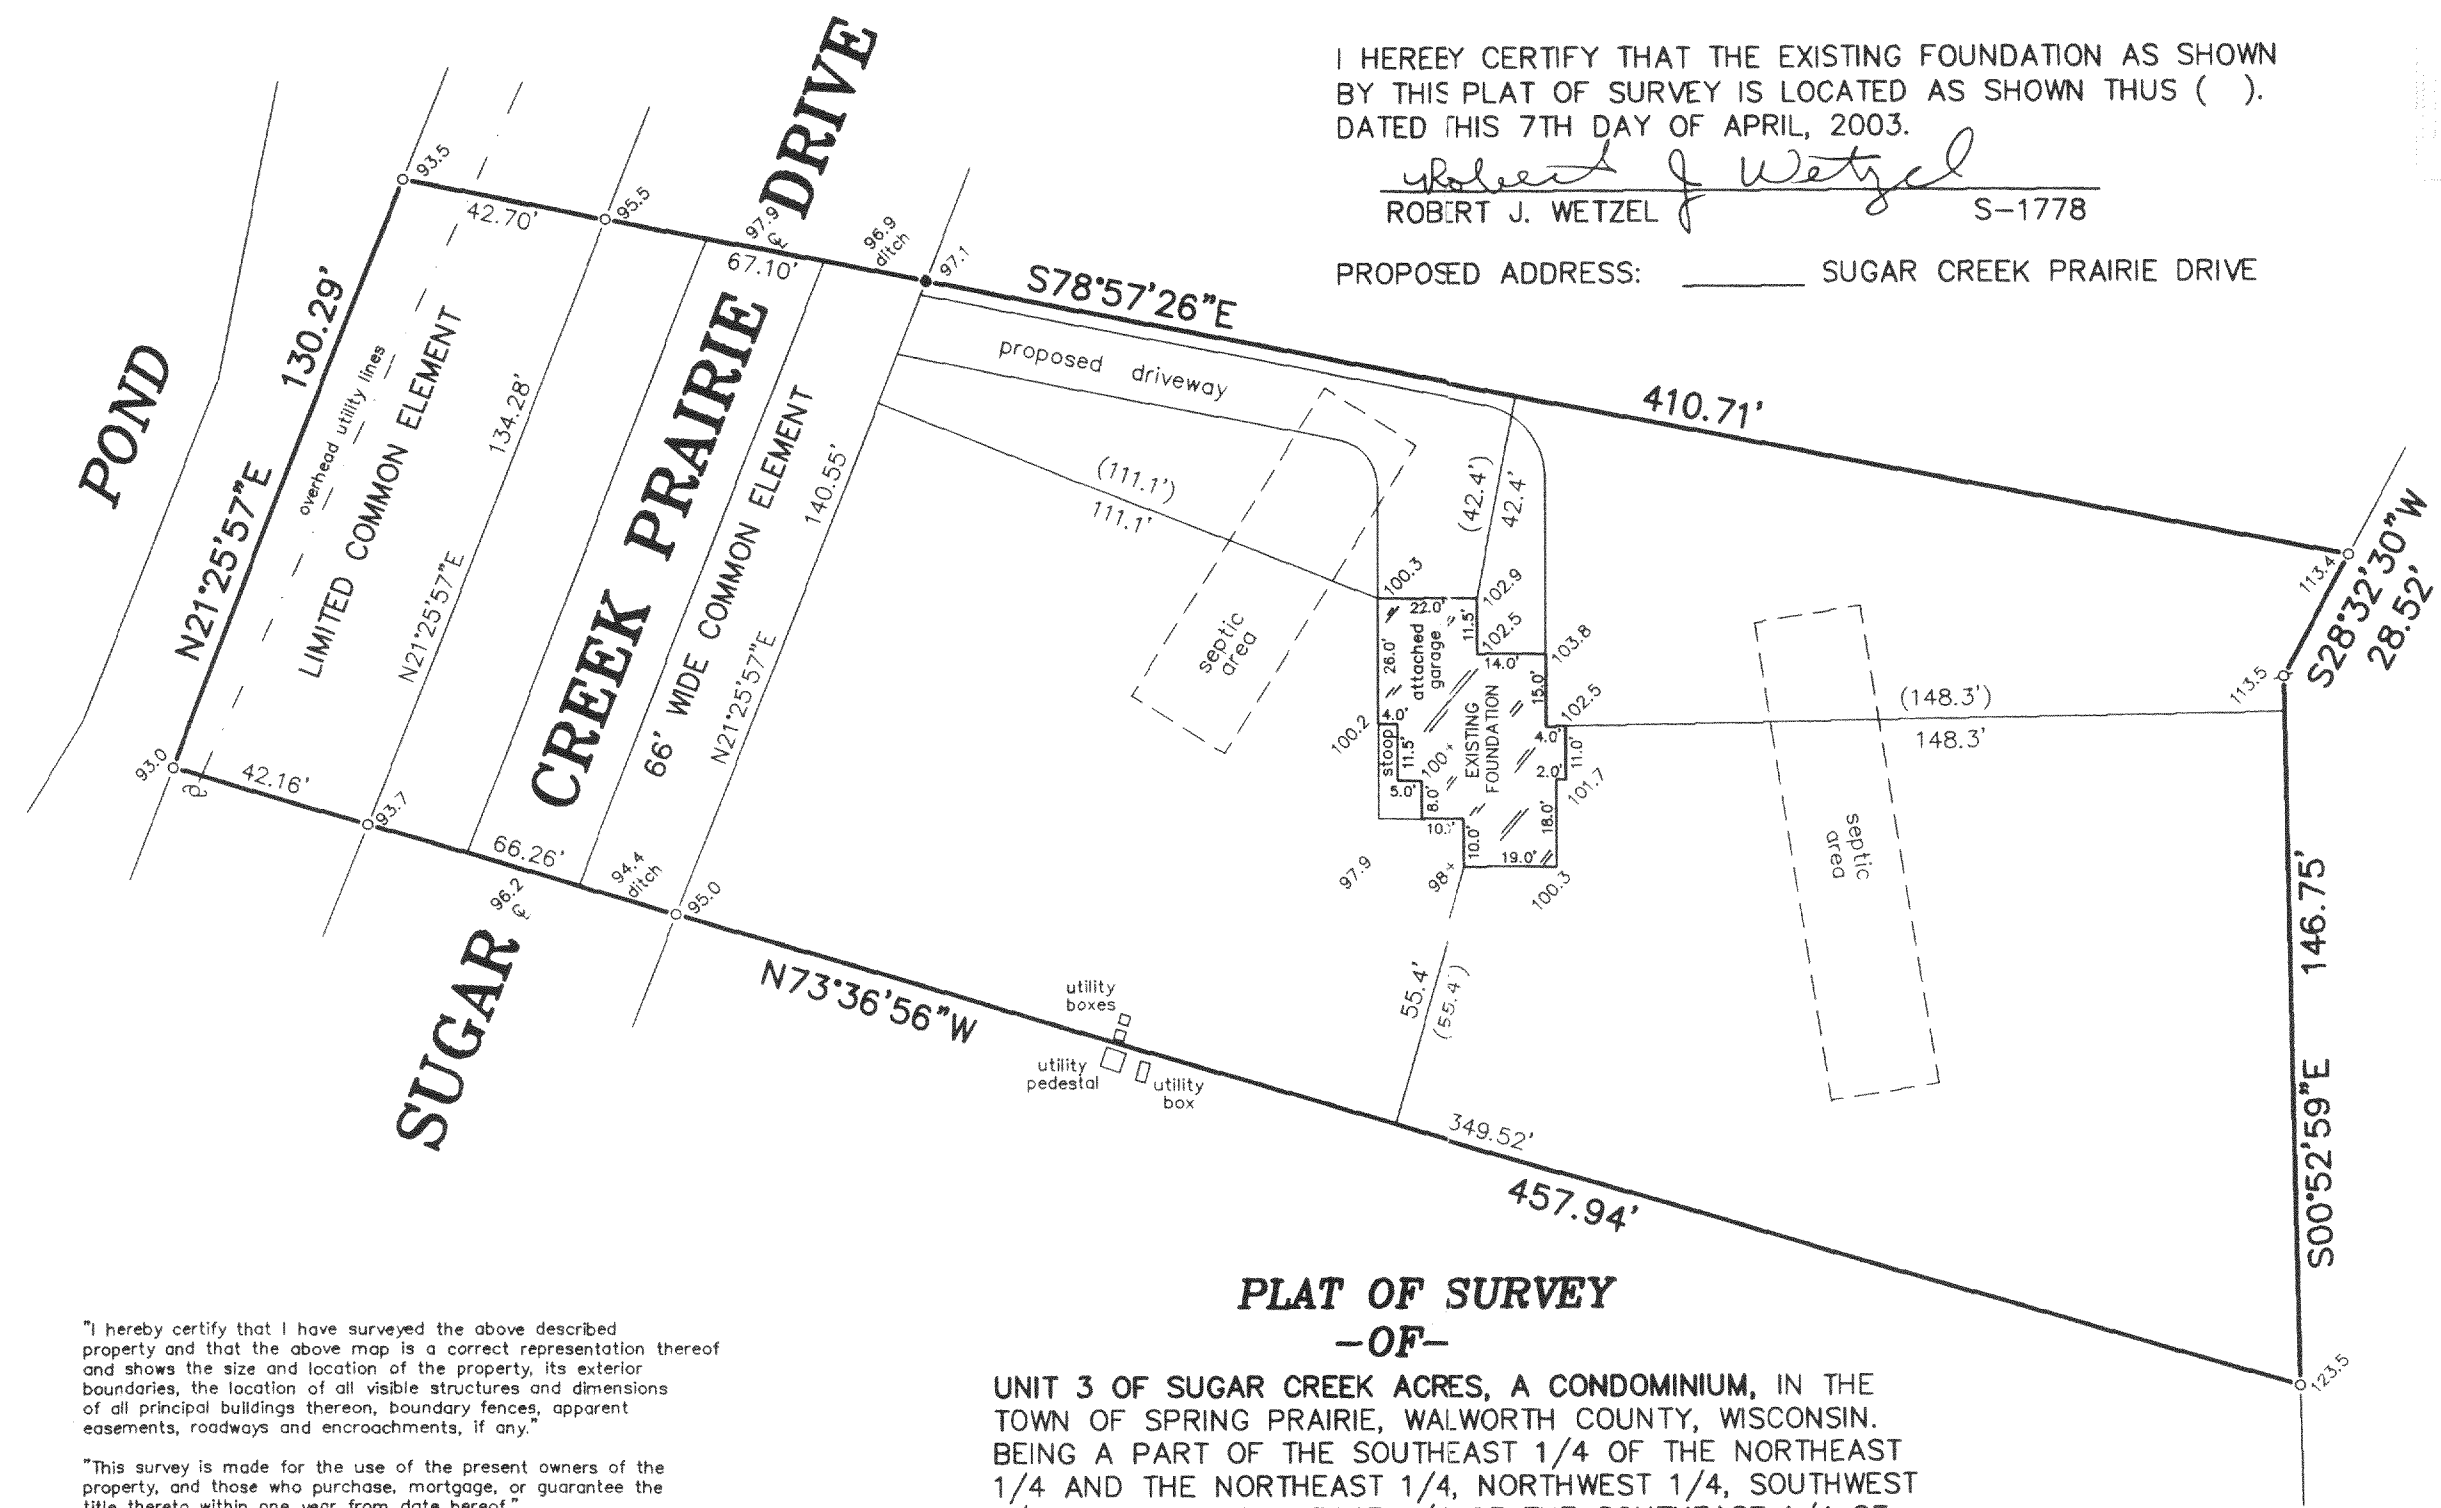

**PLAT OF SURVEY
-OF-**

UNIT 3 OF SUGAR CREEK ACRES, A CONDOMINIUM, IN THE
TOWN OF SPRING PRAIRIE, WALWORTH COUNTY, WISCONSIN.
BEING A PART OF THE SOUTHEAST 1/4 OF THE NORTHEAST
1/4 AND THE NORTHEAST 1/4, NORTHWEST 1/4, SOUTHWEST
1/4 AND THE SOUTHEAST 1/4 OF THE SOUTHEAST 1/4 OF
SECTION 15, TOWNSHIP 3 NORTH, RANGE 18 EAST OF THE
FOURTH PRINCIPAL MERIDIAN, IN THE TOWN OF SPRING PRAIRIE,
WALWORTH COUNTY, WISCONSIN.

SURVEY FOR: MARCUS GRASSER

PROPOSED DWELLING WAS STAKED ON ACTUAL CORNERS WITH 5
FOOT CONTROL ON THE LONGEST HOUSE LINE. THE CONTRACTOR
WILL BE RESPONSIBLE TO FIELD VERIFY ALL STAKES FOR LOCATION
AND DIMENSION PRIOR TO CONSTRUCTION. THIS OFFICE SHOULD
BE NOTIFIED IMMEDIATELY IF ANY DISCREPANCIES OCCUR.

LEGEND

- FOUND IRON PIPE
- SET IRON PIPE
- ⊕ FOUND IRON ROD
- 100.0 EXISTING ELEVATION
- ⊕ UTILITY POLE




THIS IS NOT AN ORIGINAL PRINT
UNLESS THIS SEAL IS RED.

Robert J. Wetzel
ROBERT J. WETZEL S-1778

FEBRUARY 21, 2003
DATE

5749B
JOB NUMBER

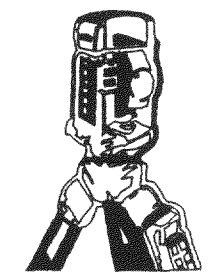

B.W. SURVEYING, INC.

LAND SURVEYS
MAPPING AND PLANNING
412 N. PINE STREET
BURLINGTON, WI 53105
(262)-767-0225

OSCA-3

318-833