

**LAND-MARK SURVEYING**

**Mark L. Miritz**

Wisconsin Registered Land Surveyor S-2582

N9330 Knuteson Drive  
Whitewater, WI 53190

Phone: (262) 495-3284

FAX: (262) 495-8421


LAND-MARKSURVEYING.COM

**PLAT OF SURVEY**

LOTS 2,3,9,10 AND THE WEST 9 FEET  
OF LOT 1, BLOCK 4, HONEY LAKE SUBDIVISION,  
LOCATED IN SECTION 13, TOWN 3 NORTH,  
RANGE 18 EAST, SPRING PRAIRIE TOWNSHIP,  
WALWORTH COUNTY, WISCONSIN.

OWNERS: WILLIAM R. KIESLER

MARY J. KIESLER  
20 MORNINGSIDE  
CHICAGO, IL. 60185

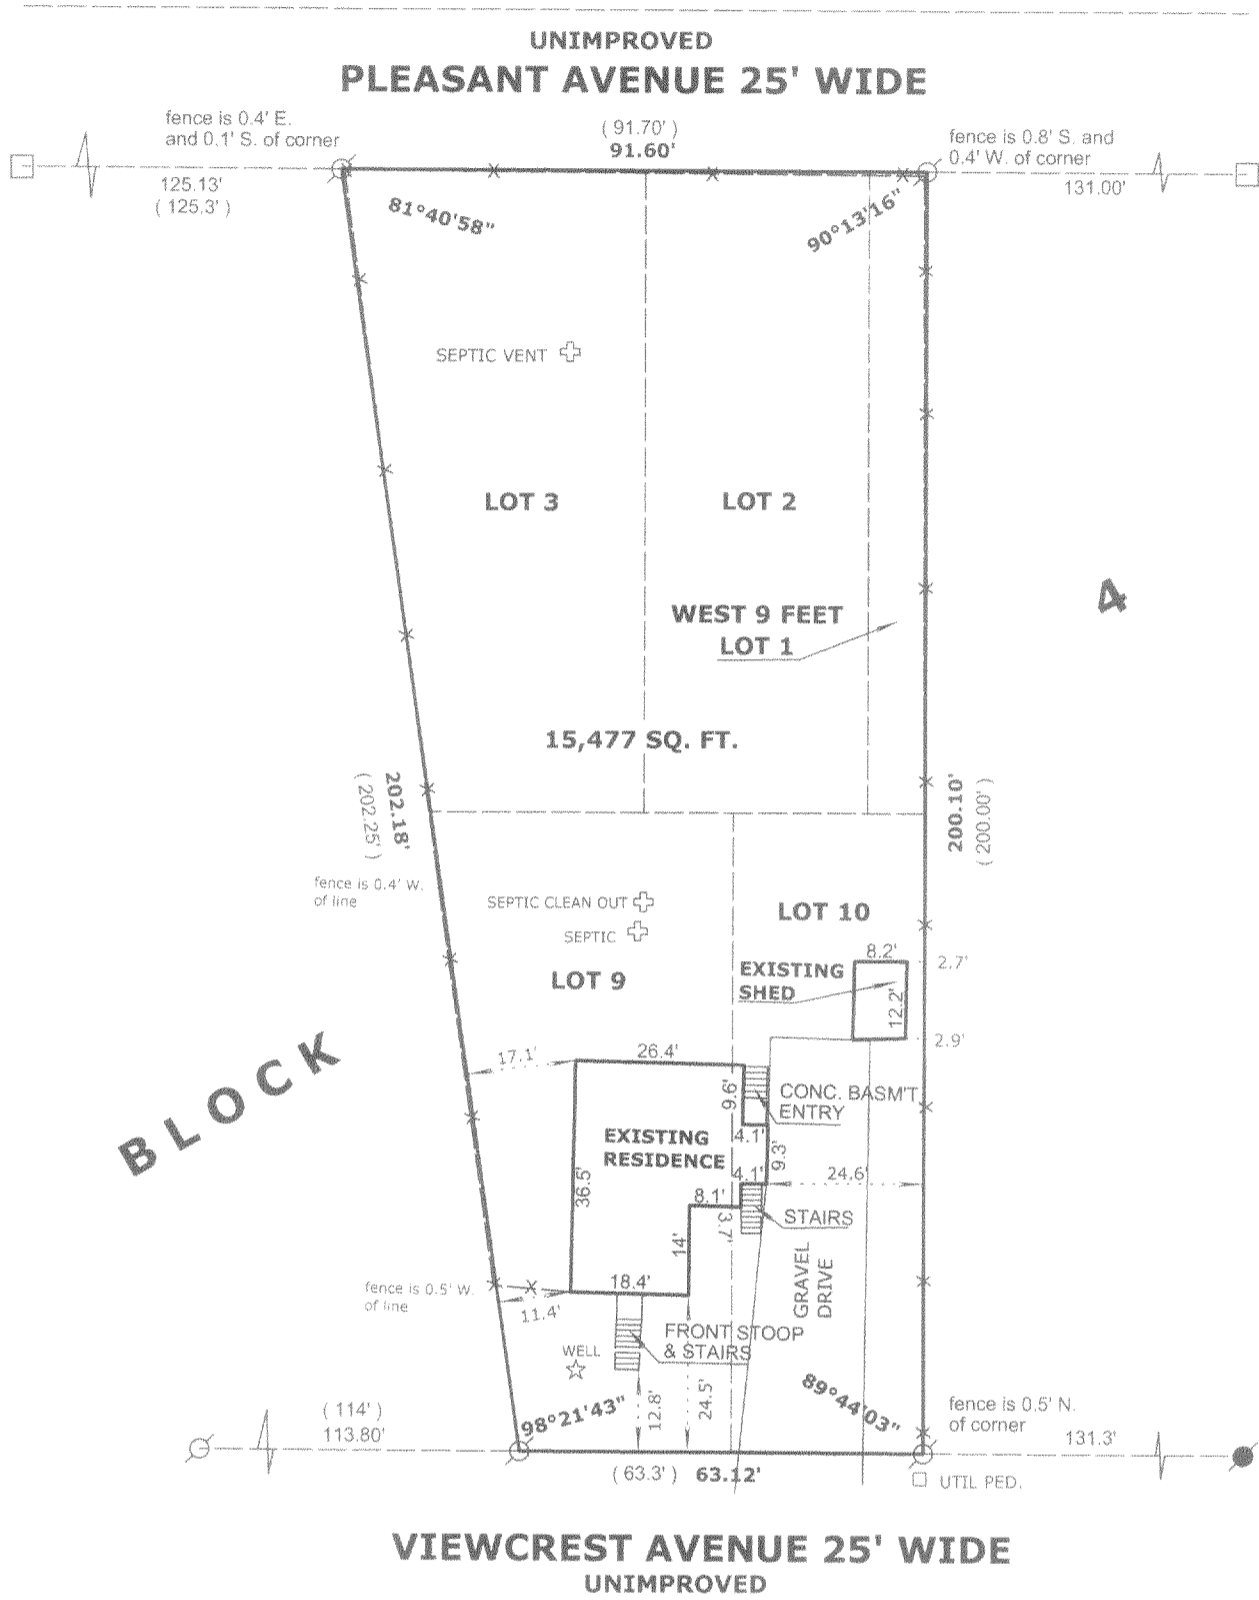

**BLOCK**

**4**

**LEGEND**

- ⊗ FOUND IRON PIPE
- FOUND IRON ROD
- ⊠ FOUND COUNTY MONUMENT
- FOUND CONCRETE MONUMENT
- + CHISEL CUT IN CONCRETE
- SET IRON ROD, 24" LONG, WEIGHING 1.5 LBS./LINEAL FT., 3/4" DIA.
- ( x x ) RECORDED AS DIMENSION
- x - x - EXISTING FENCE

SCALE: 1" = 30 FEET

"I hereby certify that the above described property has been surveyed by me or under my direction and that the above map is a true representation thereof and shows the size and location of the property, its exterior boundaries, the location of all visible structures and dimensions of all principal buildings thereon, boundary fences, apparent easements, roadways and visible encroachments, if any."

"This survey is made for the use of the present owners of the property, and also those who purchase, mortgage, or guarantee the title thereto within one year from date hereof."

*Mark L. Miritz*  
**MARK L. MIRITZ**  
 WISCONSIN REGISTERED  
 LAND SURVEYOR S-2582

DATE: MAR. 31, 2005 JOB NO. 05.317

MAR 31 2005

04L 0620

318-962