
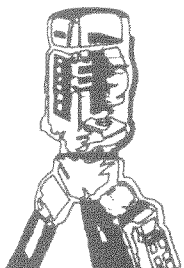


PLAT OF SURVEY
-OF-

SURVEY FOR: JPK BUILDERS, L.L.C.

PROPOSED ADDRESS: _____ C.T.H. "D"

PROPOSED DWELLING WAS STAKED ON ACTUAL CORNERS WITH 15 FOOT CONTROL ON THE NORTH HOUSE LINE. THE CONTRACTOR WILL BE RESPONSIBLE TO FIELD VERIFY ALL STAKES FOR LOCATION AND DIMENSION PRIOR TO CONSTRUCTION. IF ANY DISCREPANCIES OCCUR NOTIFY THIS OFFICE AT ONCE.

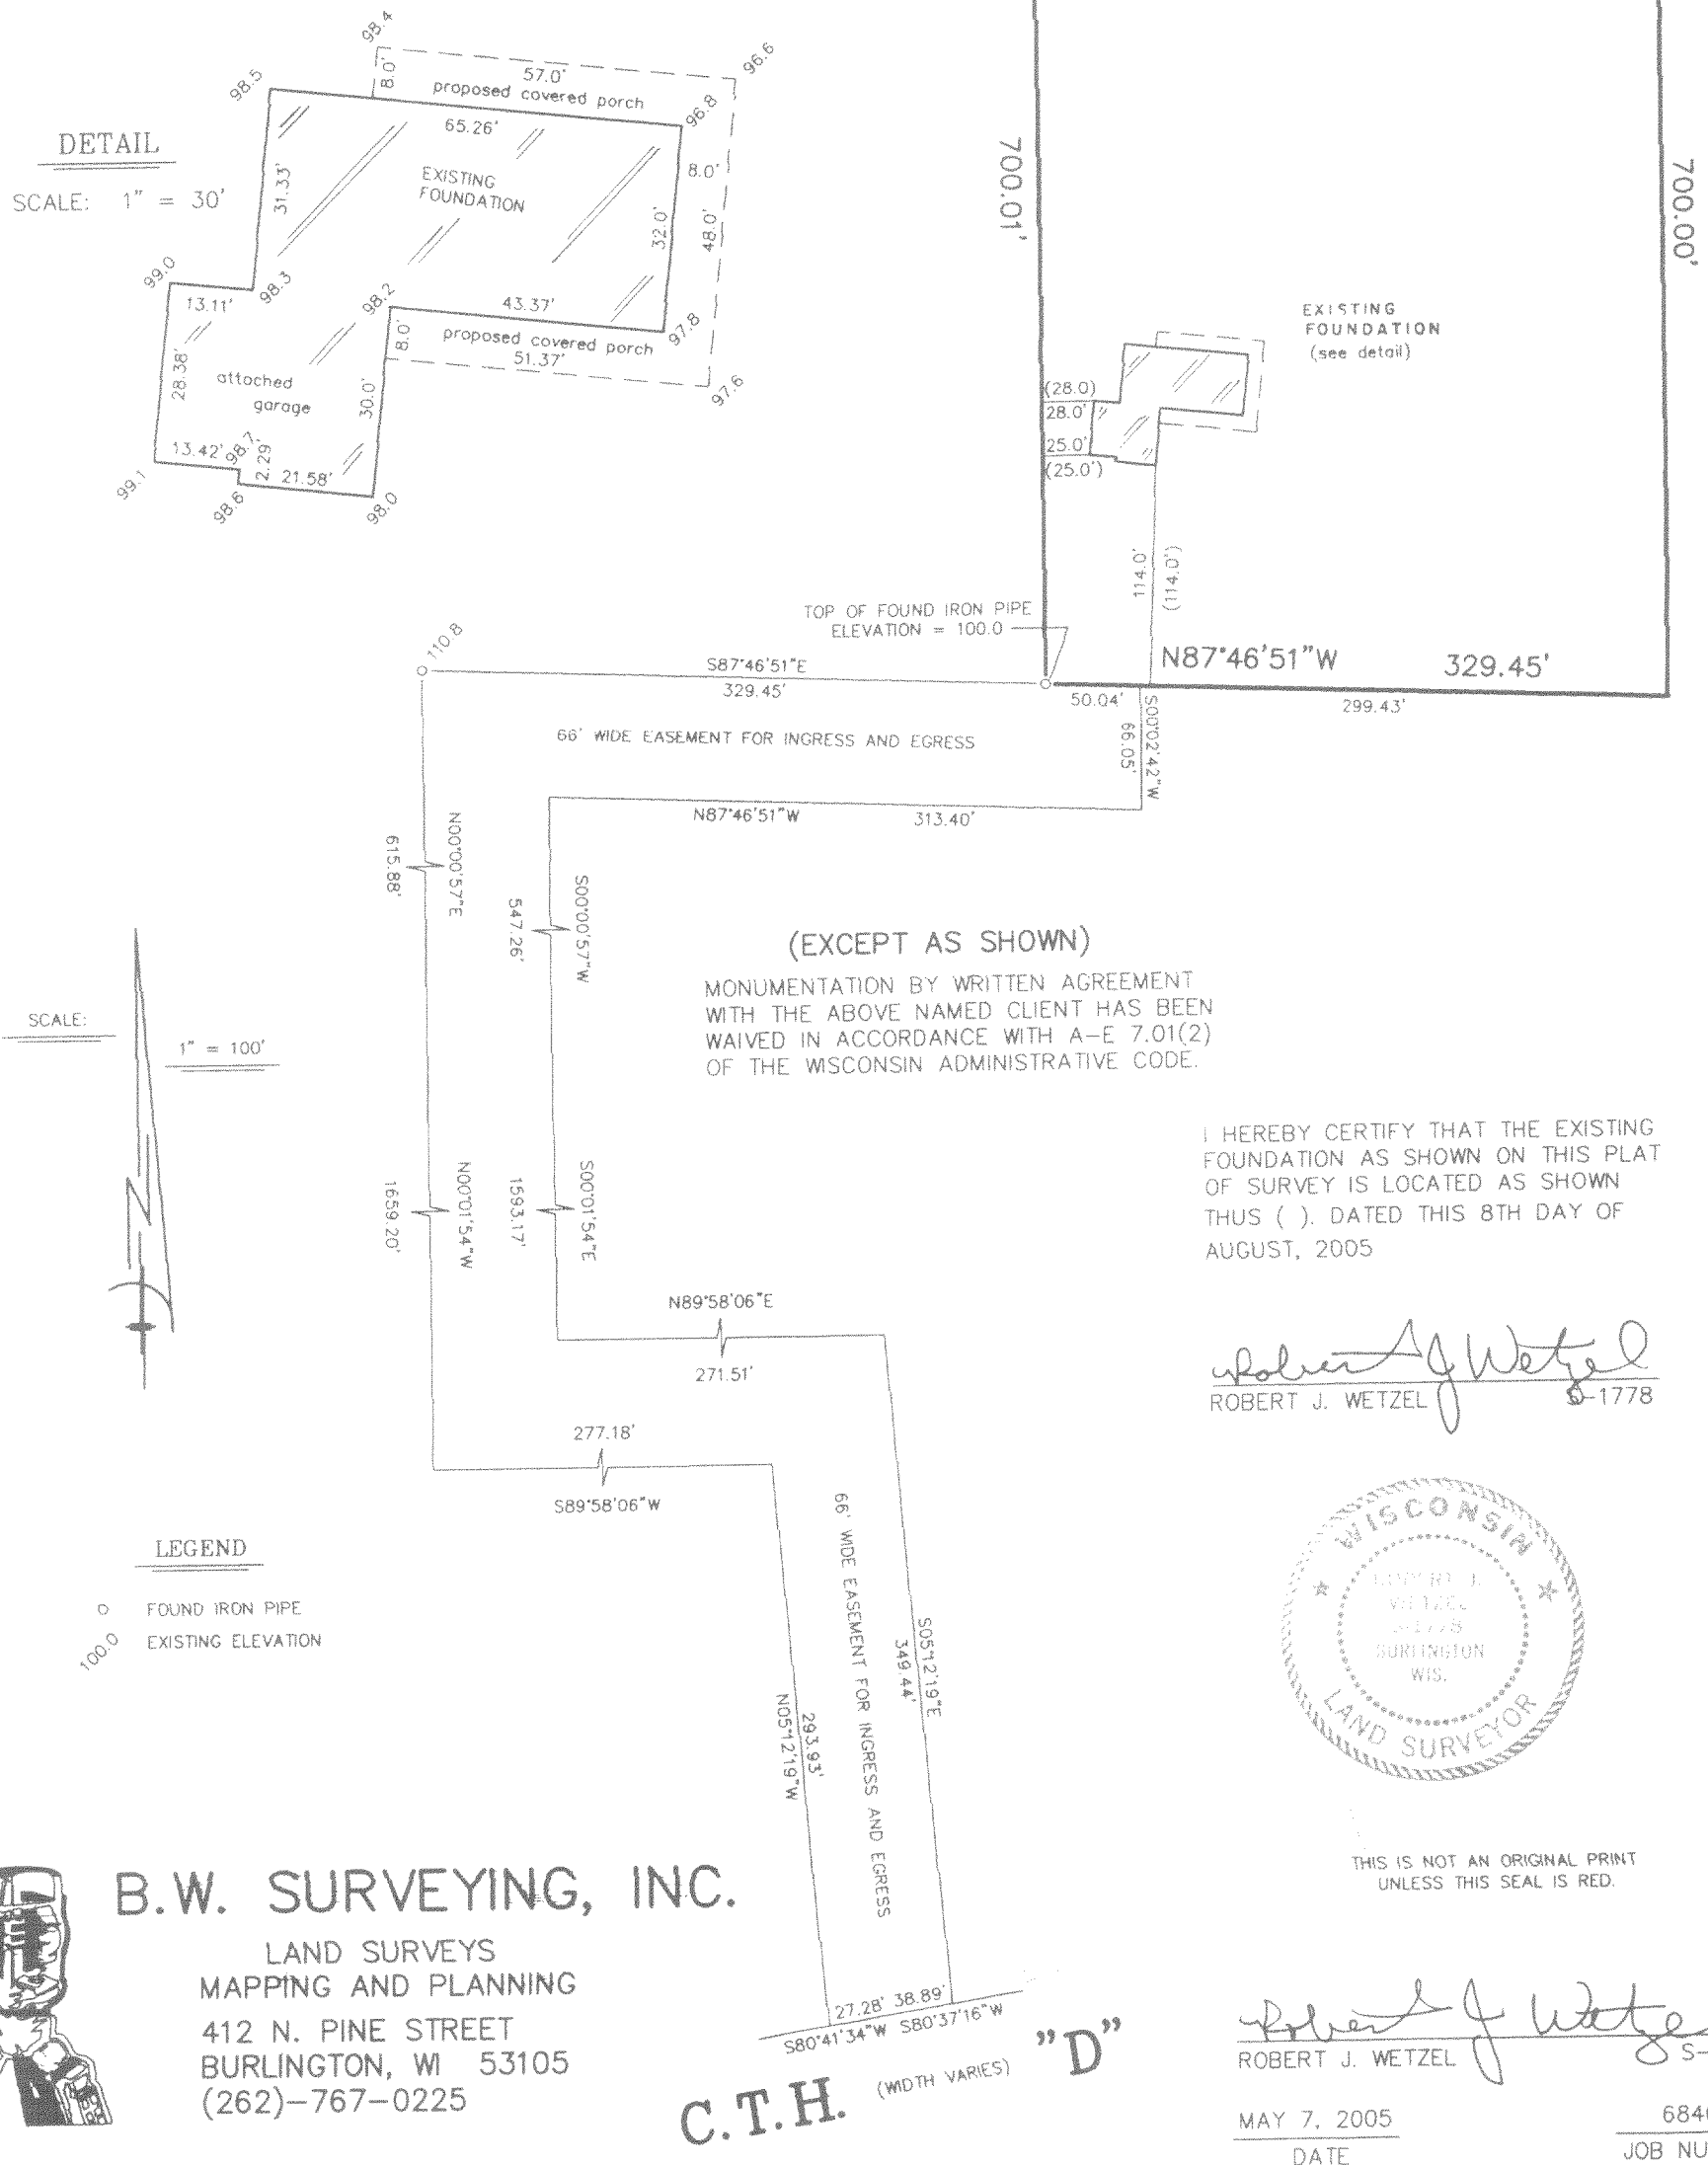

B.W. SURVEYING, INC.

LAND SURVEYS
MAPPING AND PLANNING
412 N. PINE STREET
BURLINGTON, WI 53105
(262)-767-0225

27.26
S80°41'34"W S80°37'16"W
C.T.H. (WIDTH VARIES)

"D"

Robert J. Wetzel
ROBERT J. WETZEL S-1778

MAY 7, 2005
DATE

6840
JOB NUMBER

THIS IS NOT AN ORIGINAL PRINT
UNLESS THIS SEAL IS RED.

BA34630002

318-930