


415-1015

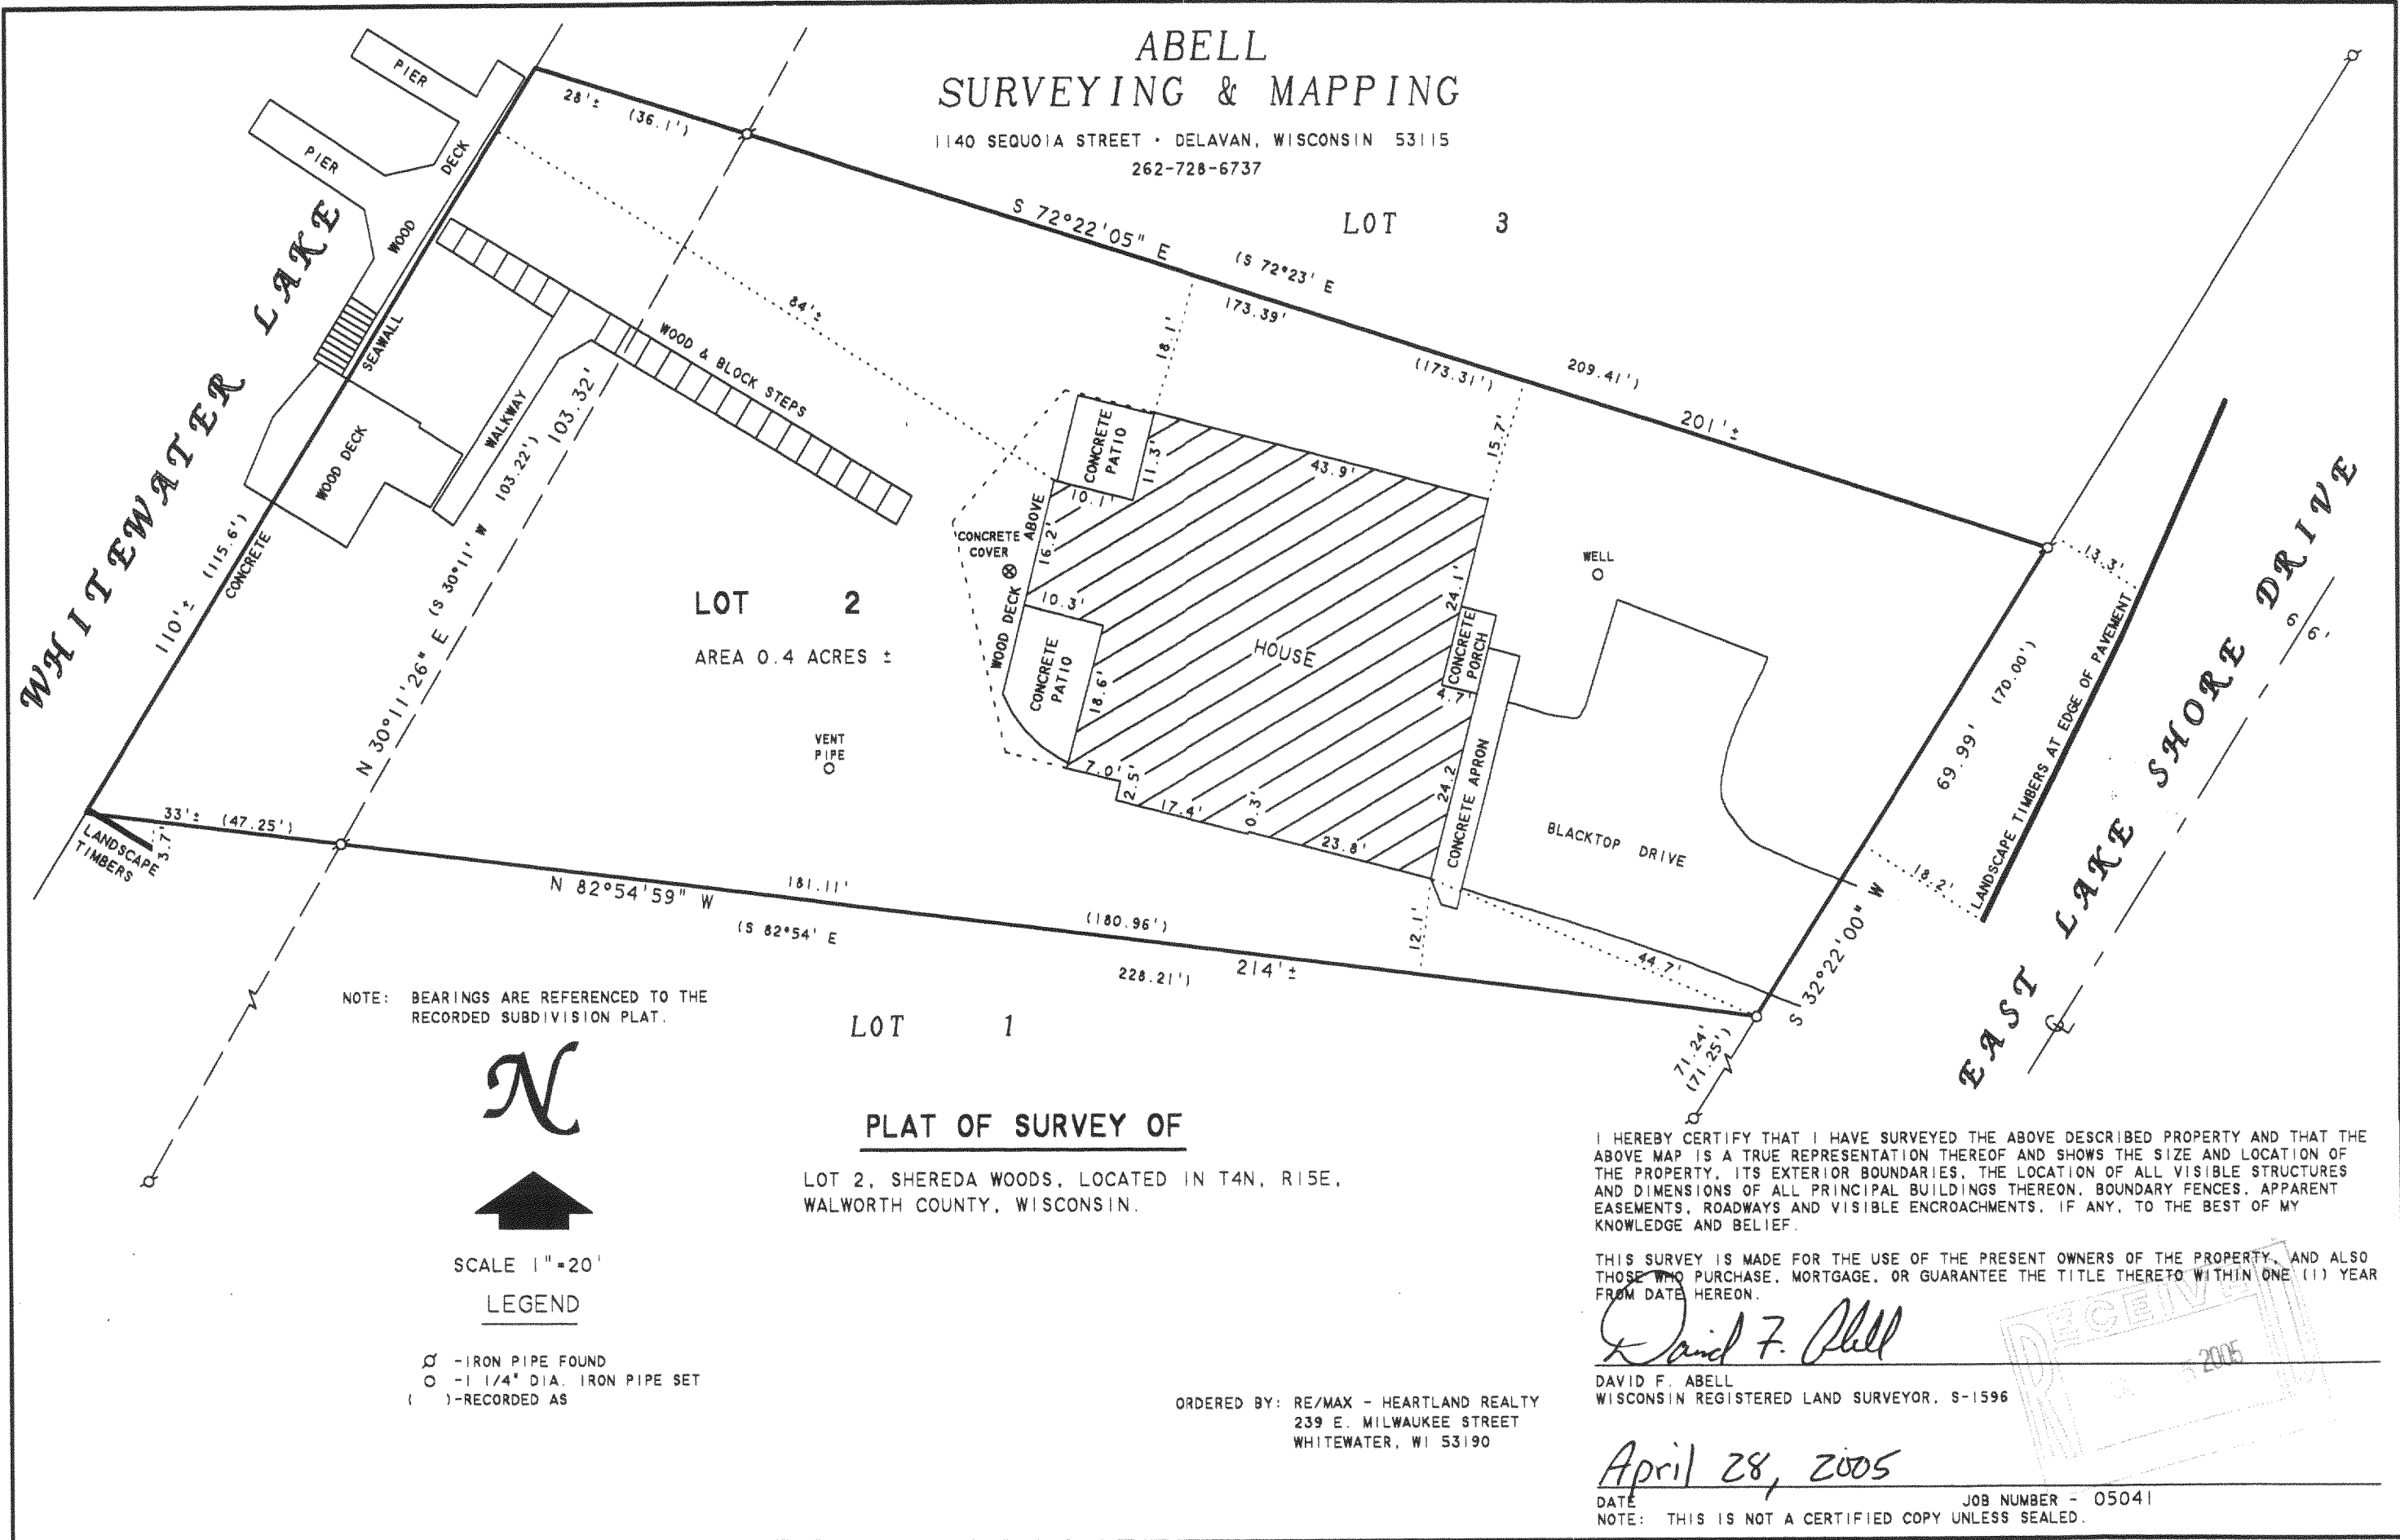

DSP 0002