


PLAT OF SURVEY
LOT 16 OF LORWOOD ACRES, A SUBDIVISION
LOCATED IN PART OF SECTION 35, TOWN 4 NORTH, RANGE 15 EAST,
WALWORTH COUNTY, WISCONSIN

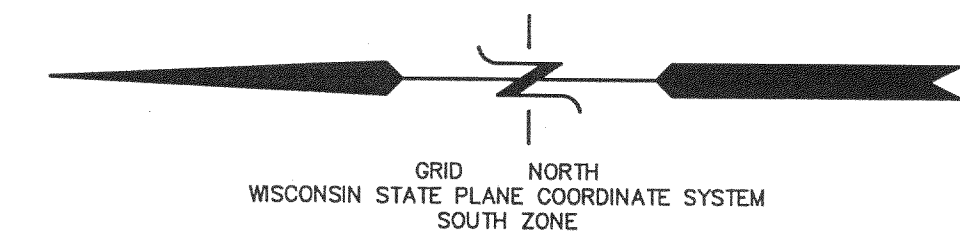

LOT 6

ISLAND DRIVE

UNPLATTED LANDS

EDGE OF PAVEMENT

EAST TOWN ROAD
66' WIDE PUBLIC R.O.W.

GAS VALVE
AND GAS WARNING
POST

UTILITY BOX

EDGE OF PAVEMENT

LORWOOD DRIVE
66' WIDE PRIVATE R.O.W.

N 10°07'18.5" E
C=118.99'
A=120.08'
R=257.00'

N 17°07'15" E
C=48.05'
A=48.14'
R=207.00'

LOT 16
68,531 SQ. FT.

EXISTING RESIDENCE
(UNDER CONSTRUCTION)
FIELD LOCATED 02/09/2008

N 45°55'58" E
C=85.58'
A=85.58'
R=200.00'

118.05'

S 24°22'52" W

118.05'

S 86°11'23" E

140.00'

30'

212.78'

323.36'

S 86°11'23" E

110.60'

165.00'

N 02°11'01" W

178.76'

S 02°11'01" E

118.05'

S 24°22'52" W

118.05'

S 86°11'23" E

140.00'

30'

212.78'

323.36'

S 86°11'23" E

110.60'

165.00'

N 02°11'01" W

178.76'

S 02°11'01" E

118.05'

S 24°22'52" W

118.05'

S 86°11'23" E

140.00'

30'

212.78'

323.36'

S 86°11'23" E

110.60'

165.00'

N 02°11'01" W

178.76'

S 02°11'01" E

118.05'

S 24°22'52" W

118.05'

S 86°11'23" E

140.00'

30'

212.78'