


1140 SEQUOIA STREET • DELAVAN, WISCONSIN 53115
262-728-6737

RECEIVED
JUL 18 2007
SNC

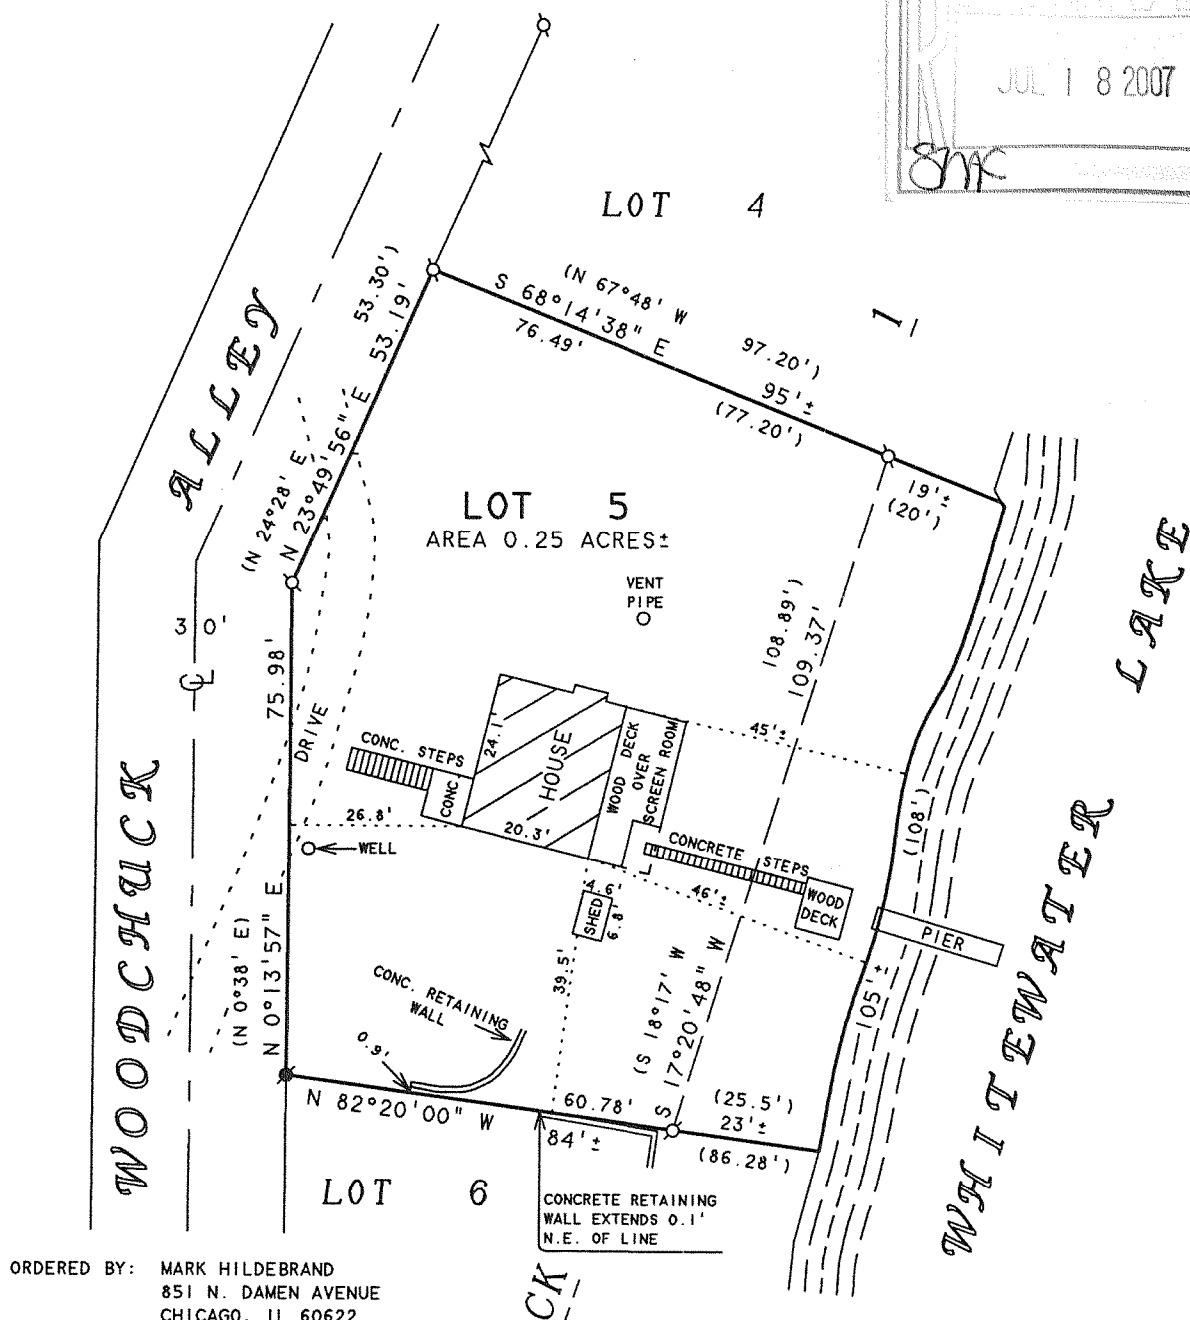

ORDERED BY: MARK HILDEBRAND
851 N. DAMEN AVENUE
CHICAGO, IL 60622

NOTE: BEARINGS ARE REFERENCED TO THE
RECORDED SUBDIVISION PLAT.

LOT 5, BLOCK 1, MORAIN HEIGHTS, LOCATED
IN T4N, R15E, TOWN OF WHITEWATER, WALWORTH
COUNTY, WISCONSIN.



SCALE 1" = 30'

LEGEND

- Ø - IRON PIPE FOUND
 ⦿ - IRON ROD FOUND
 () - RECORDED AS

I HEREBY CERTIFY THAT I HAVE SURVEYED THE ABOVE DESCRIBED PROPERTY AND THAT THE ABOVE MAP IS A TRUE REPRESENTATION THEREOF AND SHOWS THE SIZE AND LOCATION OF THE PROPERTY, ITS EXTERIOR BOUNDARIES, THE LOCATION OF ALL VISIBLE STRUCTURES AND DIMENSIONS OF ALL PRINCIPAL BUILDINGS THEREON, BOUNDARY FENCES, APPARENT EASEMENTS, ROADWAYS AND VISIBLE ENCROACHMENTS, IF ANY, TO THE BEST OF MY KNOWLEDGE AND BELIEF.

THIS SURVEY IS MADE FOR THE USE OF THE PRESENT OWNERS OF THE PROPERTY, AND ALSO THOSE WHO PURCHASE, MORTGAGE, OR GUARANTEE THE TITLE THERETO WITHIN ONE (1) YEAR FROM DATE HEREON.

FROM DATE HEREON:

Donald F. Hall

DAVID F. ABELL
WISCONSIN REGISTERED LAND SURVEYOR, S-1596

June 28, 2007

DATE _____ JOB NUMBER - 94110A
NOTE: THIS IS NOT A CERTIFIED COPY UNLESS SEALED.

DMH-5

415 - 11/6