


RSV
ENGINEERING, INC.
Engineers • Land Surveyors • Environmental Scientists
WOR. 676-30, 616-6600, 69, 616-3540, WI 53103, 1262-1663-1262

DATE: 10/08/2007

DESCRIPTION:
ALL OF LOT 5, BLOCK 1, MORAINE HEIGHTS SUBDIVISION, LOCATED IN THE SOUTHEAST 1/4 OF SECTION 26,
TOWNSHIP 4 NORTH, RANGE 15 EAST, TOWN OF WHITEWATER, WALWORTH COUNTY, WISCONSIN.

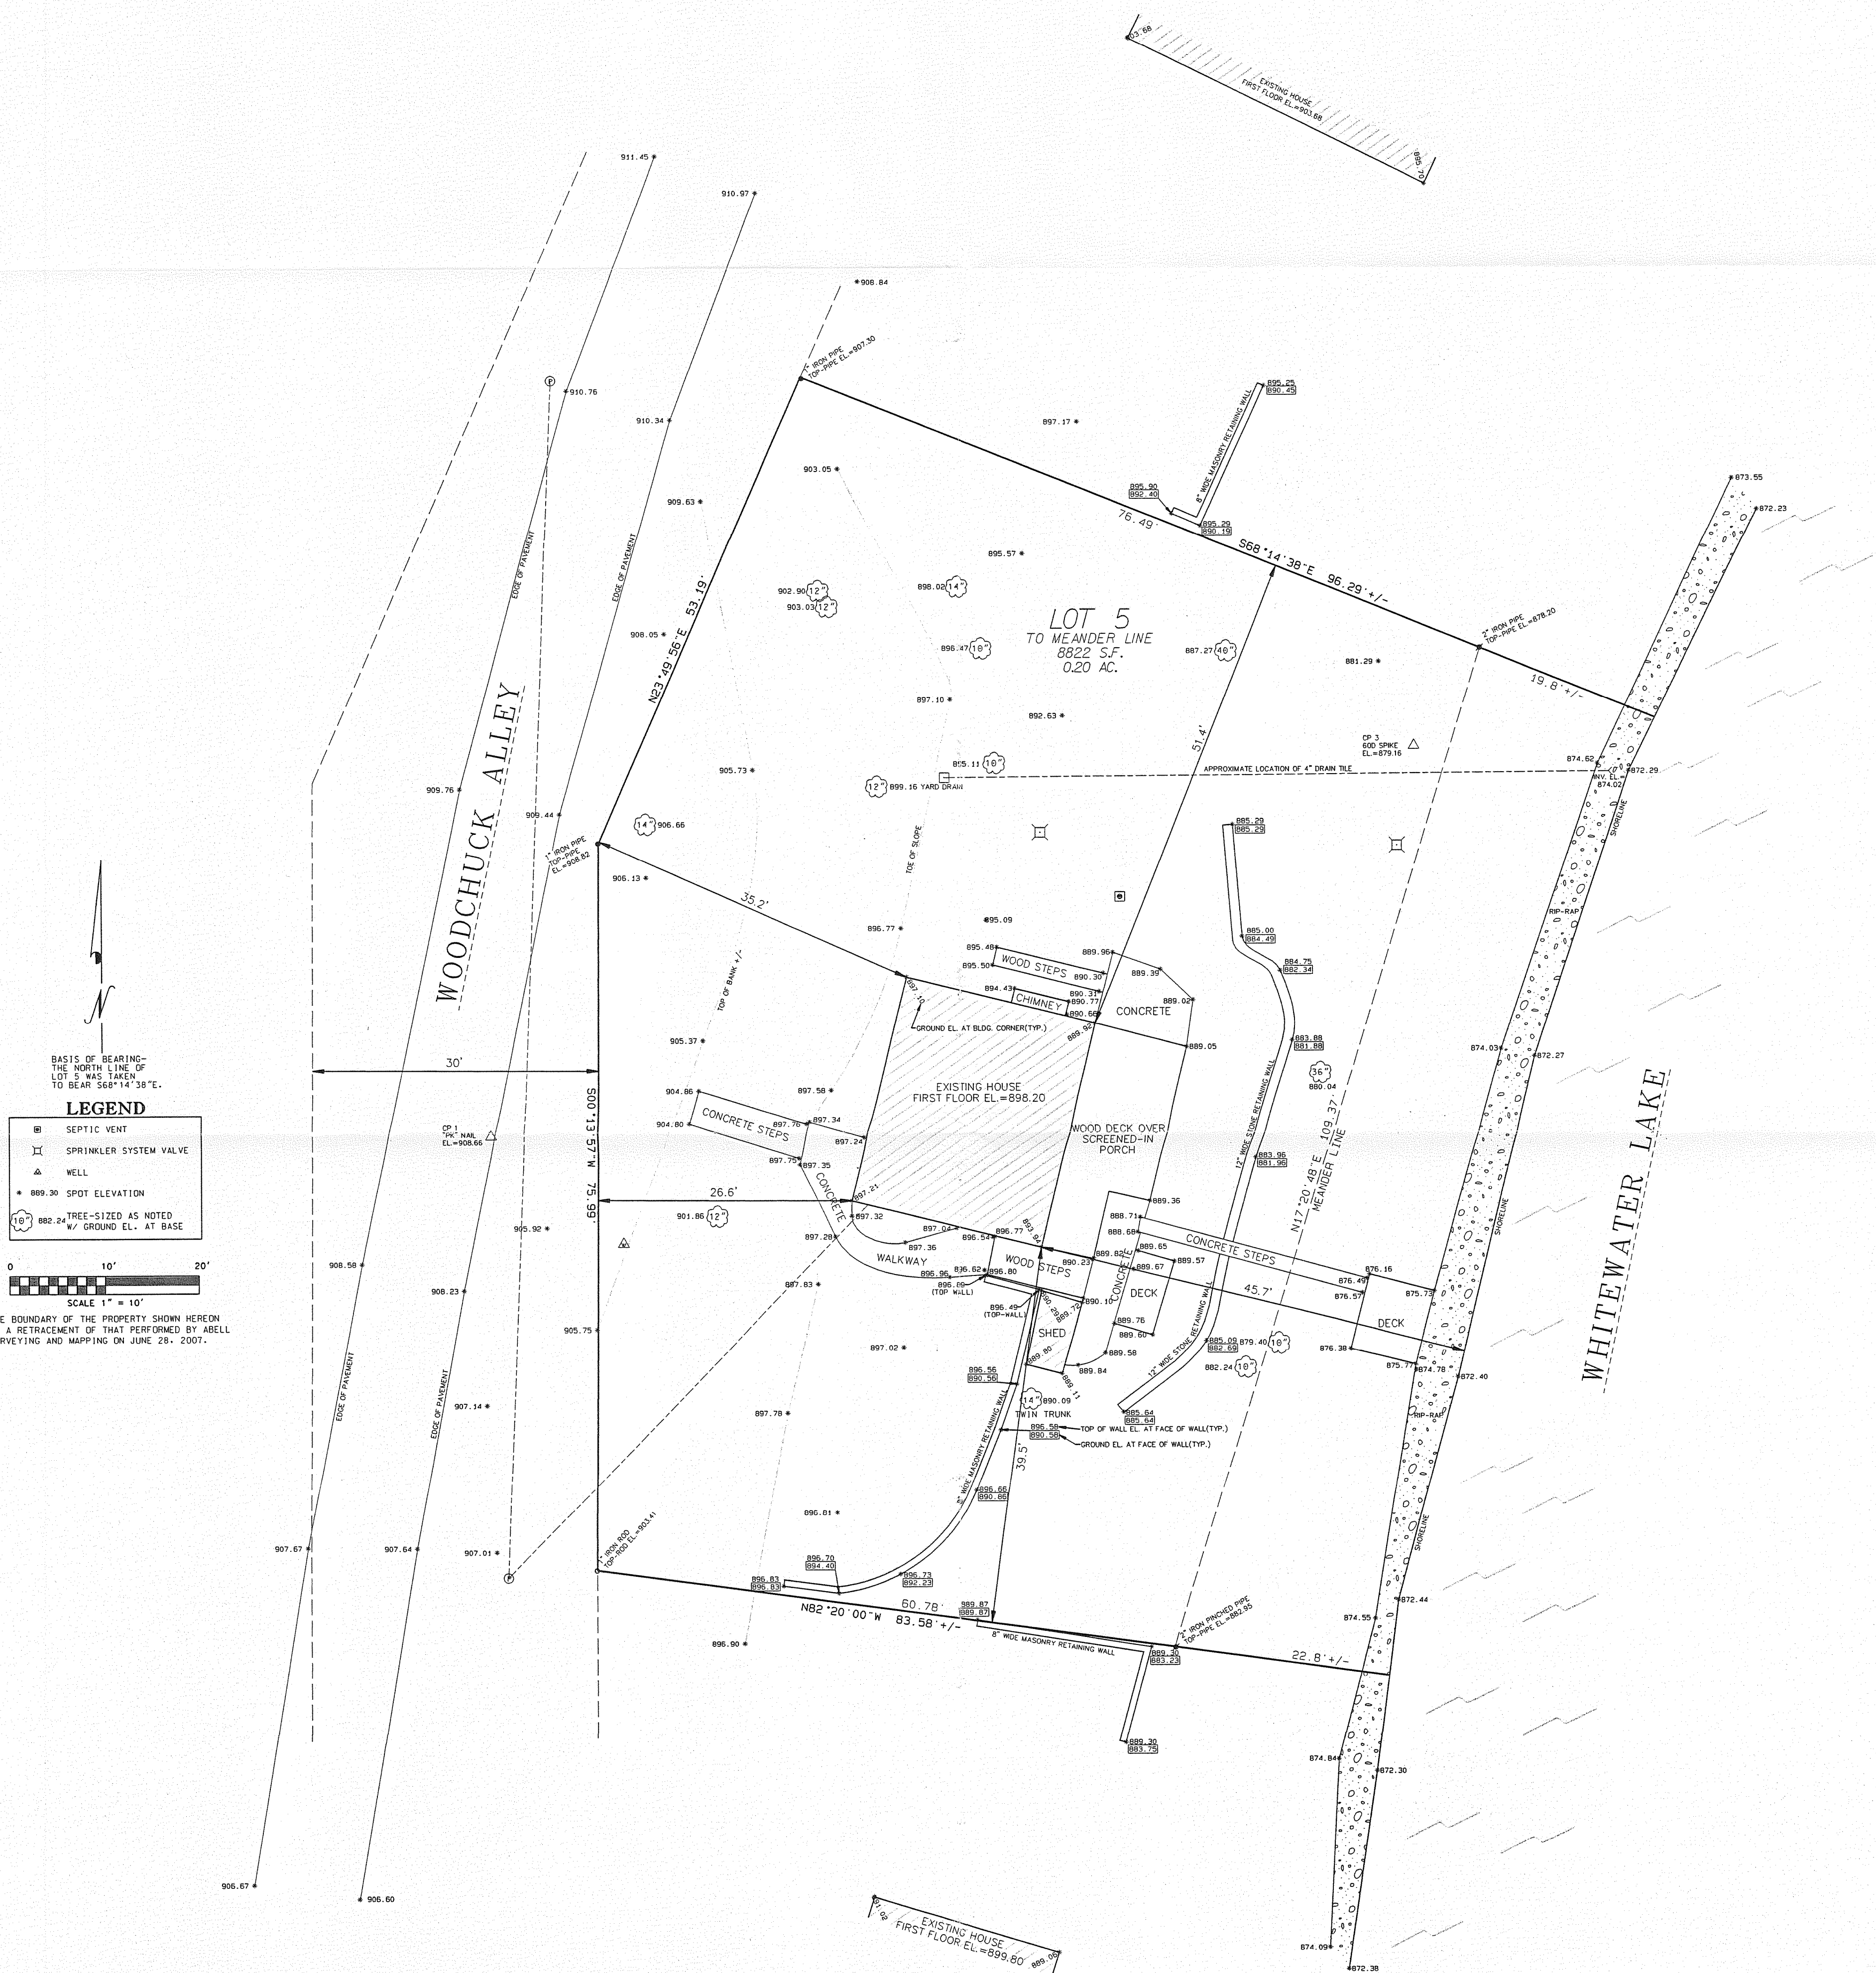

RECEIVED
JAN 29 2008
SNC

I, KENNETH B. MEHRING, R.L.S., # 2838 HEREBY CERTIFY THAT I HAVE SURVEYED THE ABOVE-DESCRIBED PROPERTY AND THE ABOVE MAP IS A TRUE REPRESENTATION THEREOF AND SHOWS THE SIZE AND LOCATION OF THE PROPERTY, ITS EXTERIOR BOUNDARIES, THE LOCATION OF ALL STRUCTURES, FENCES, EASEMENTS, EASEMENTS AND ROADWAYS AND VISIBLE ENCROACHMENTS, IF ANY.

THIS SURVEY IS MADE FOR THE EXCLUSIVE USE OF THE PRESENT OWNERS OF THE PROPERTY, AND ALSO THOSE WHO PURCHASE, MORTGAGE OR INSURE THE TITLE THERETO WITHIN ONE (1) YEAR FROM THE HEREIN AND AS TO THEM I WARRANT THE ACCURACY OF SAID SURVEY MAP.

KENNETH B. MEHRING. R.L.S. # 2838
RSV# 07-134

