

PREPARED FOR
PAM ADAMS
936 RIDGE COURT
EVANSTON IL 60202


PLAT OF SURVEY

-OF-

LOT 16 PINE KNOLL SUBDIVISION, IN THE NORTHEAST 1/4
OF THE NORTHEAST 1/4 OF SECTION 34, TOWN 4 NORTH,
RANGE 15 EAST, TOWN OF WHITEWATER, WALWORTH
COUNTY, WISCONSIN.

KROTT SURVEYING INC.
N3705 WILLOW BEND LANE
LAKE GENEVA WI. 53147
PHONE # (262)248-3697
FAX # (262)249-0639

C.L.
PINE KNOLLS DRIVE
(66' WIDE)

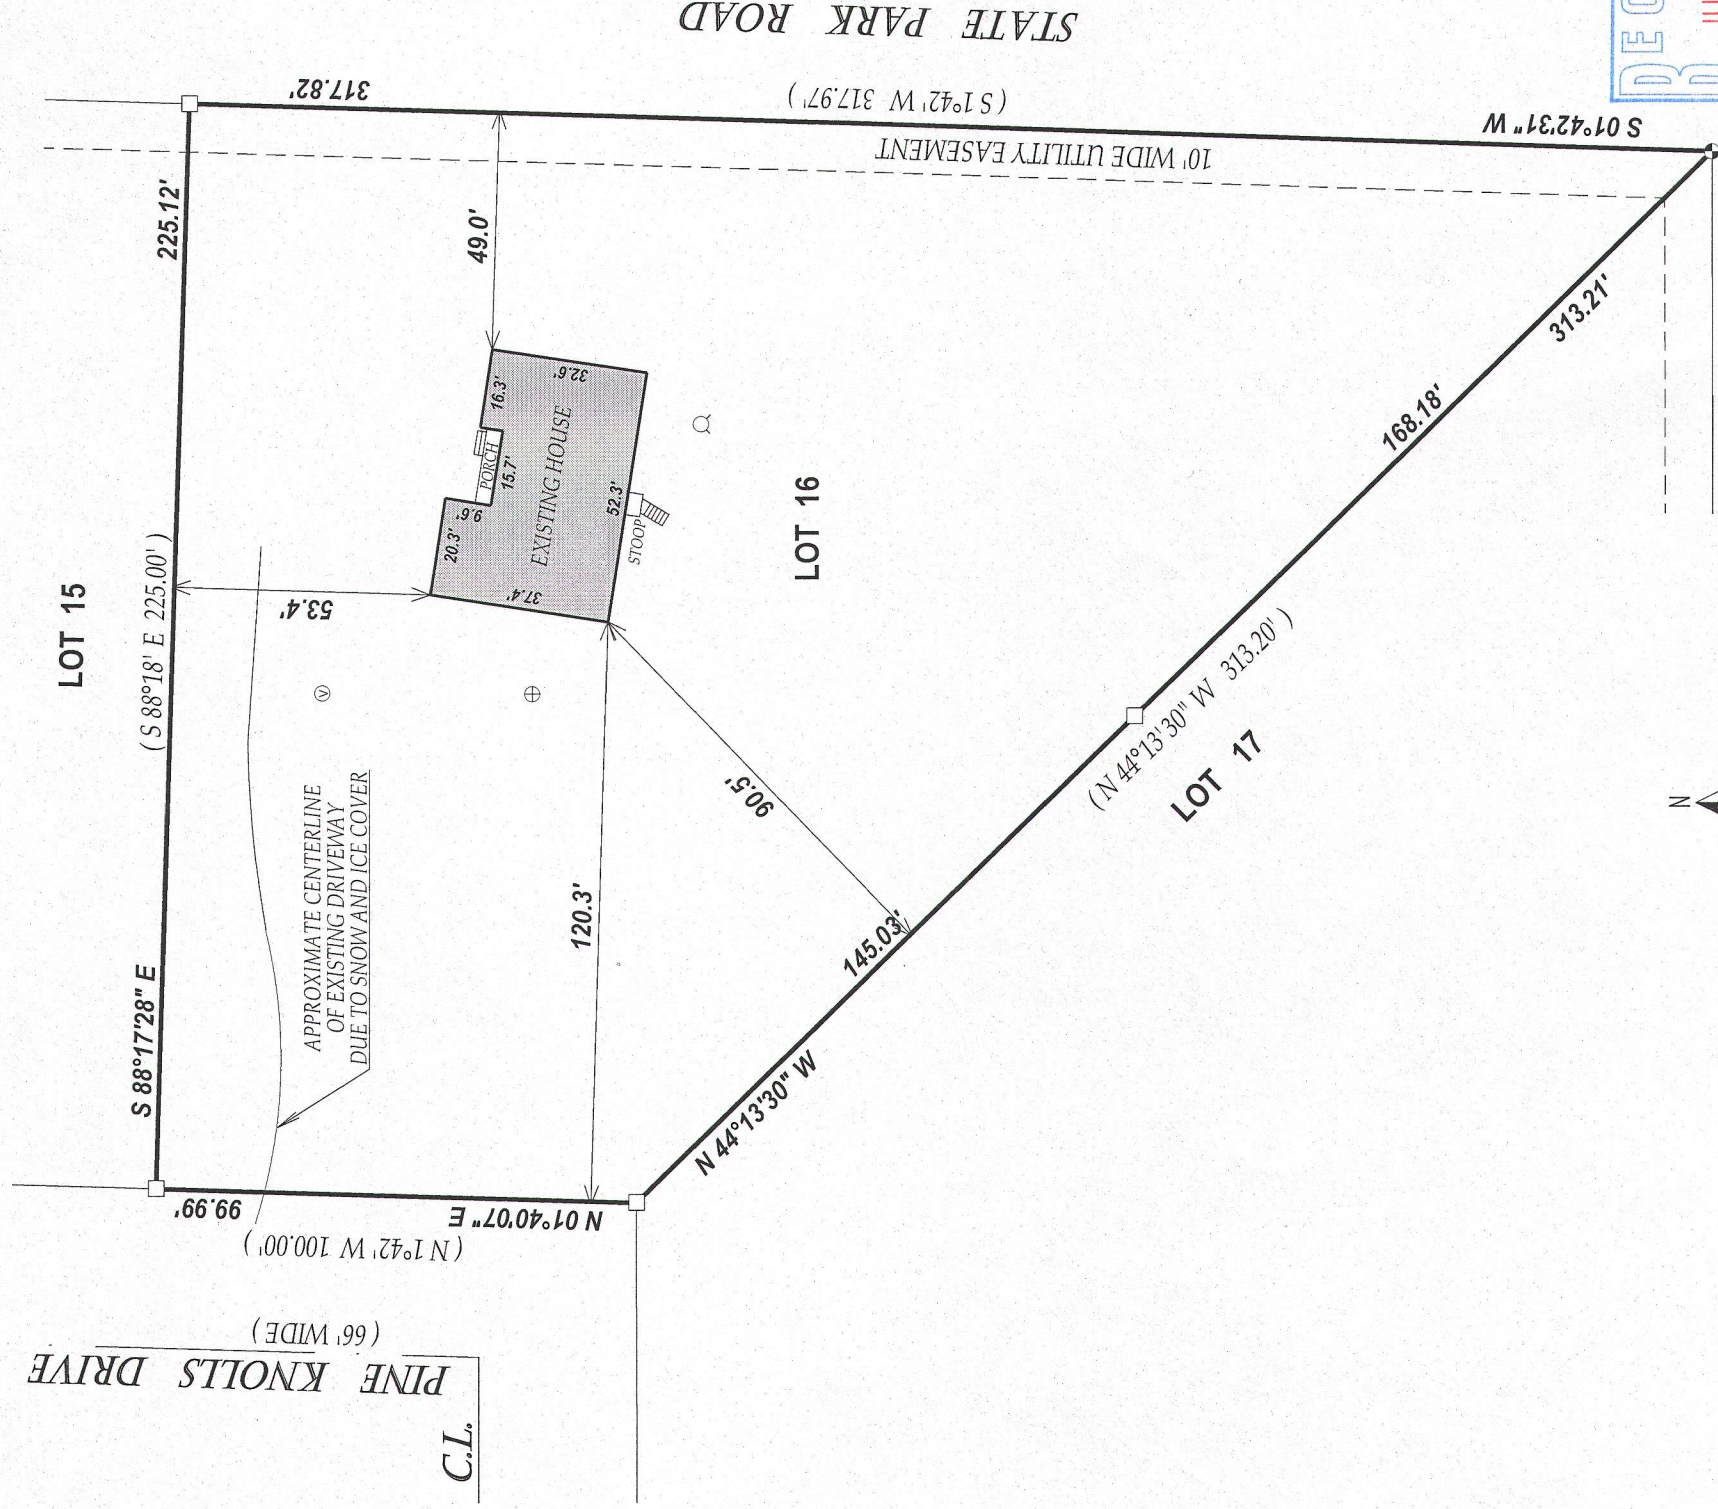



LEGEND

- FOUND IRON BAR
- COUNTY MONUMENT
- WELL
- ⊕ CONCRETE LID
- ⊙ VENT

(XX) RECORDED AS

TAX ID # DPK00016

JOB # 13-034

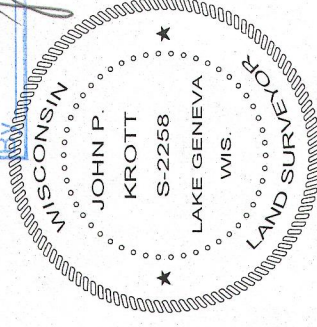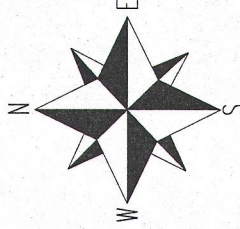

DATED THIS 25th DAY OF MARCH 2013

John P. Krott

JOHN KROTT S - 2258
Wisconsin Registered Land Surveyor
(original if signed in red)

415-1286