

PREPARED FOR
THOMAS PULLEN
KEEFE REAL ESTATE
751 GENEVA PARKWAY
LAKE GENEVA WI. 53147


PLAT OF SURVEY OF

KROTT SURVEYING INC.
(262) 248-3697
N 3705 WILLOW BEND LANE
LAKE GENEVA WI. 53147

LOT 3 OF CERTIFIED SURVEY MAP NO. 1760 ACCORDING TO THE RECORDED PLAT THEREOF
RECORDED IN VOLUME 8 OF CERTIFIED SURVEYS ON PAGE 188 AS DOCUMENT NO. 171289,
LOCATED IN THE NE 1/4 OF SECTION 35, T4N, R15E, TOWN OF WHITEWATER, WALWORTH
COUNTY, WISCONSIN.

C.L. EAST LAKE SHORE DRIVE
(66' WIDE)

C.L. EAST LAKE SHORE DRIVE
(66' WIDE)

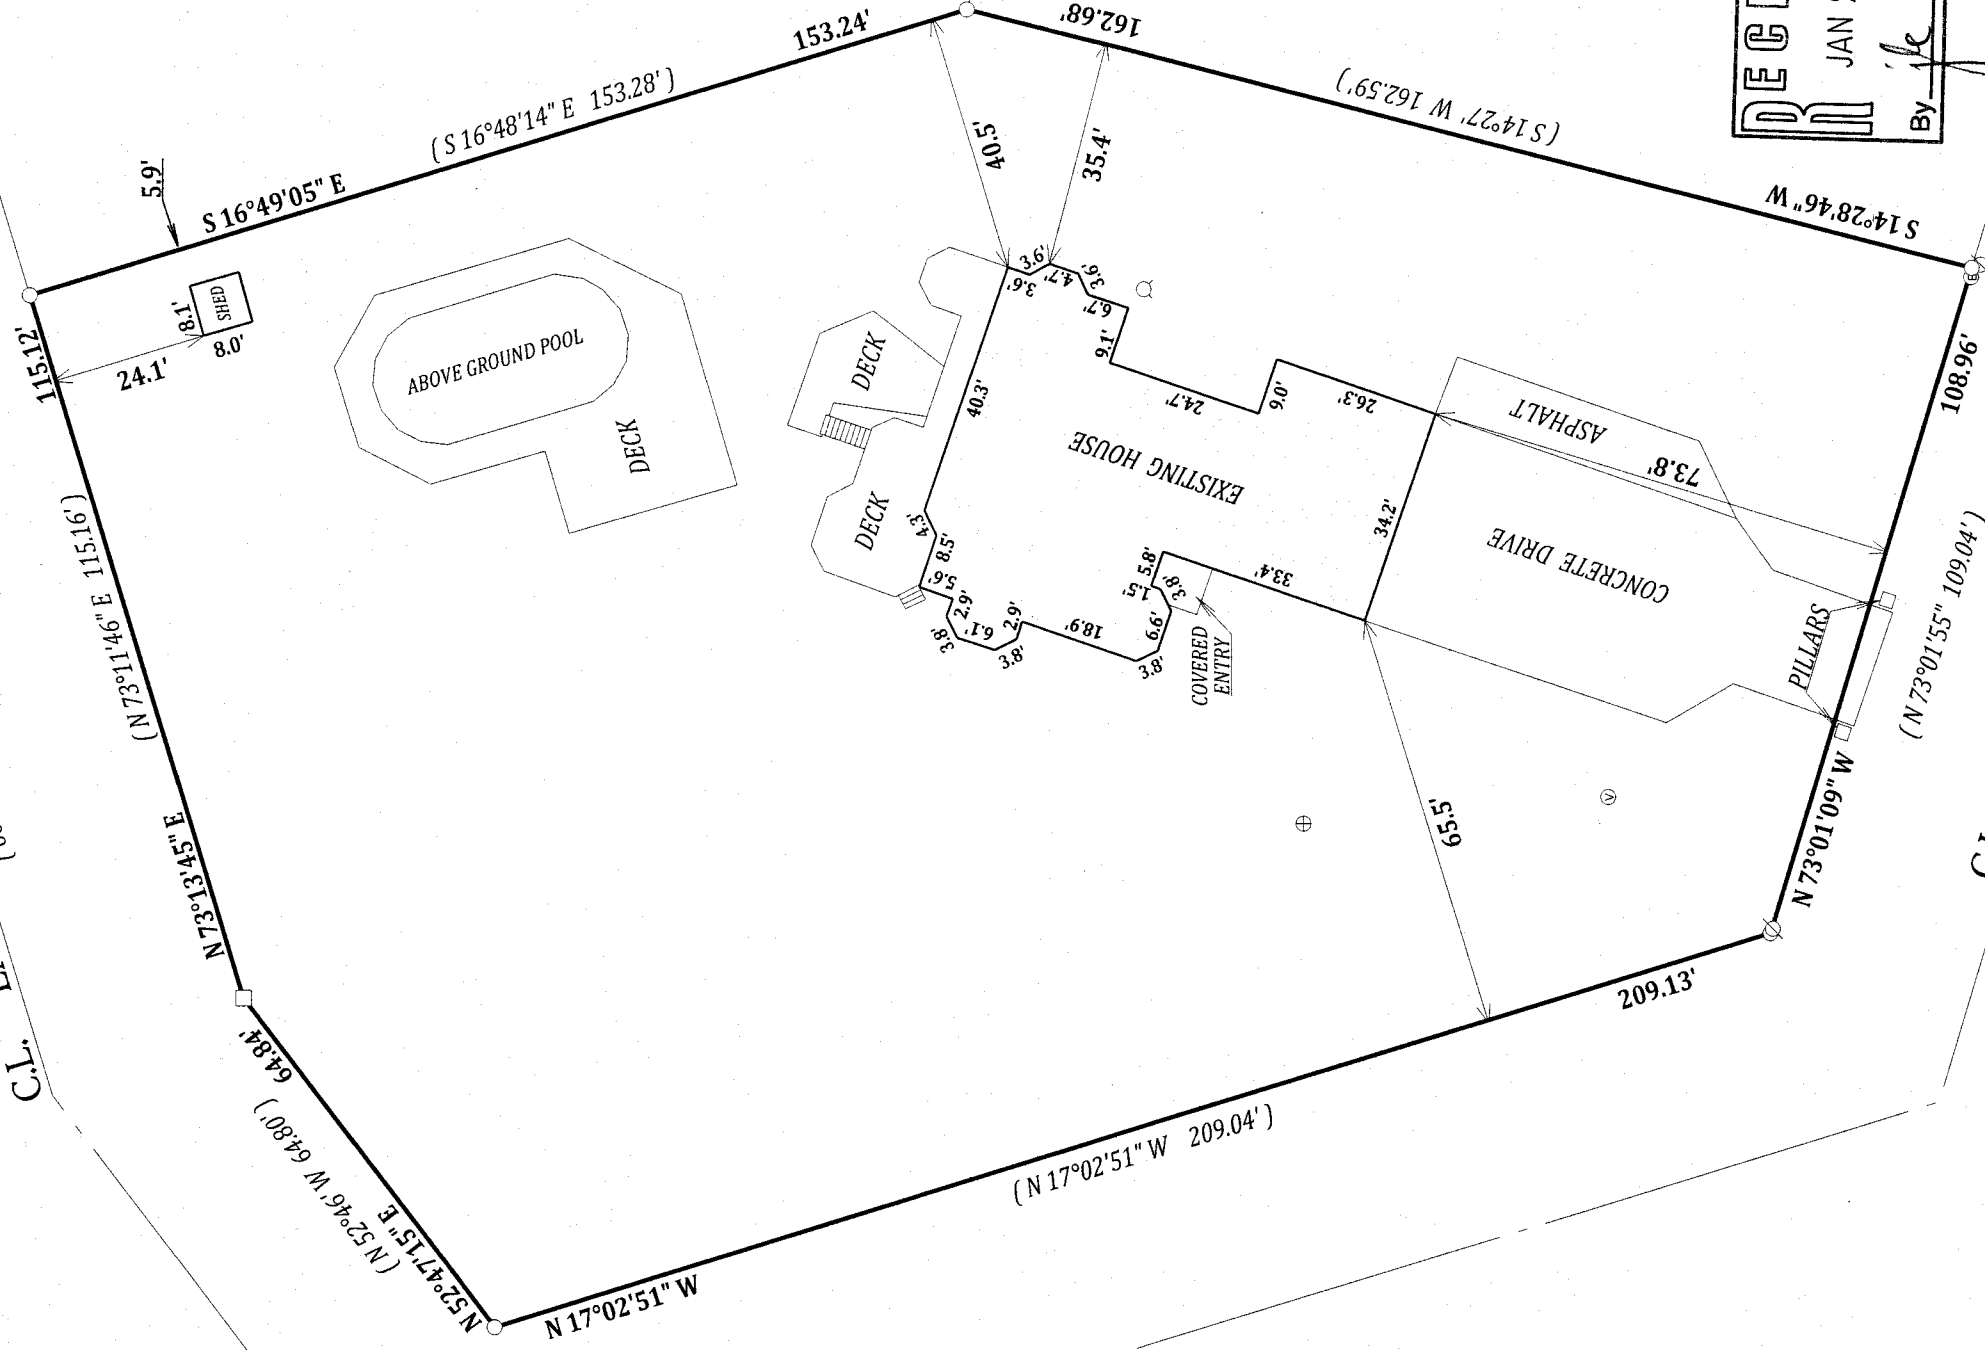

LEGEND

- FOUND PIPE
- FOUND IRON BAR
- ⊕ CONCRETE ACCESS COVER
- ⊙ VENT
- ⊙ WELL
- ⊙ UTILITY POLE
- E — OVER HEAD WIRES
- ⊙ ELECTRICAL PEDESTAL
- (XX) RECORDED AS

SCALE 1" = 30'


NOTE: BEARINGS ARE REFERENCED TO C.S.M. NO. 1760.

I have surveyed the above-described property and the above map is a true representation thereof and shows the size and location of the property, its exterior boundaries, the location and dimensions of all structures thereon, fences apparent easements and roadways and visible encroachments, if any.

This survey is made for the exclusive use of the present owners of the property, and also those who purchase, mortgage, or insure the title thereto within one (1) year from date hereof; and as to them I warrant the accuracy of said survey map.

TAX ID # DA176000003
JOB # 13-174

RECEIVED
JAN 21 2014
By *John P. Krott*

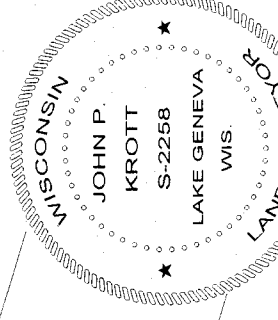

DATED THIS 18th DAY OF NOVEMBER 2013

John P. Krott

JOHN P. KROTT S-2258
WISCONSIN REGISTERED LAND SURVEYOR
(NOTE: THIS IS NOT A CERTIFIED COPY
UNLESS SIGNED IN RED INK)

415-1308
dA1760-3