

TYLER MEYER
SHOREWEST REALTY
DELAVER, WI

PLAT OF SURVEY



- OF -

PATHINDER SURVEYING INC.
(formerly)
J.K. SURVEYING, INC.
P.O. BOX 322
LAKE GENEVA, WI. 53147
WWW.PATHINDERSURVEYING.NET
262-248-8303


LOT 50 SCATTERED OAKS SUBDIVISION, LOCATED IN THE SW 1/4 OF SECTION 36 AND THE SE 1/4 OF SECTION 35, TOWN 4 NORTH, RANGE 15 EAST OF THE FOURTH PRINCIPAL MERIDIAN, TOWN OF WHITEWATER, WALWORTH COUNTY, WISCONSIN.

HACKETT ROAD

(platted as 66' wide)
(S 88°31'W 200.05')

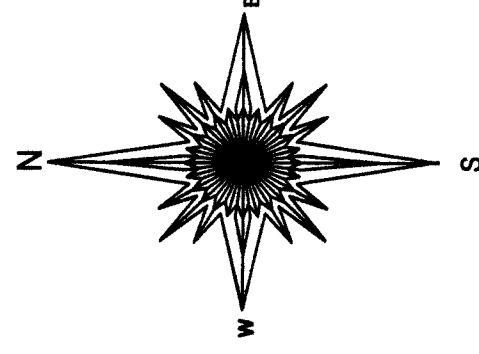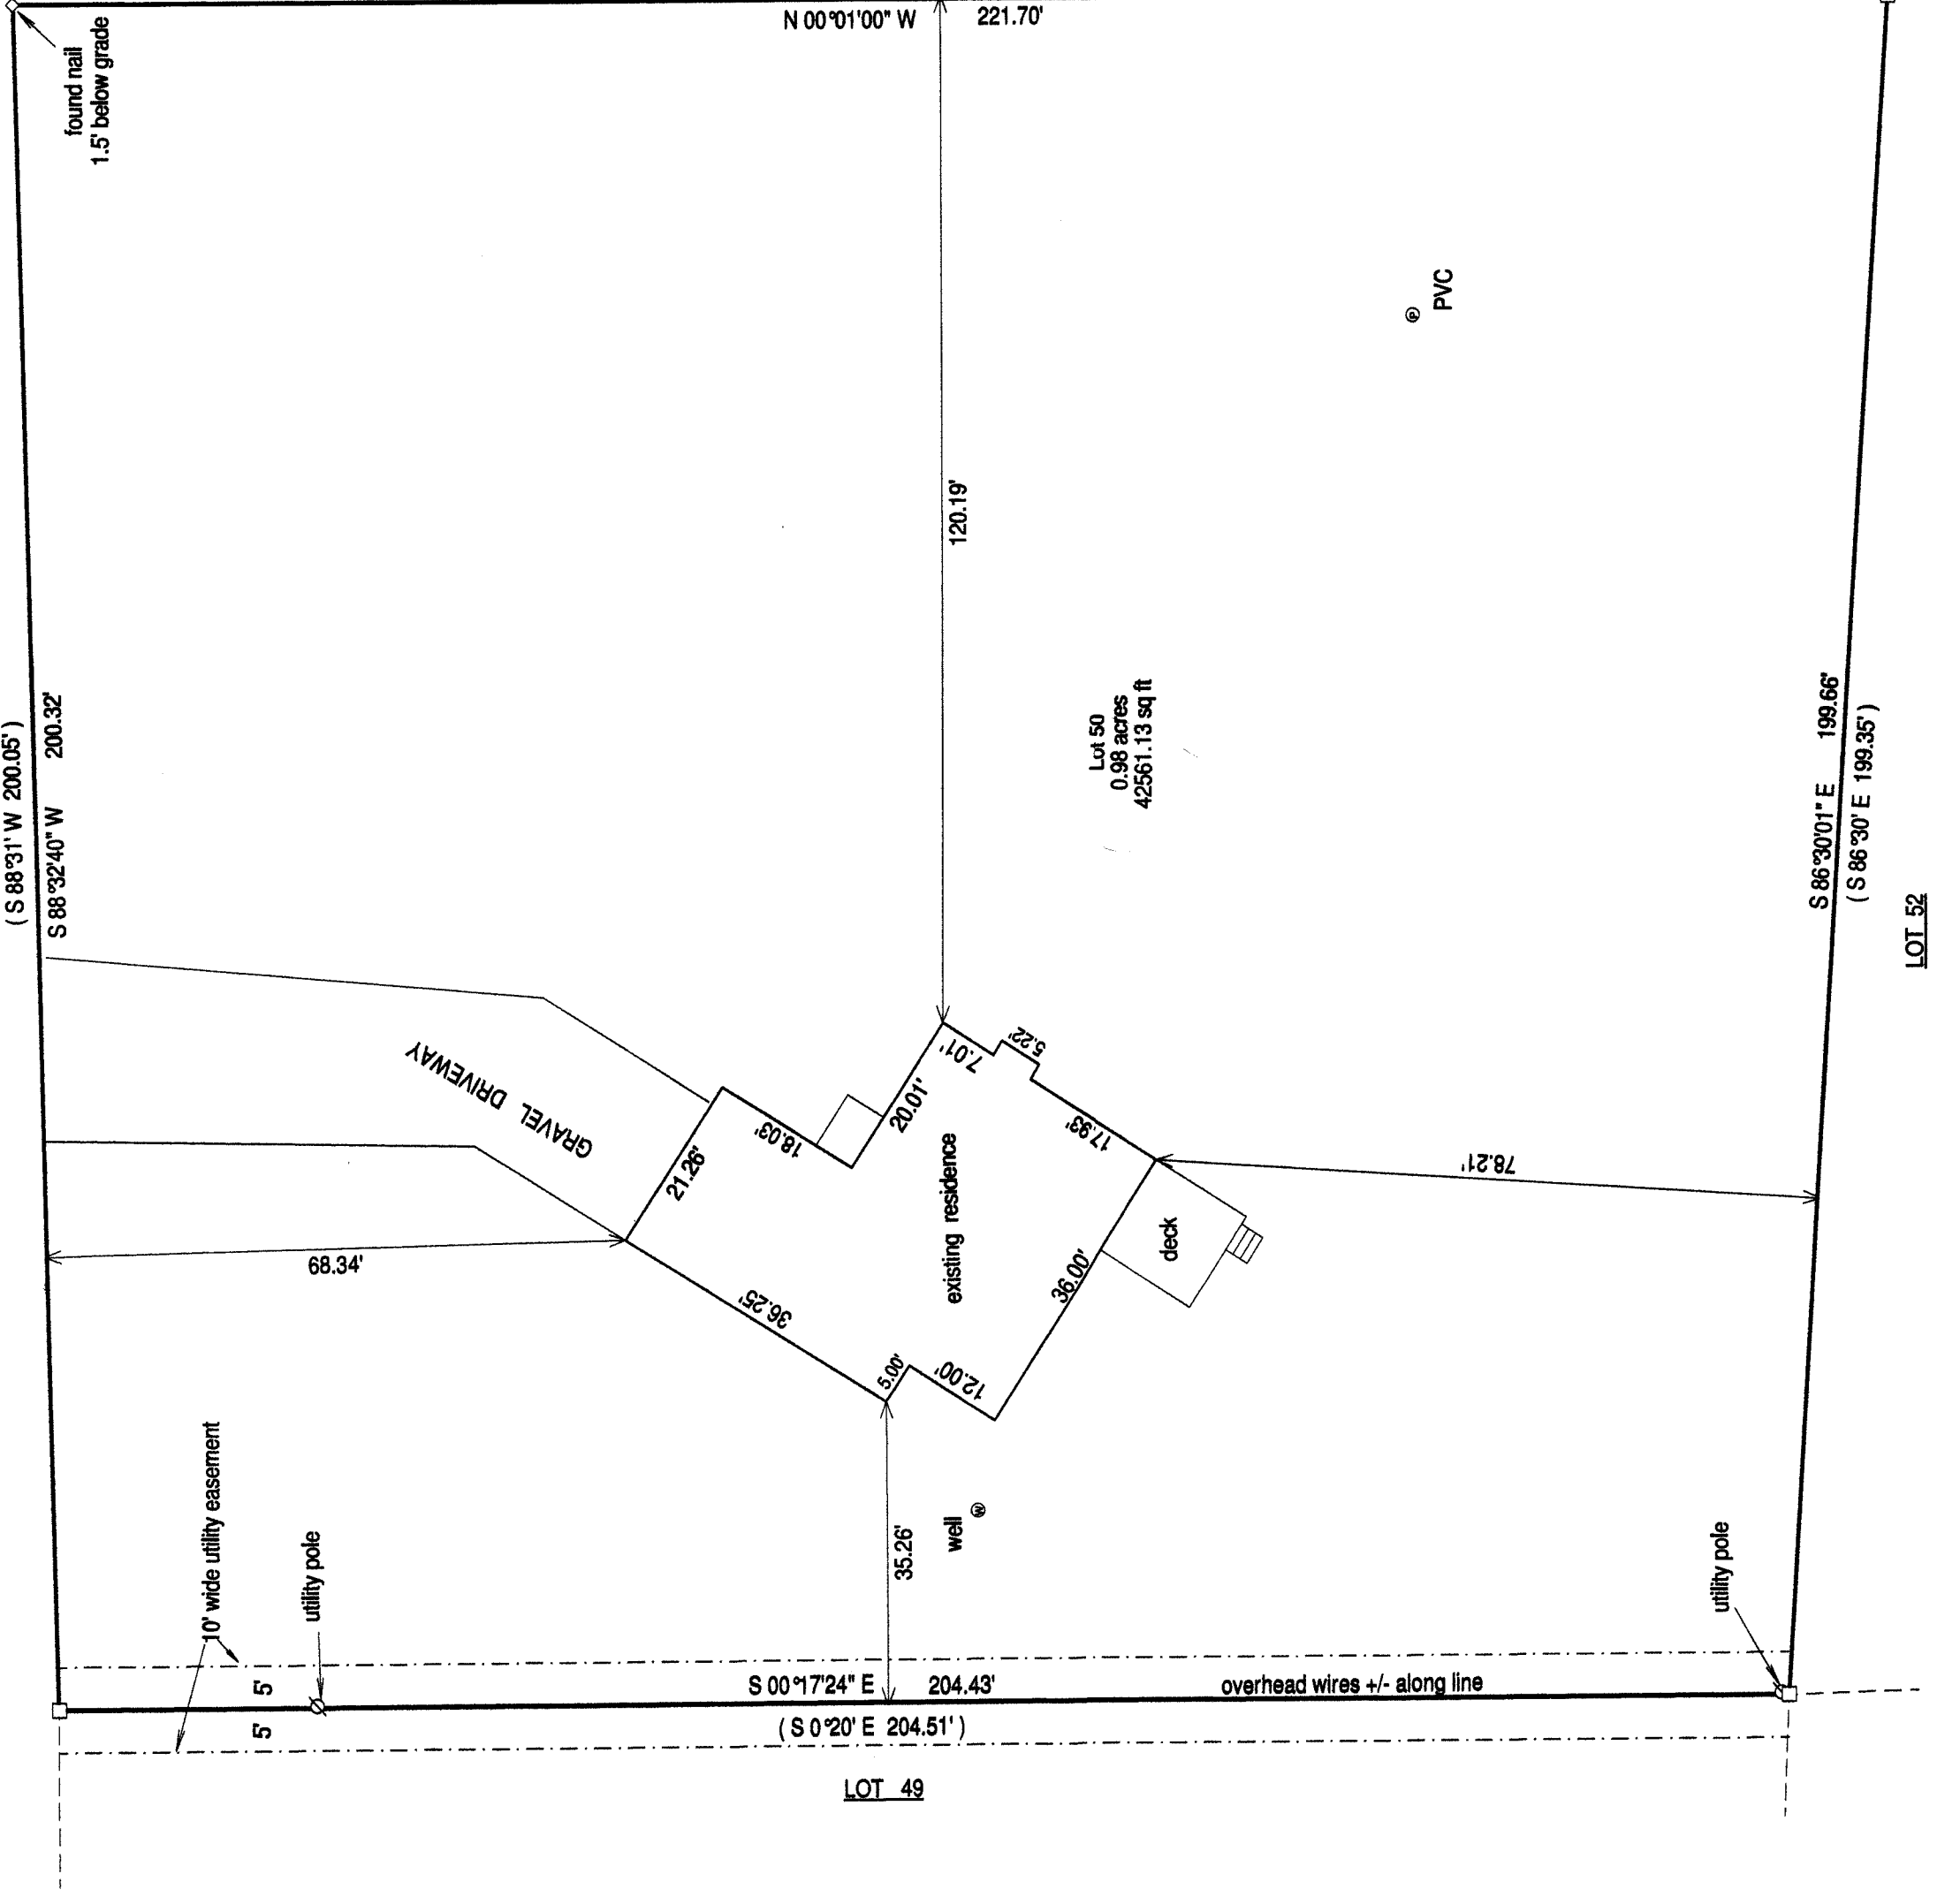

NOTE: DUE TO HEAVY SNOW COVER
ALL IMPROVEMENTS MAY NOT
BE SHOWN.

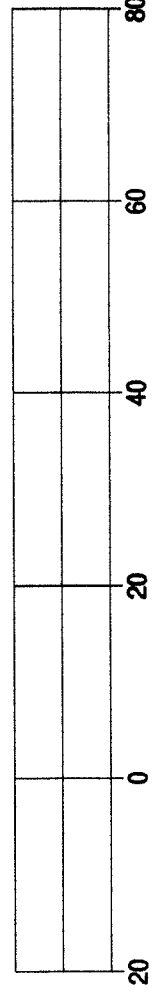

BASIS OF BEARING OF THIS PLAT: THE WEST LINE OF C.T.H. "P" WAS
ASSUMED TO BEAR N 0°01' W AS SHOWN ON THE RECORD PLAT
OF SCATTERED OAKS.

I hereby certify that I have surveyed the above-described property and the above map is a true representation thereof and shows the size and location of the property, its exterior boundaries, the location and dimensions of all structures thereon, fences, apparent easements and roadways and visible encroachments, if any.

This survey is made for the present owners of the property, and those who purchase, mortgage, or guarantee the title thereto, within one year from the date hereof.


DATED THIS 10TH DAY OF JANUARY, 2014.

- () = recorded as
- = found iron bar
- = found iron pipe
- = set iron pipe
- = set iron bar

SCALE 1" = 20'

JOB # 14-05

TAX ID # DSO00050

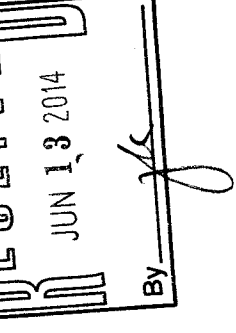

JEFFREY KIMPS S-2436
Wisconsin Registered Land Surveyor
(original if signed in red)

d80 -50

415-1321